
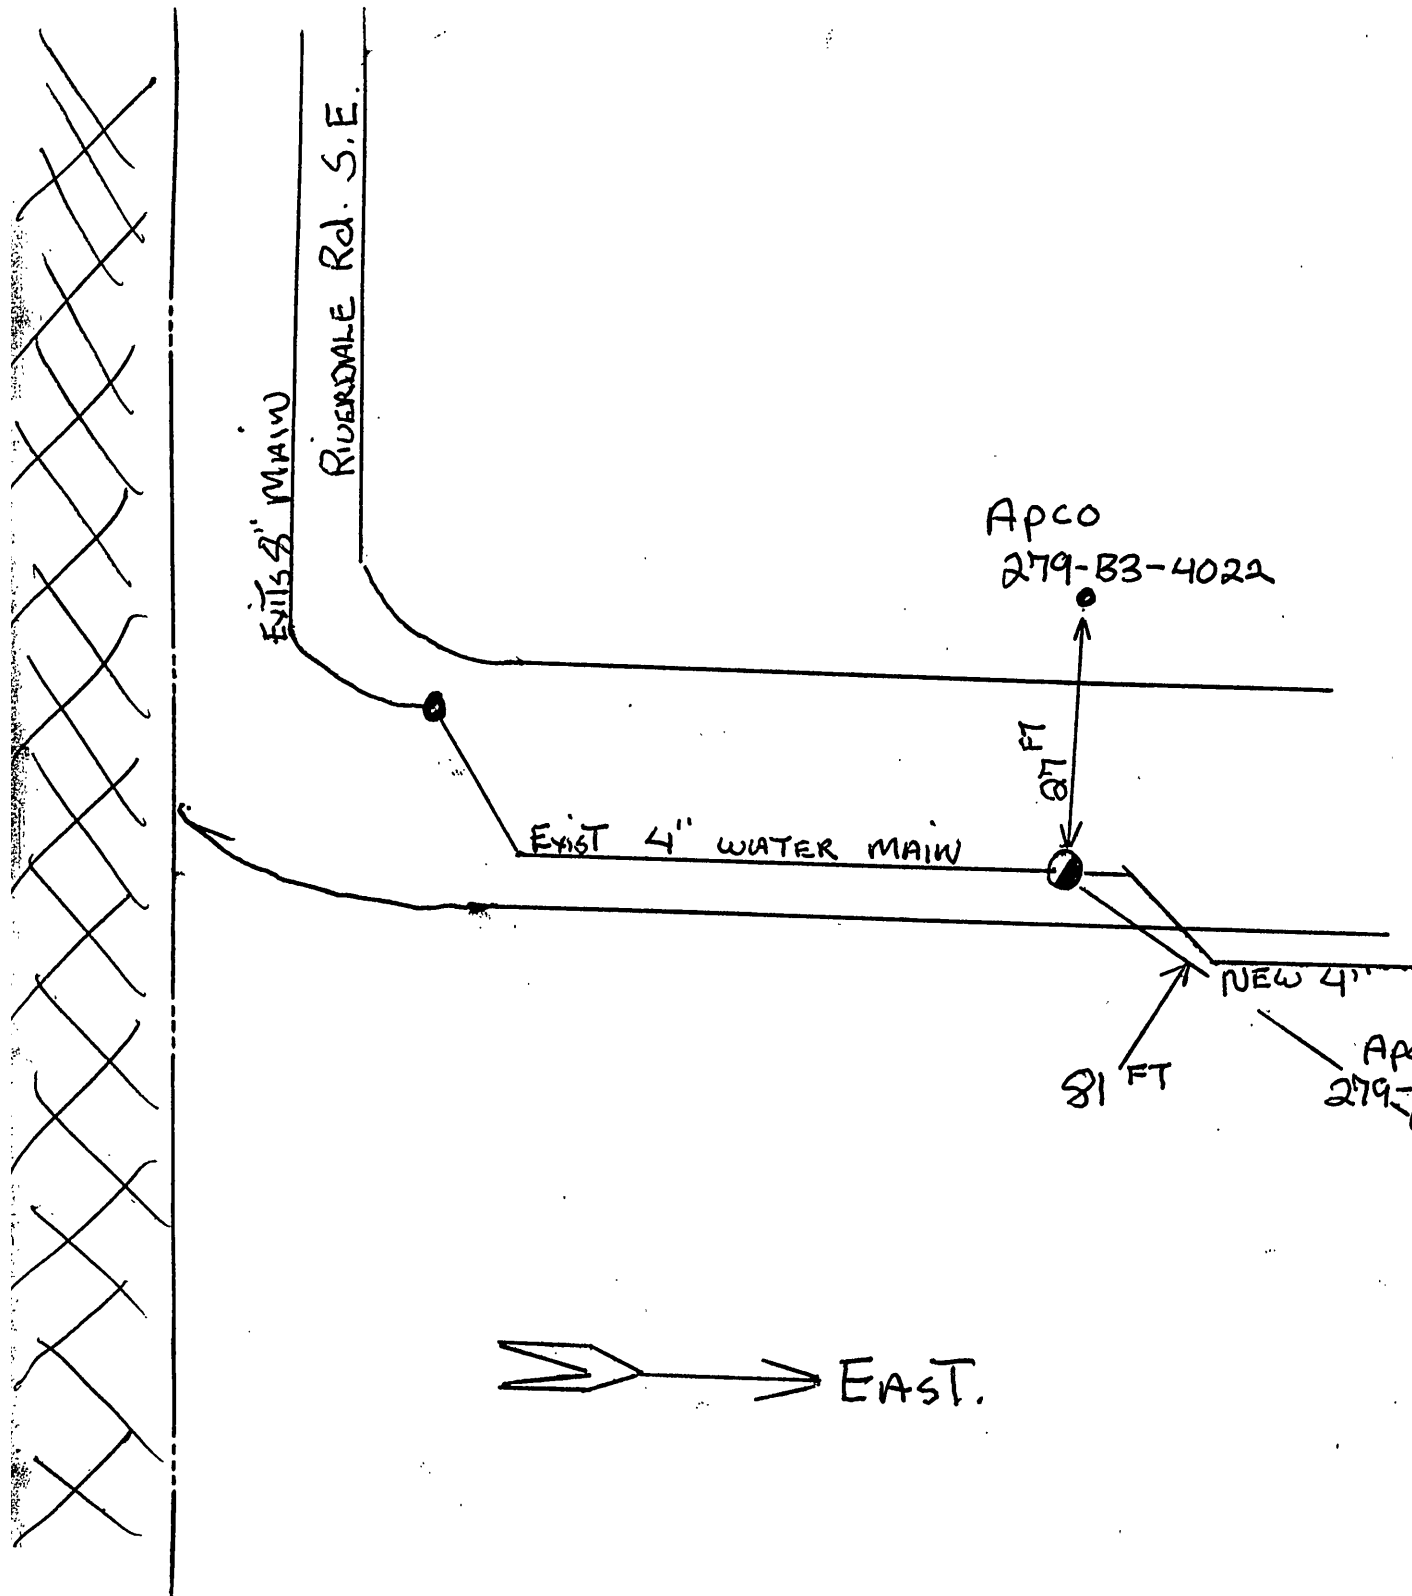


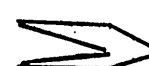

DATE	NO.	SIZE	MAKE	OPEN	TURNS
3/24/02	1	4'	MUL.	R	18


 → EAST.

CITY OF ROANOKE—WATER DEPT	
VALVE DIAGRAM	
2200 BIK RIVERDALE	
Rd. S.E.	
SEC. MAP	444
DATE 3-26-02	PAGE NO. 443