



2200 BIK RIVERDALE Rd. S.E.

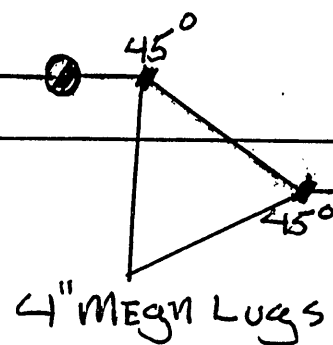

1 FT BEHIND CURB.

155 FT NEW 4" MIANW

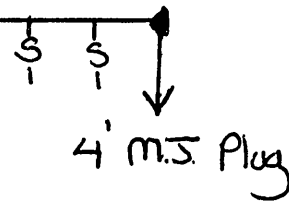

RW