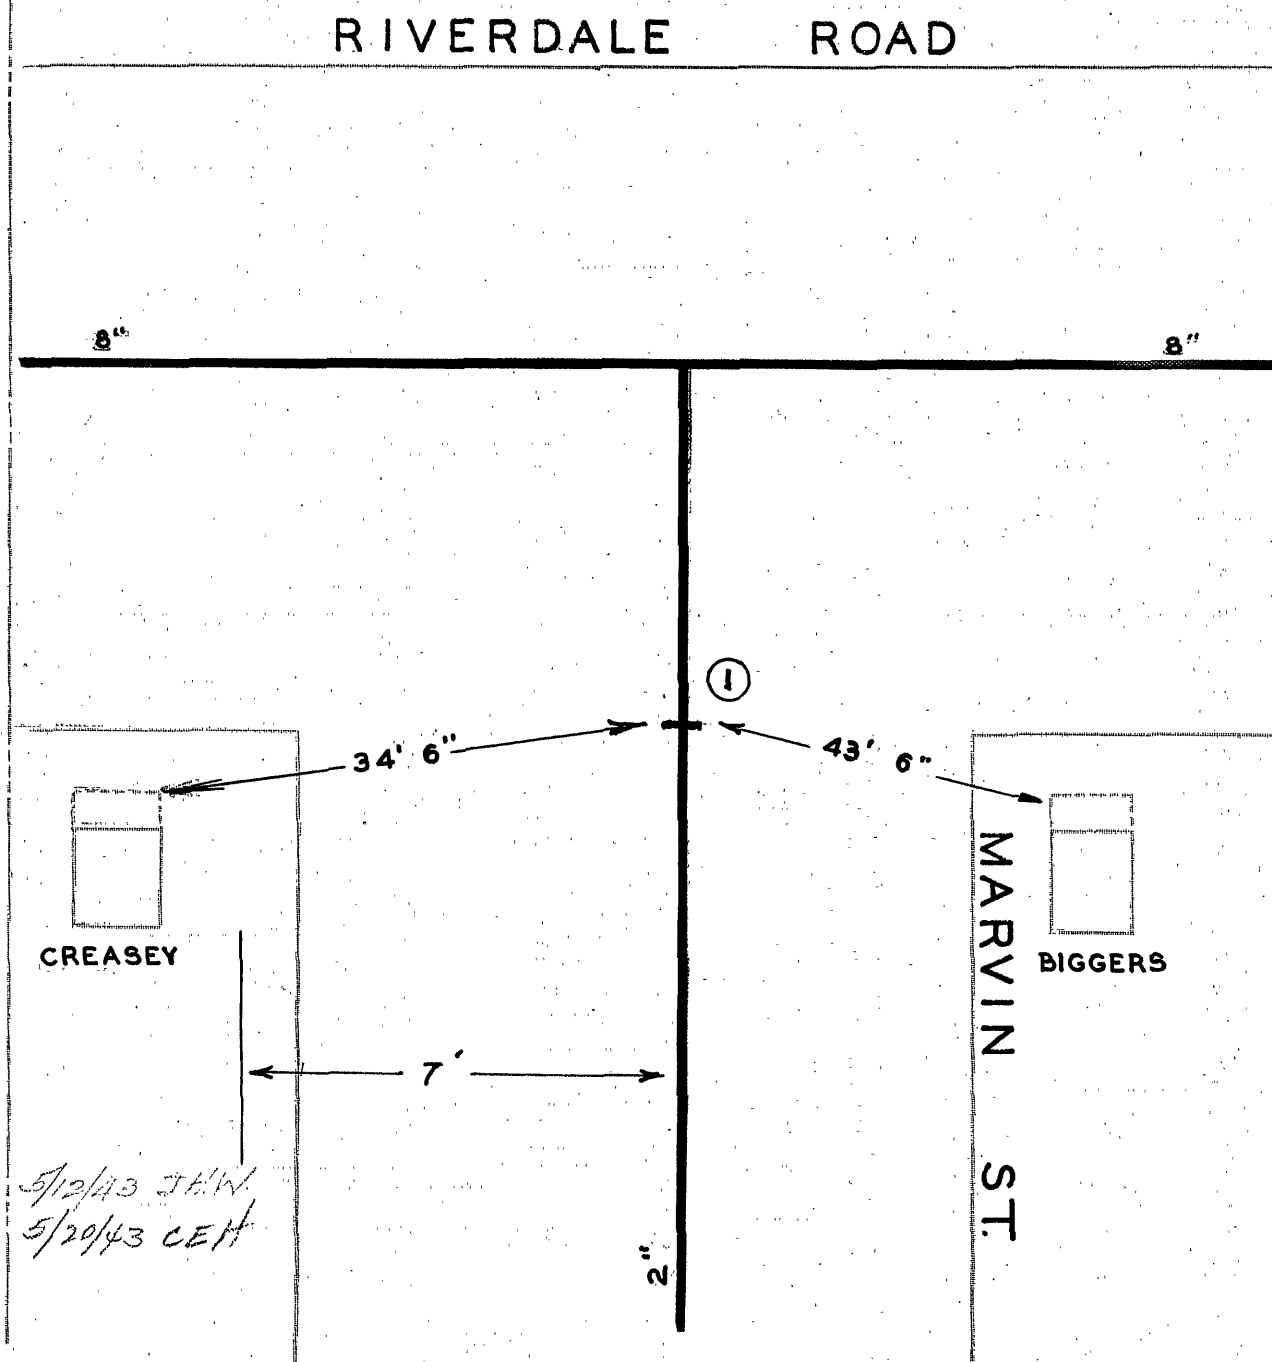


[illegible]

CITY OF ROANOKE—WATER DEPT
VALVE DIAGRAM

MARVIN STREET &
RIVERDALE ROAD S.E.

SEC. MAP 443

DATE _____

PAGE NO. S.E. 99