


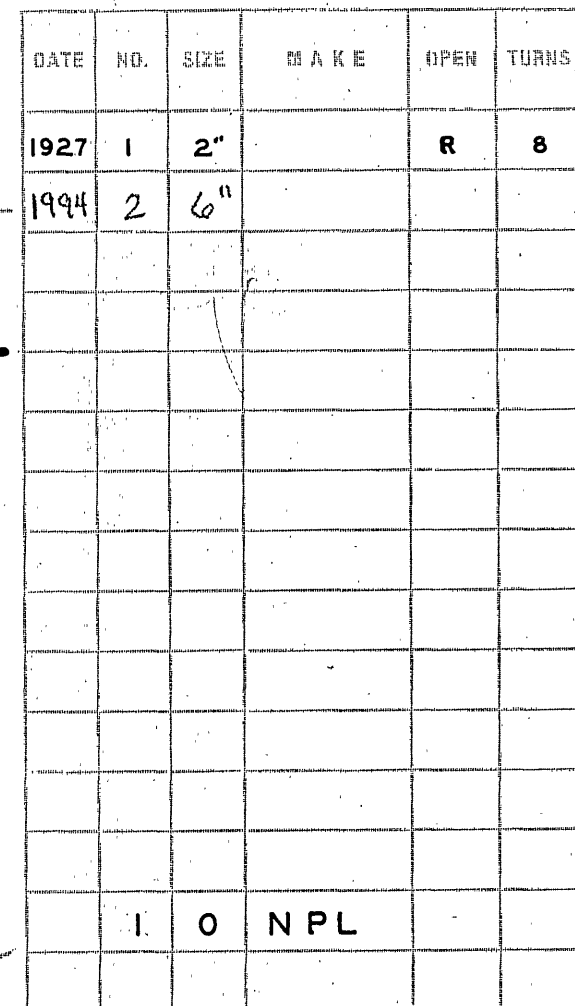

PAGE NO. S.W.149