



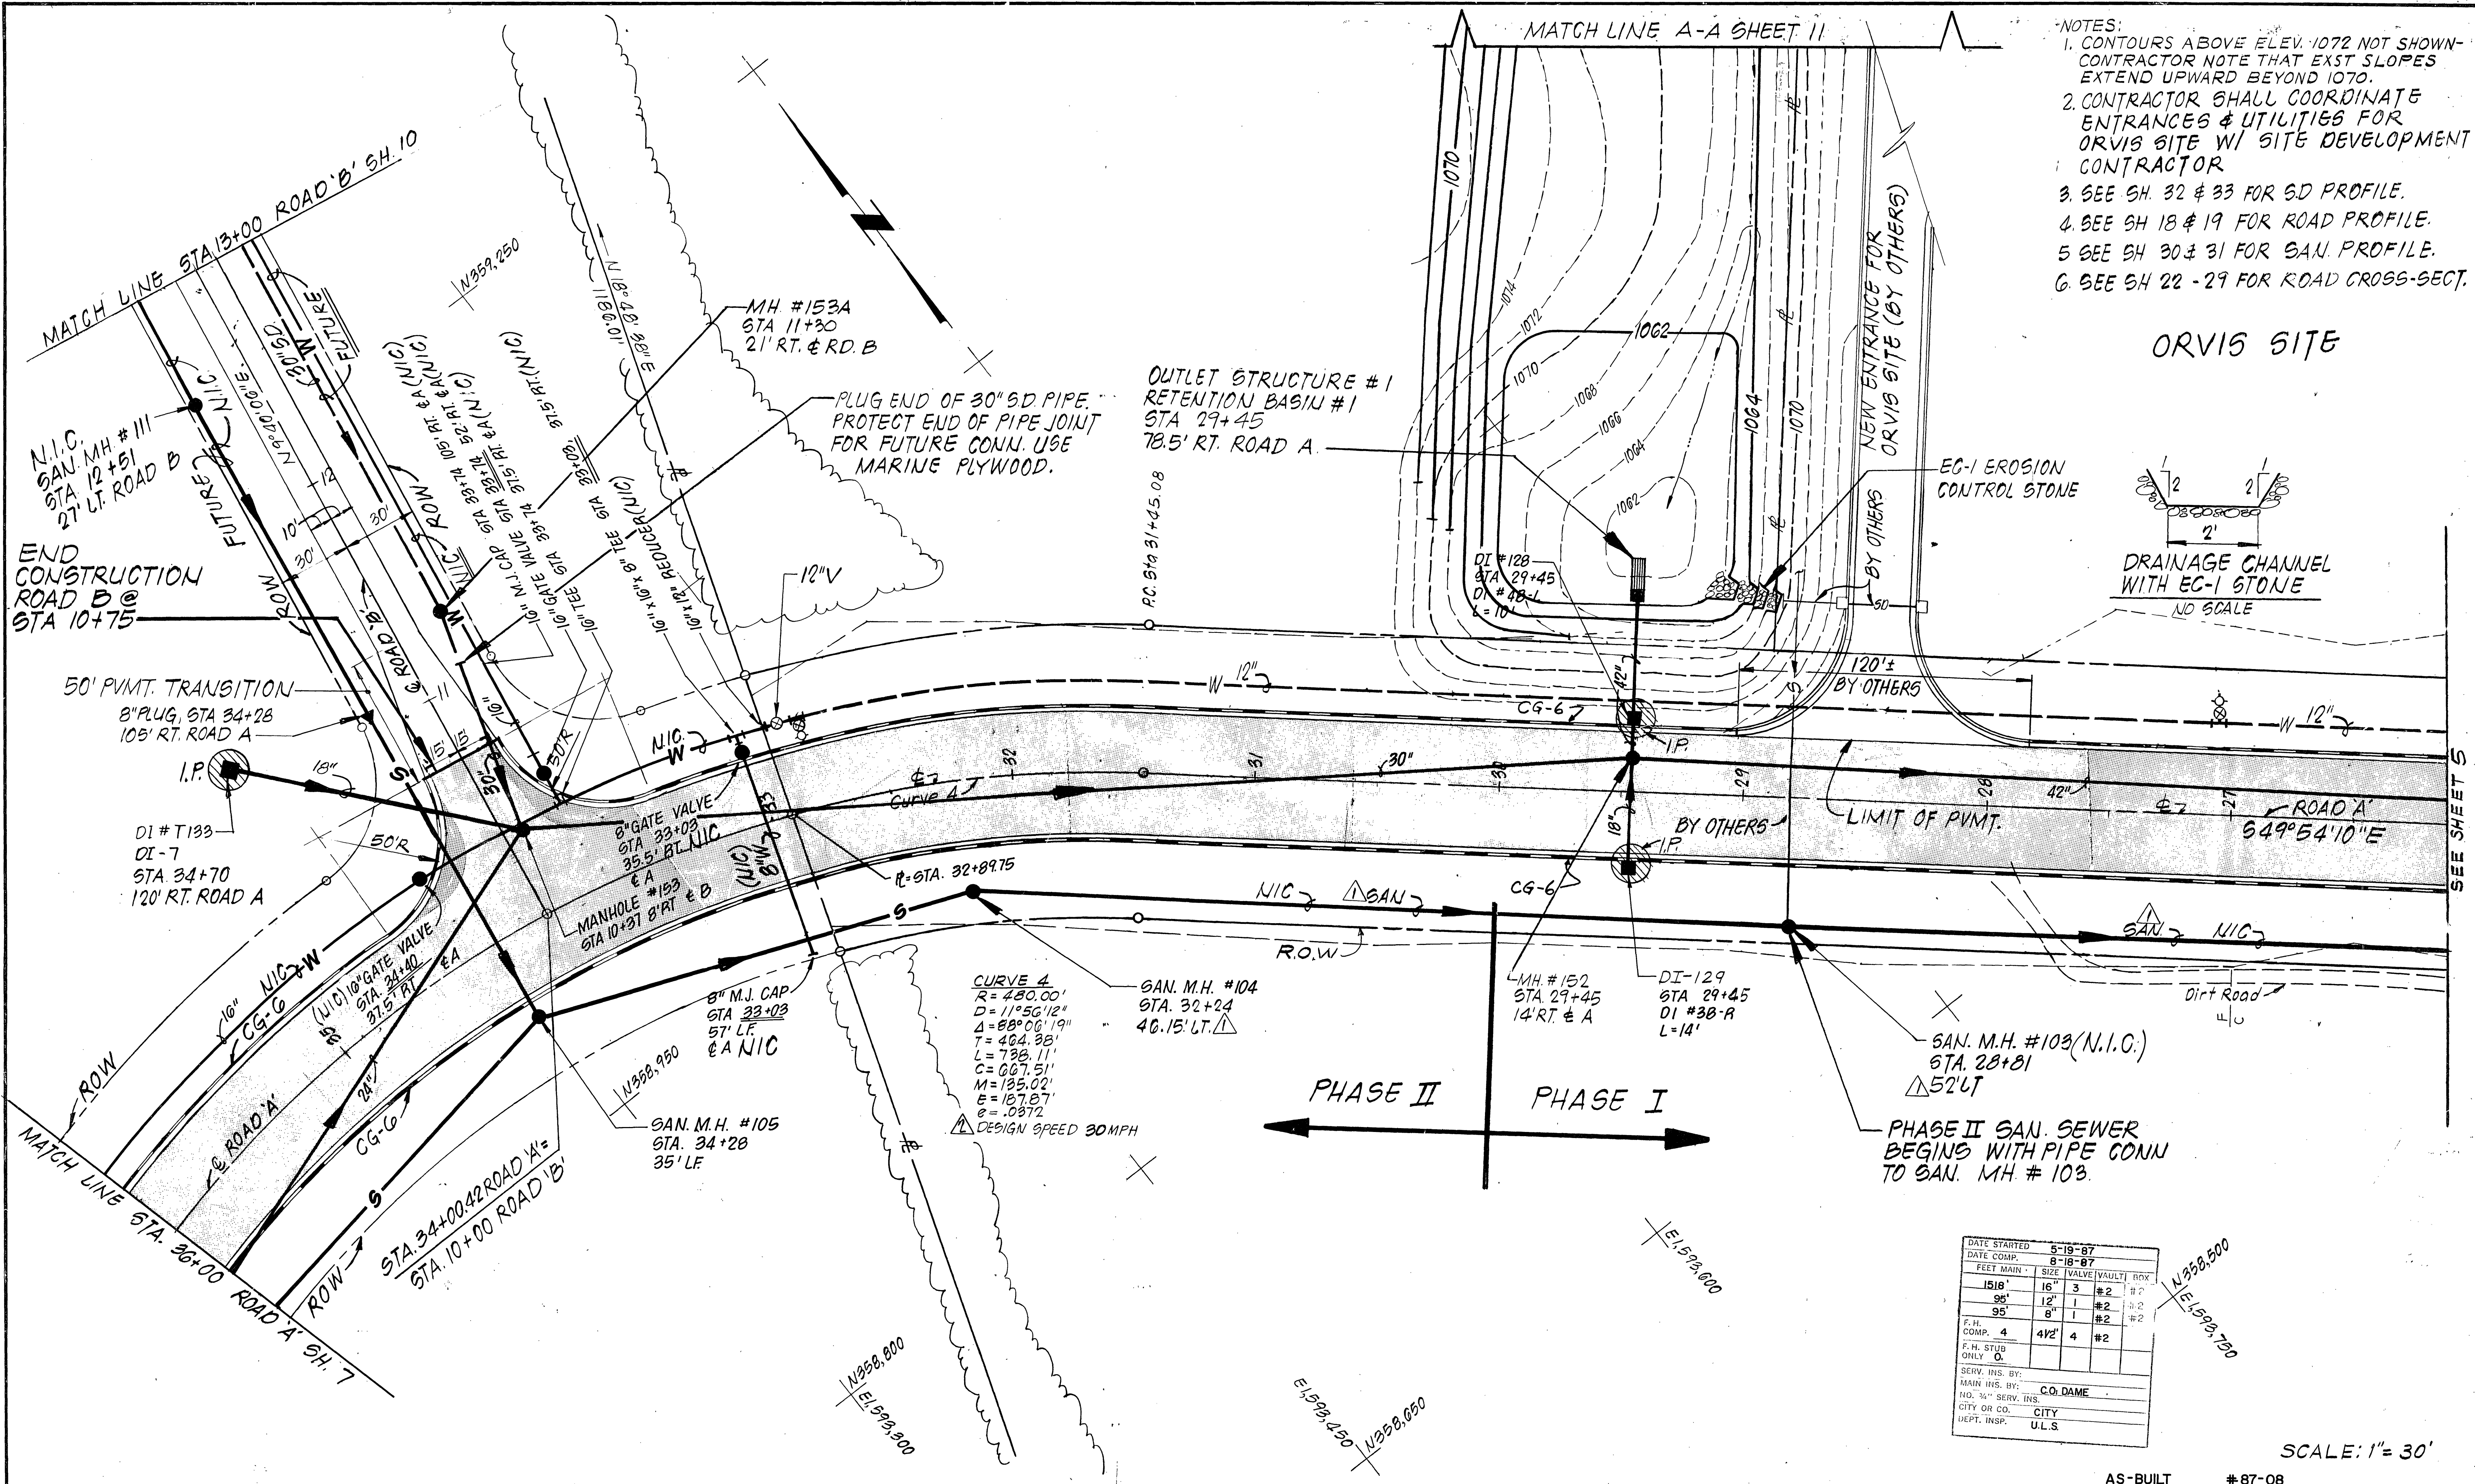

- NOTES:
1. CONTOURS ABOVE ELEV. 1072 NOT SHOWN. CONTRACTOR NOTE THAT EXIST SLOPES EXTEND UPWARD BEYOND 1070.
 2. CONTRACTOR SHALL COORDINATE ENTRANCES & UTILITIES FOR ORVIS SITE W/ SITE DEVELOPMENT CONTRACTOR
 3. SEE SH. 32 & 33 FOR SD PROFILE.
 4. SEE SH 18 & 19 FOR ROAD PROFILE.
 5. SEE SH 30 & 31 FOR SAN. PROFILE.
 6. SEE SH 22 - 29 FOR ROAD CROSS-SECT.

ORVIS SITE

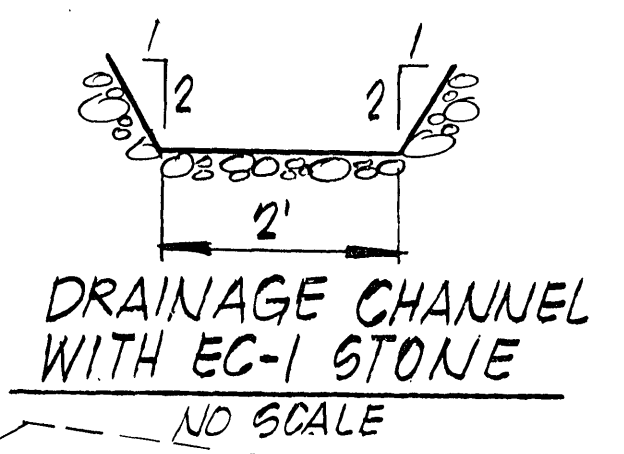

DATE STARTED	5-18-87
DATE COMP.	8-18-87
FEET MAIN	1518'
1518'	16"
95'	12"
95'	8"
F.H. COMP.	4
F.H. STUB ONLY	0
SERV. INS. BY:	C.O. DAME
MAIN INS. BY:	
NO. 36" SERV. INS.	
CITY OR CO.	CITY
DEPT. INSP.	U.L.S.

SCALE: 1" = 30'

AS-BUILT #87-08

Mattern & Craig CONSULTING ENGINEERS SUITE 401, 707 S. JEFFERSON STREET, ROANOKE, VIRGINIA 24011, (703) 345-9342	DESIGNED: DRM		REVISION	DATE	DESCRIPTION	BY	APP.	DATE	ROANOKE CENTRE FOR INDUSTRY AND TECHNOLOGY CITY OF ROANOKE, VIRGINIA ADVANCE PLAN ROADWAY, WATER & STORM DRAIN	SHEET 6
	CHECKED: WJJ		1	2/5/87	REV. LOCATION OF SANITARY LINE	RSM	WJJ	JAN. 87		
	APPROVED: SWH		2	3/12/87	REV. CURVE DATA	RSM	WJJ	COMM. 677		