


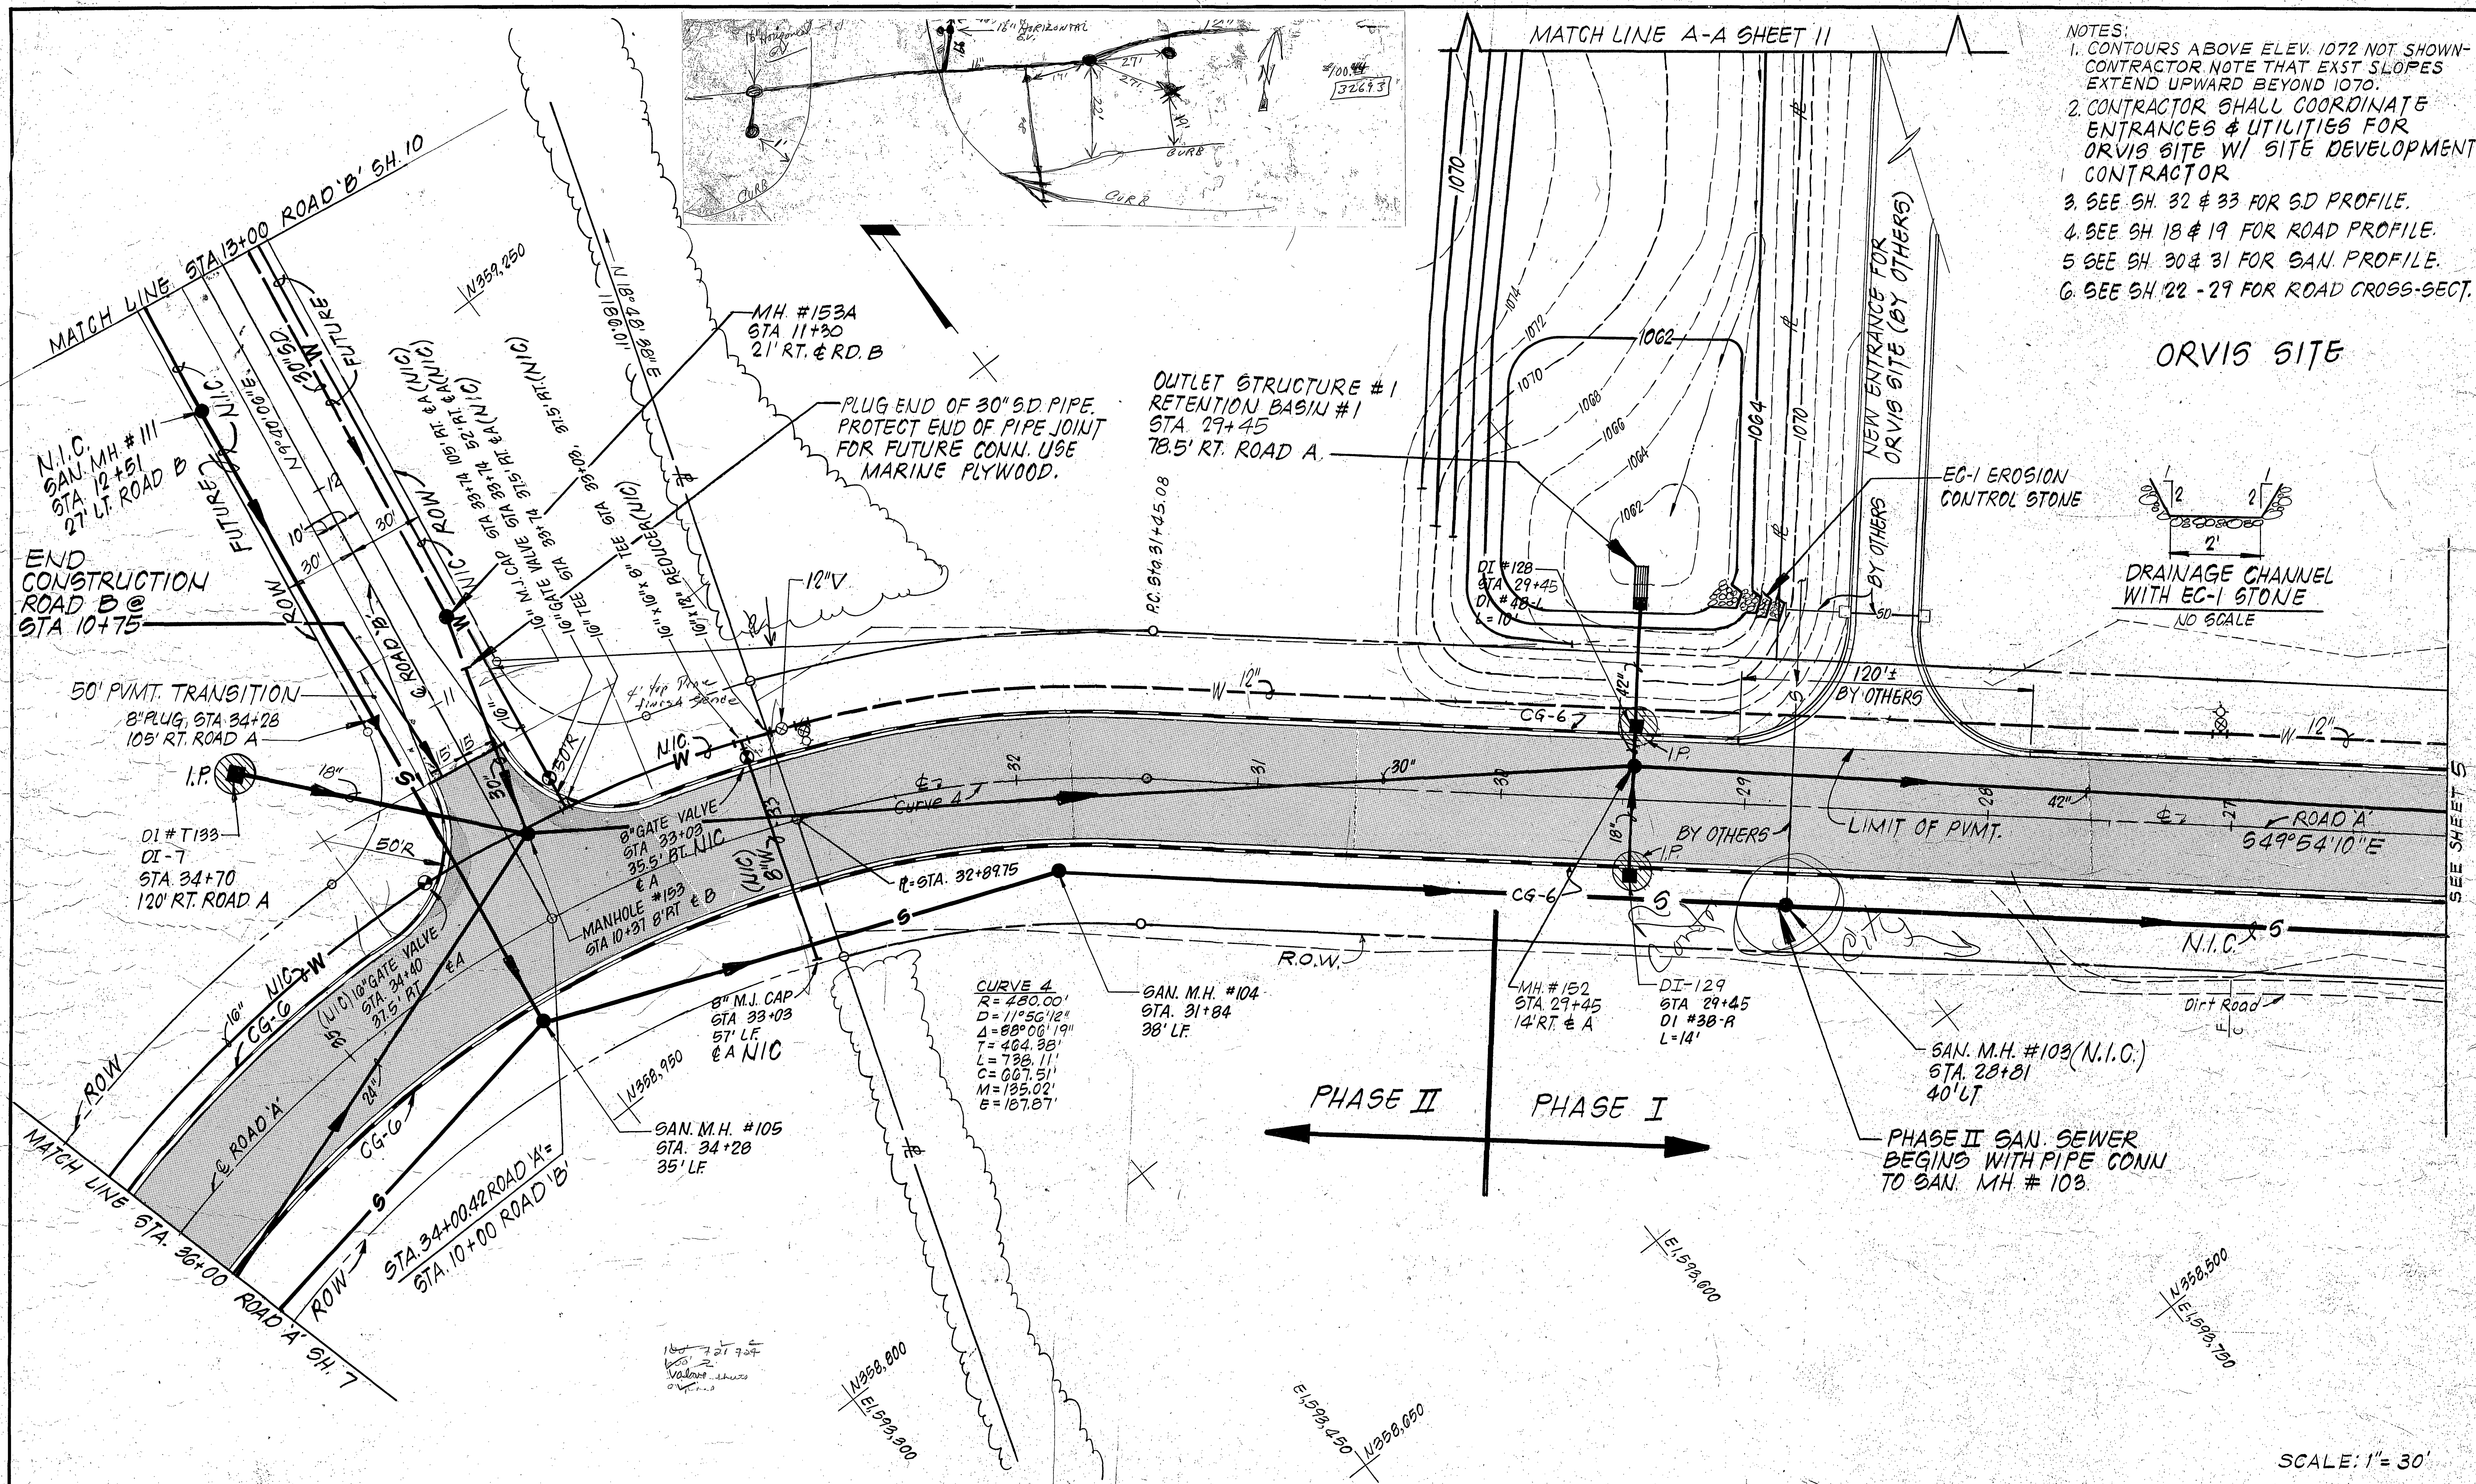

NOTES:

1. CONTOURS ABOVE ELEV. 1072 NOT SHOWN- CONTRACTOR NOTE THAT EXIST SLOPES EXTEND UPWARD BEYOND 1070.
2. CONTRACTOR SHALL COORDINATE ENTRANCES & UTILITIES FOR ORVIS SITE W/ SITE DEVELOPMENT
- 1 CONTRACTOR
3. SEE SH. 32 & 33 FOR SD PROFILE.
4. SEE SH. 18 & 19 FOR ROAD PROFILE.
5. SEE SH. 30 & 31 FOR SAN. PROFILE.
6. SEE SH. 22 - 29 FOR ROAD CROSS-SECT.


ORVIS SITE

DRAINAGE CHANNEL
WITH EC-1 STONE
NO SCALE

SCALE: 1" = 30'



DESIGNED:	DRM
CHECKED:	WJJ
APPROVED:	SWH

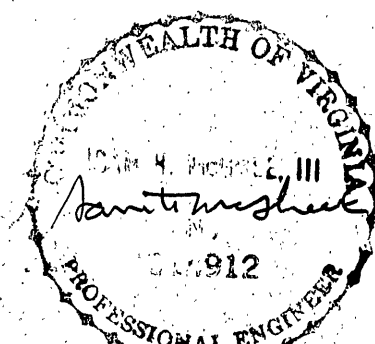

REVISION	DATE	DESCRIPTION	BY	APP.	DATE
					JAN. 87
					COMM.
					677

ROANOKE CENTRE FOR INDUSTRY AND TECHNOLOGY
CITY OF ROANOKE , VIRGINIA

PLAN ROADWAY, WATER & STORM DRAIN

SHEET
6

Water dept. # 87-08