



SEE SHEET 19 FOR ROAD AND WATER LINE PROFILES
 SEE SHEET 33 & 39 FOR SD PROFILES
 SEE SHEET 30 FOR SANITARY SEWER PROFILES

MATCH LINE STA 45+00 ROAD A SHEET 8

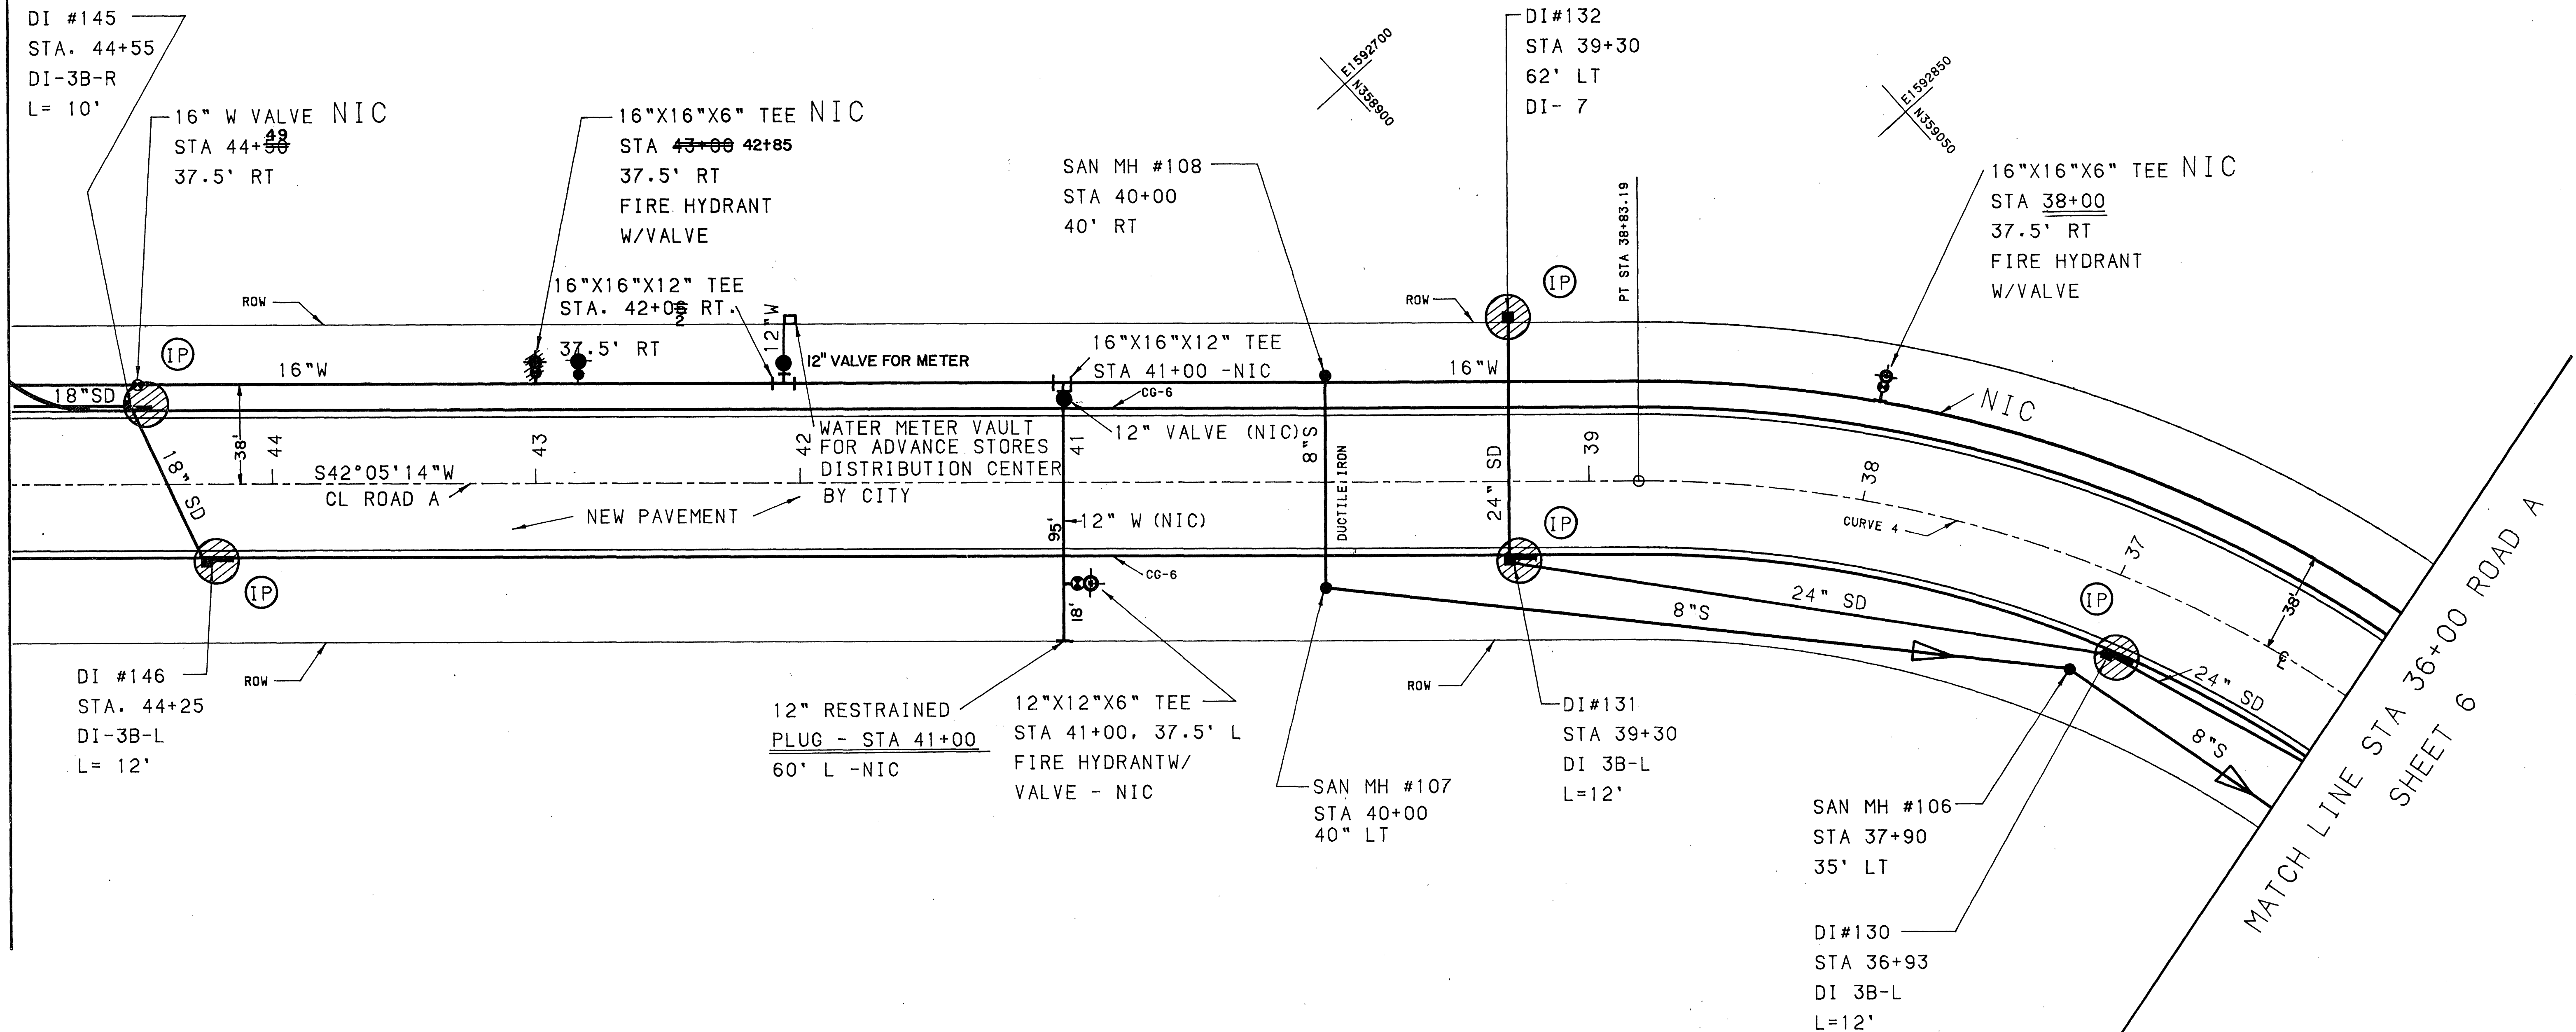


MATCH LINE STA 36+00 ROAD A
 SHEET 6

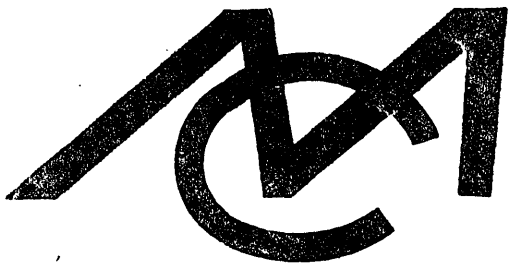

Mattern & Craig
 CONSULTING ENGINEERS
 SUITE 401, 707 S. JEFFERSON STREET, ROANOKE, VIRGINIA 24011, (703) 345-9342

DESIGNED:	RSM
CHECKED:	WJJ
APPROVED:	SWH

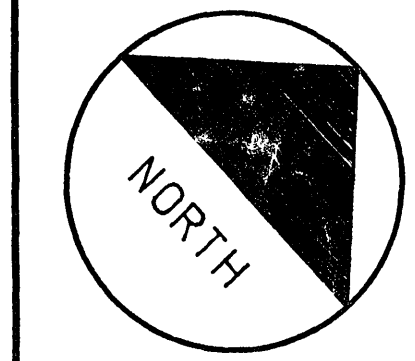

REVISION	DATE	DESCRIPTION	BY	APP.

DATE
JAN 1997
 COMM.
677E

ROANOKE CENTRE FOR INDUSTRY AND TECHNOLOGY
 CITY OF ROANOKE, VIRGINIA
 PLAN
 ROADWAY, WATER, SANITARY AND STORM DRAIN

AS-BUILT # 87-08
 SHEET
7