

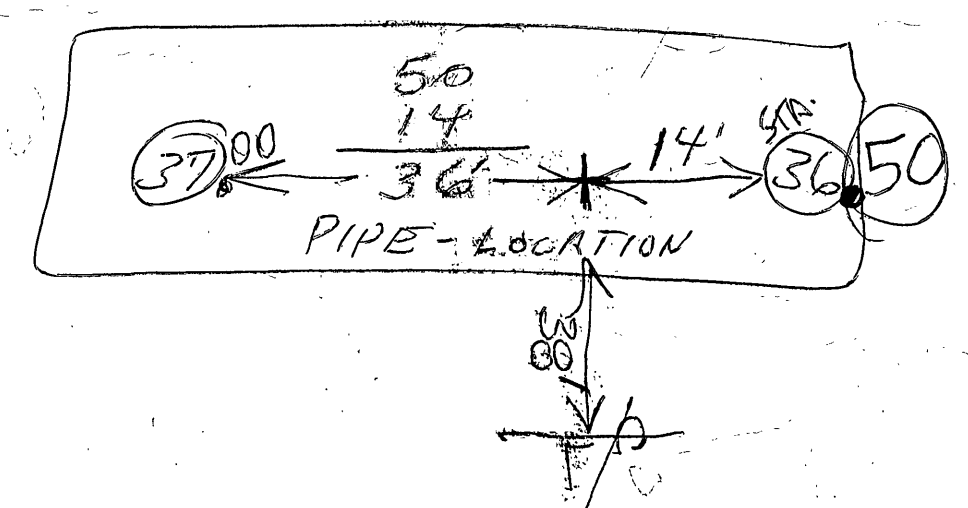


* SEE SHEET 19 FOR ROAD AND WATER LINE PROFILES
 SEE SHEET 33 & 39 FOR SD PROFILES
 SEE SHEET 30 FOR SANITARY SEWER PROFILES

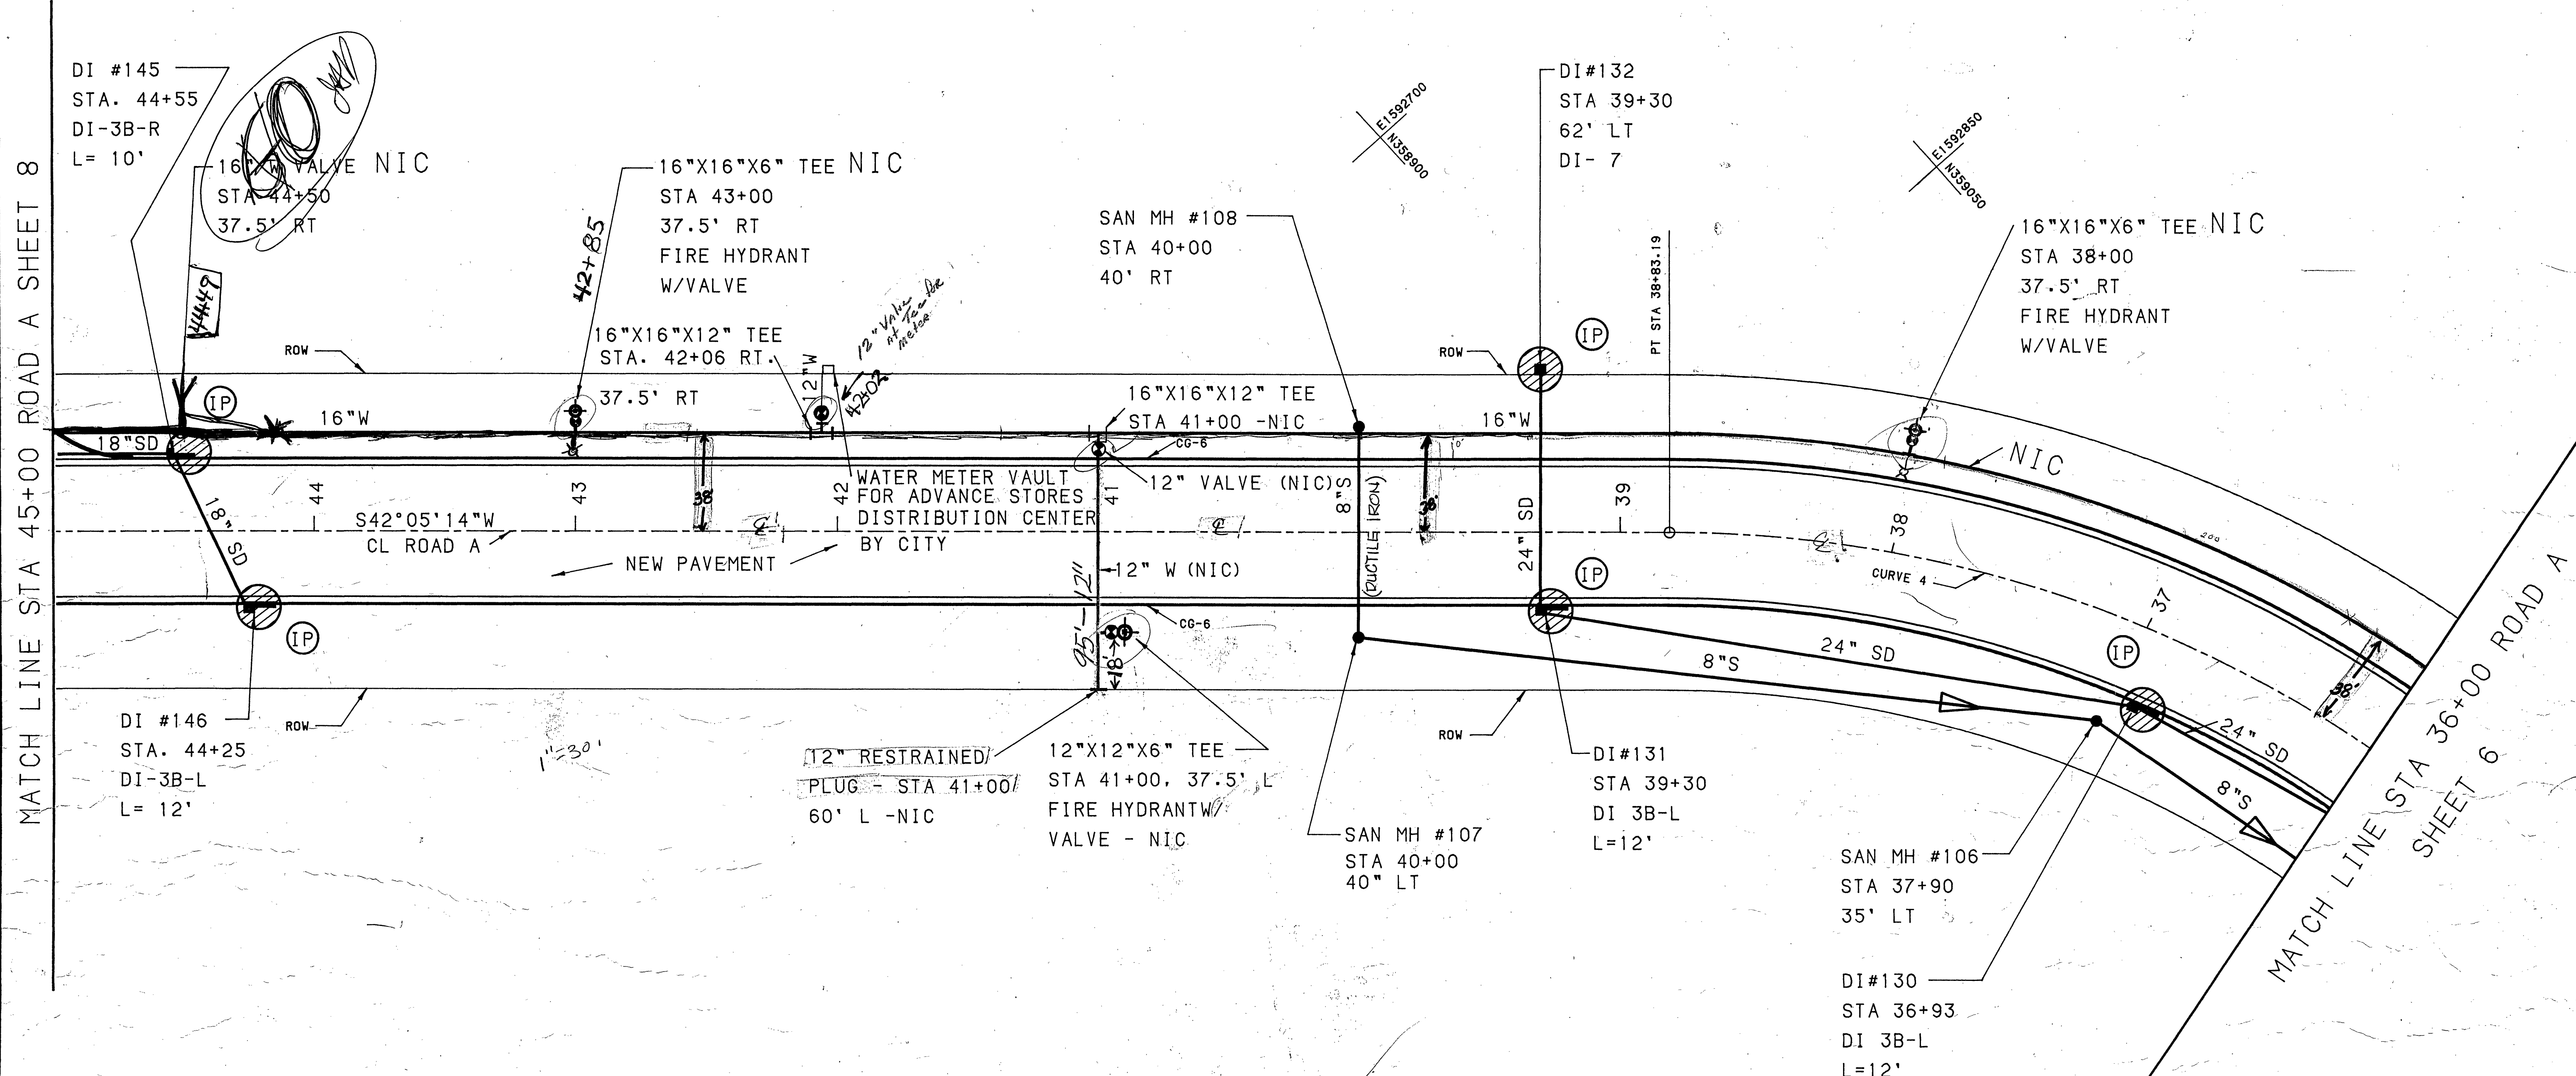


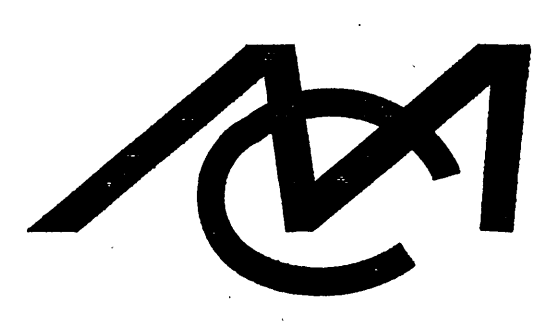


Mattern & Craig
CONSULTING ENGINEERS

SUITE 401, 707 S. JEFFERSON STREET, ROANOKE, VIRGINIA 24011. (703) 345-9342

DESIGNED:	RSM
CHECKED:	WJJ
APPROVED:	SWH

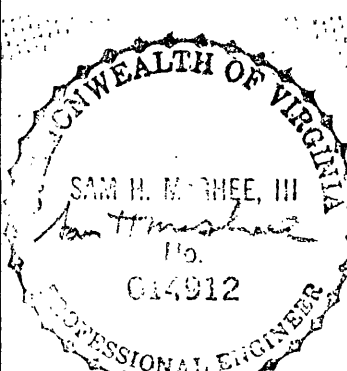

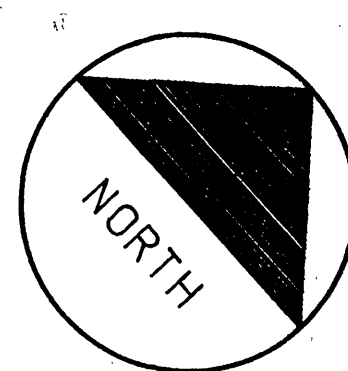

REVISION	DATE	DESCRIPTION	BY	APP.

DATE
JAN 1987

COMM.
677E

ROANOKE CENTRE FOR INDUSTRY AND TECHNOLOGY

CITY OF ROANOKE, VIRGINIA

PLAN

ROADWAY, WATER, SANITARY AND STORM DRAIN

SHEET

7

water dept. #B7-00