


MATCH LINE STA 53+50 ROAD A SHEET 9

MATCH LINE STA 45+00 ROAD A SHEET 7

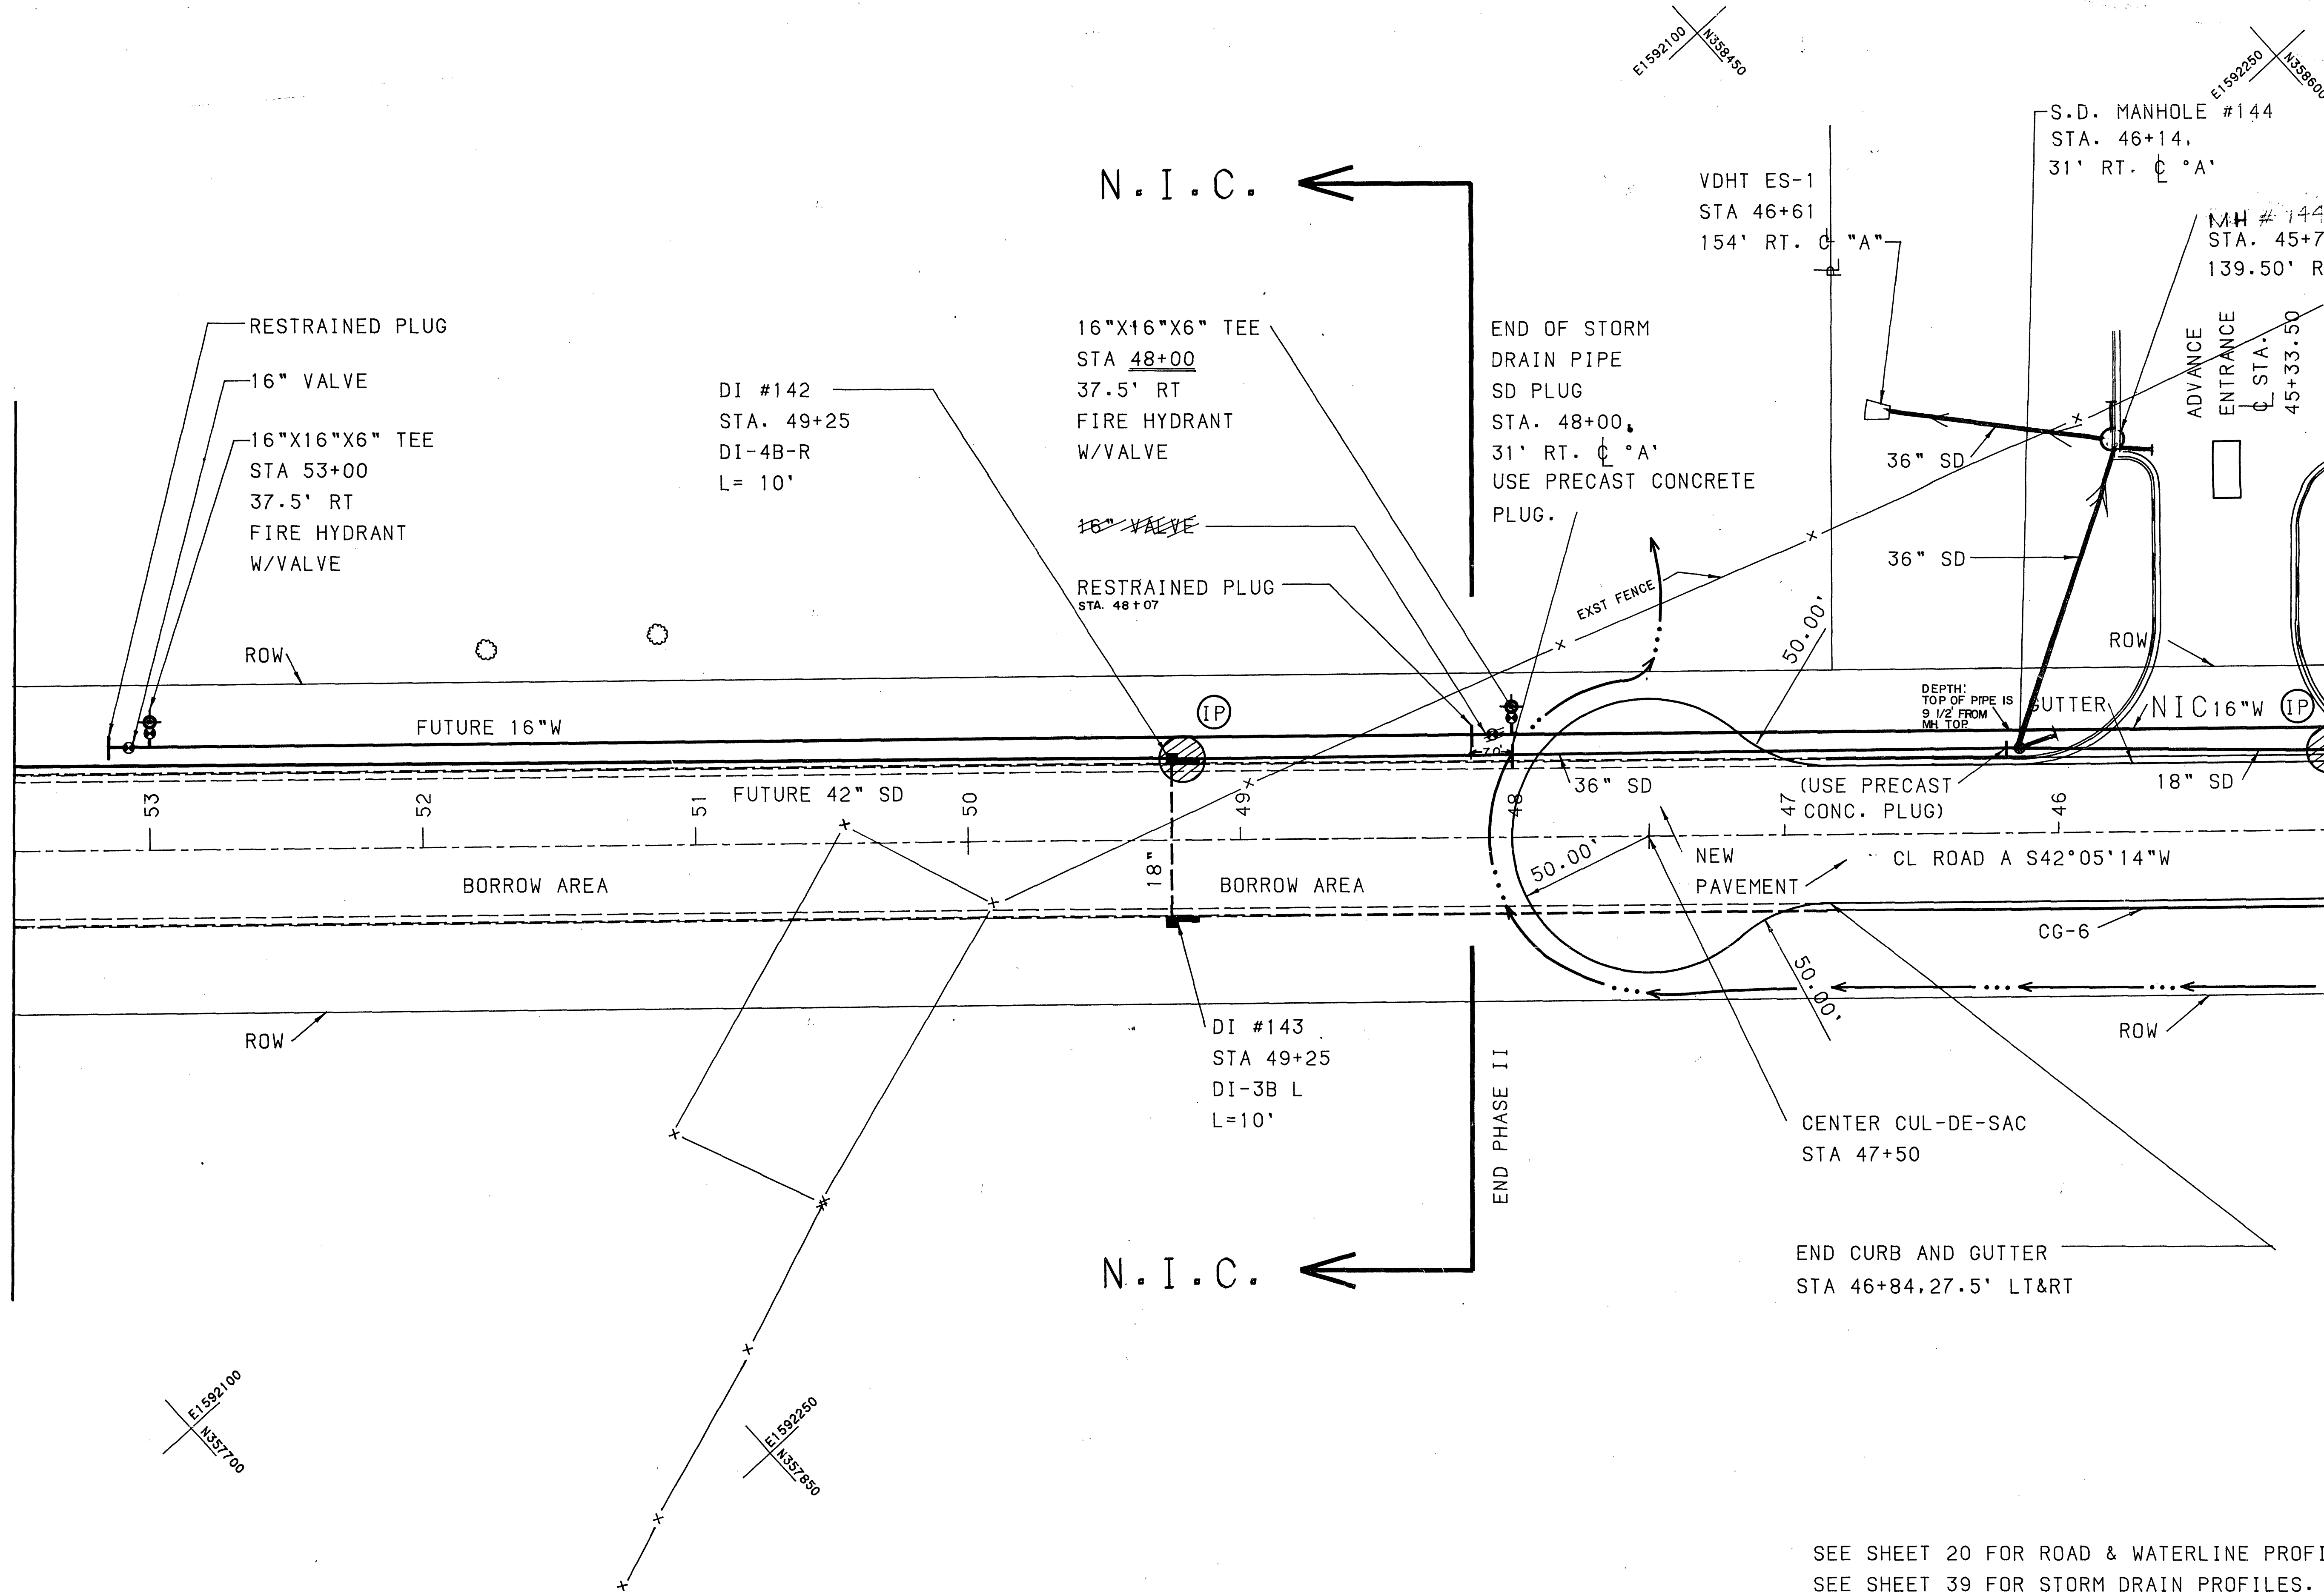

SEE SHEET 20 FOR ROAD & WATERLINE PROFILES.
SEE SHEET 39 FOR STORM DRAIN PROFILES.



AS-BUILT #87-08



Mattern & Craig
CONSULTING ENGINEERS

SUITE 401, 707 S. JEFFERSON STREET, ROANOKE, VIRGINIA 24011, (703) 345-9342

DESIGNED: RSM
CHECKED: WJJ
APPROVED: SWH

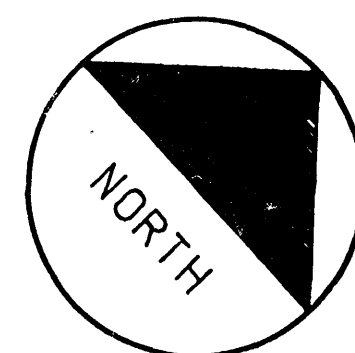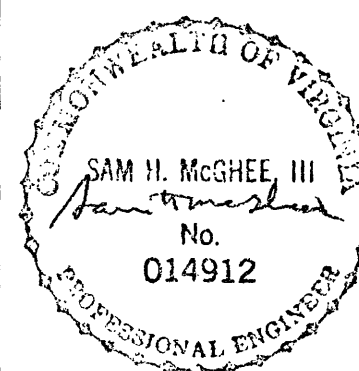

REVISION	DATE	DESCRIPTION	BY	APP.
1	2/10/87	include stub outs on MH 144 & MH 144 B	WJJ	

DATE
JAN 1987
COMM.
677E

ROANOKE CENTRE FOR INDUSTRY AND TECHNOLOGY
CITY OF ROANOKE, VIRGINIA
PLAN
ROADWAY, WATER, SANITARY AND STORM DRAIN

SHEET
8