


MATCH LINE STA 53+50 ROAD A SHEET 9

MATCH LINE STA 45+00 ROAD A SHEET 7

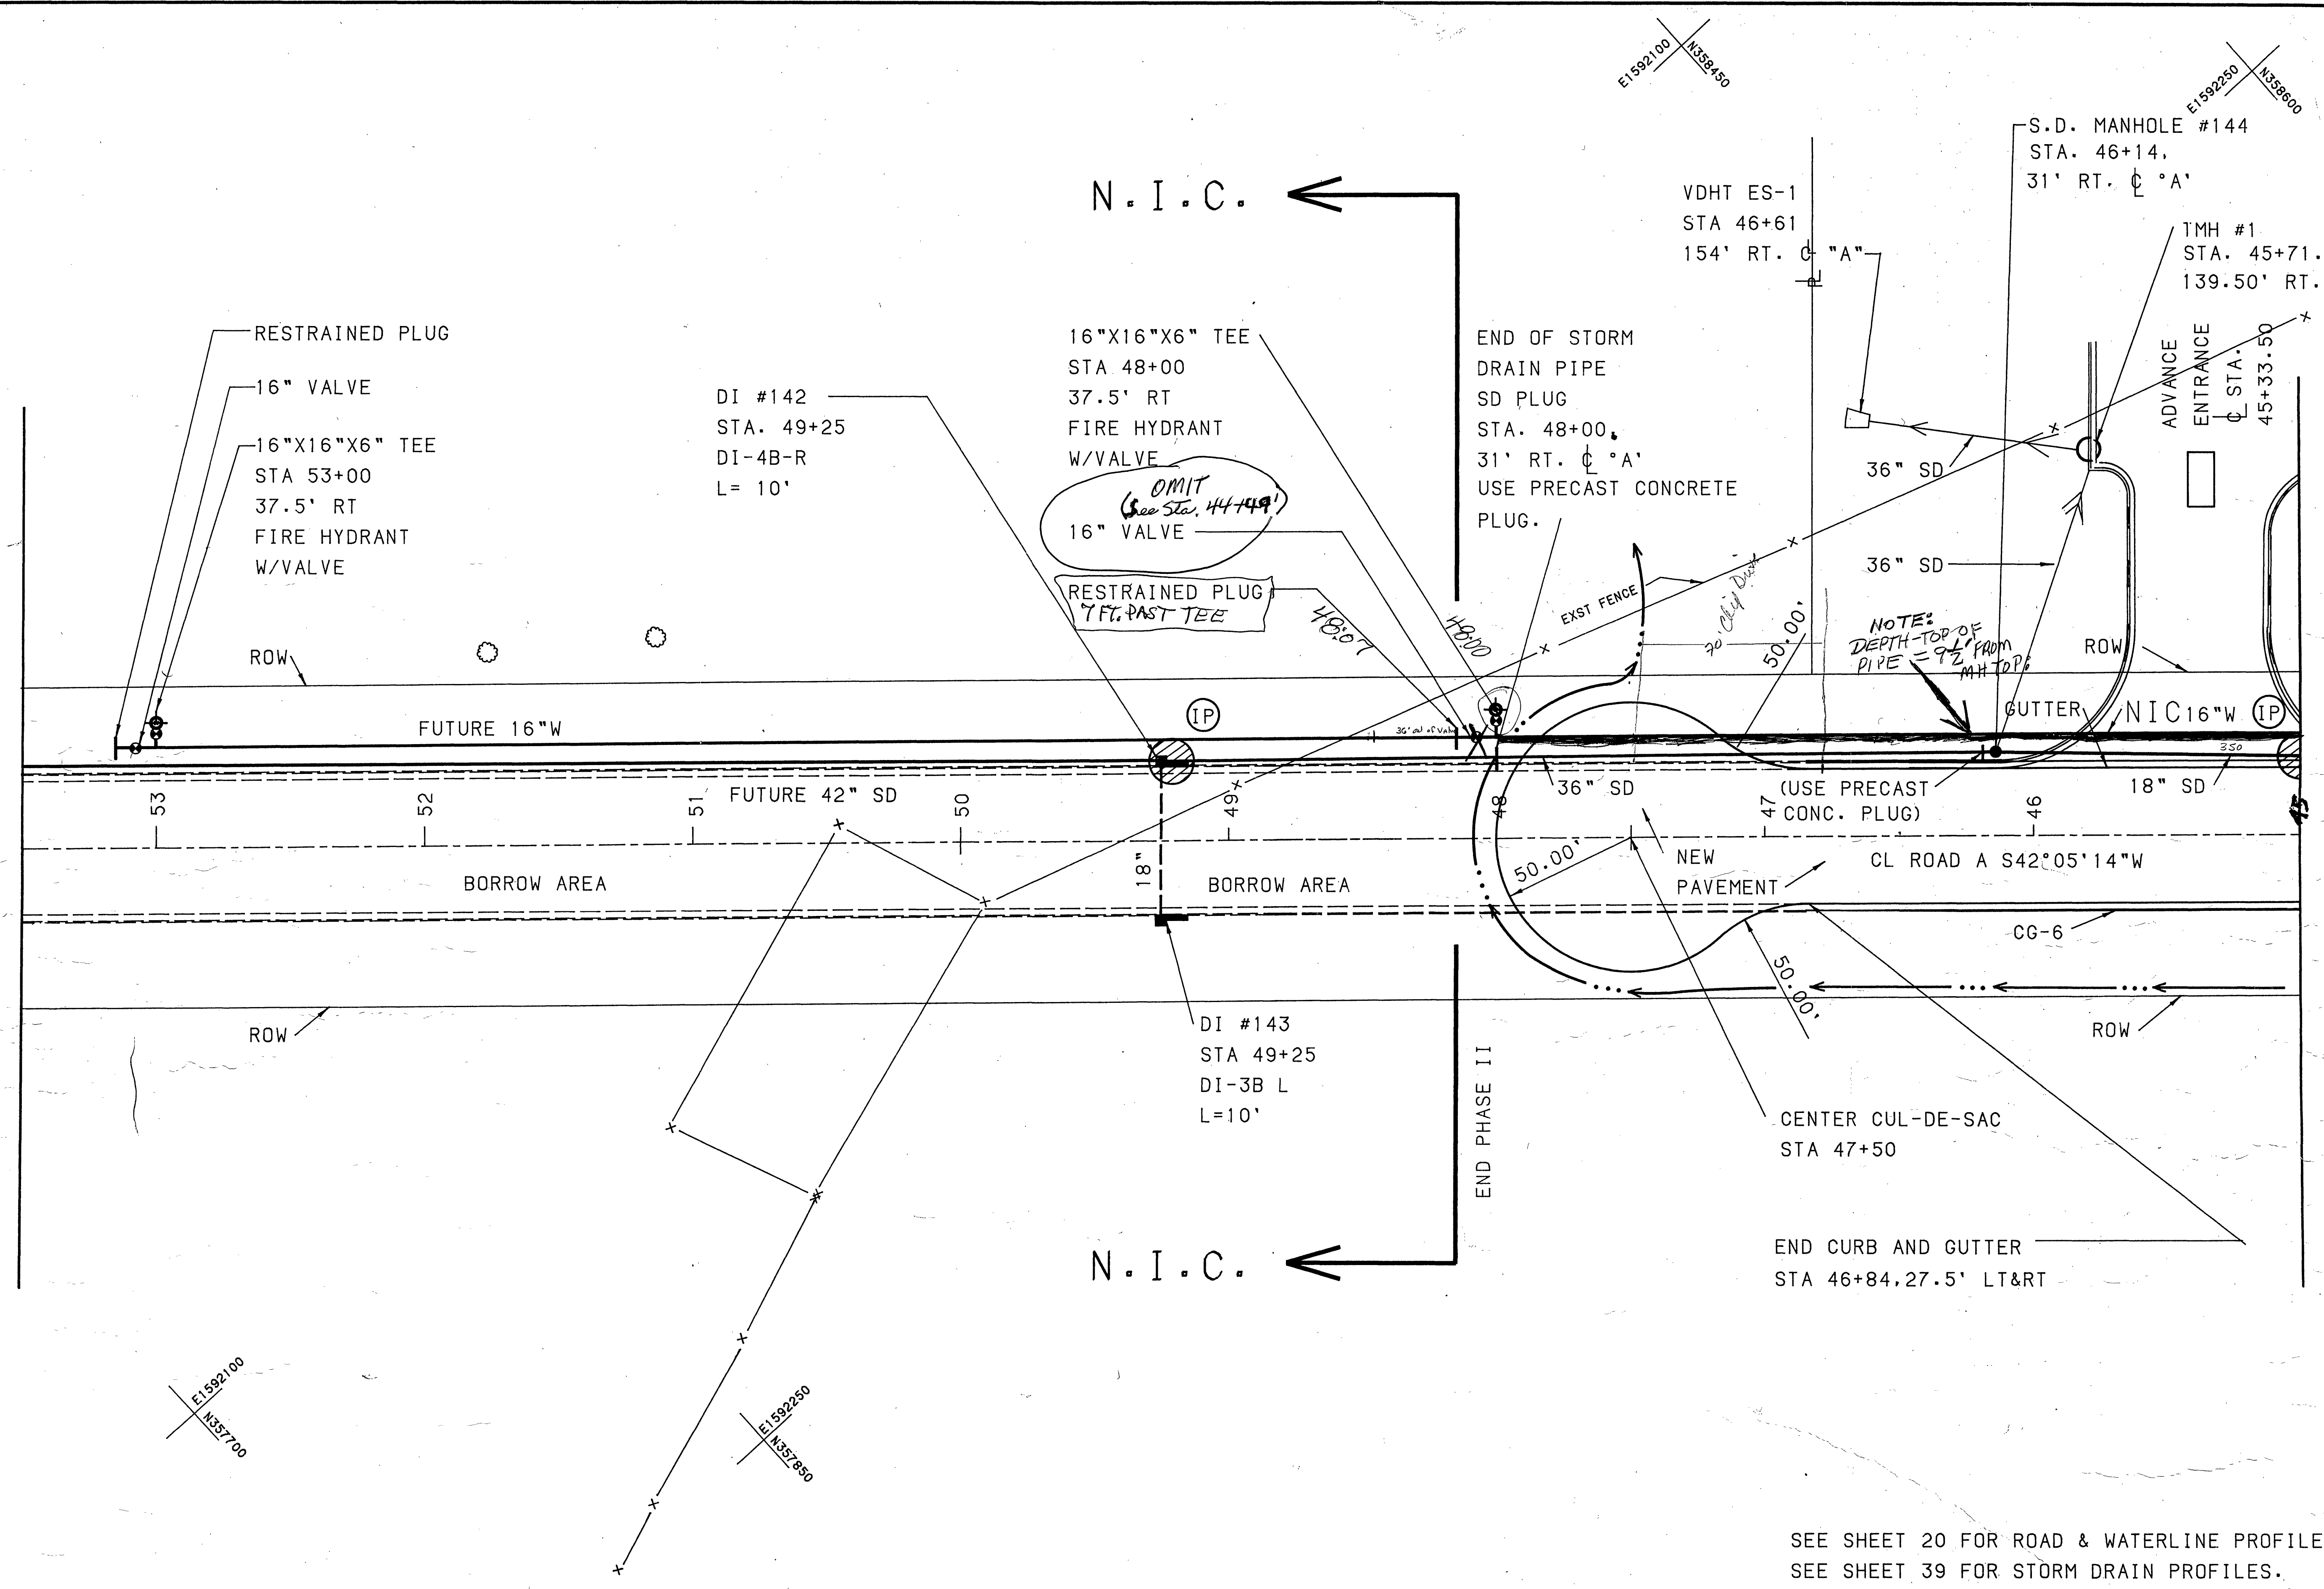


SEE SHEET 20 FOR ROAD & WATERLINE PROFILES.
SEE SHEET 39 FOR STORM DRAIN PROFILES.

MA
Mattern & Craig
CONSULTING ENGINEERS
SUITE 401, 707 S. JEFFERSON STREET, ROANOKE, VIRGINIA 24011, (703) 345-9342

DESIGNED:	RSM
CHECKED:	WJJ
APPROVED:	SWH

COMMONWEALTH OF VIRGINIA
SAM M. McSHEE, III
Professional Engineer
No. 014912

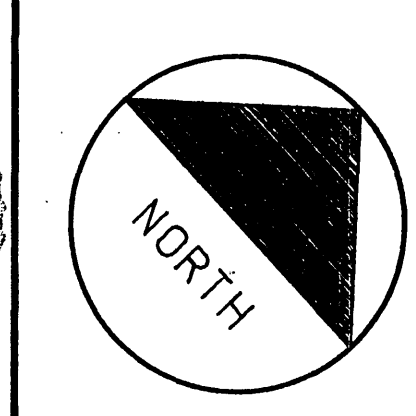

REVISION	DATE	DESCRIPTION	BY	APP.

DATE
JAN 1987

COMM.
677E

ROANOKE CENTRE FOR INDUSTRY AND TECHNOLOGY
CITY OF ROANOKE, VIRGINIA

PLAN
ROADWAY, WATER, SANITARY AND STORM DRAIN

SHEET
8

Water Dept #87-08