


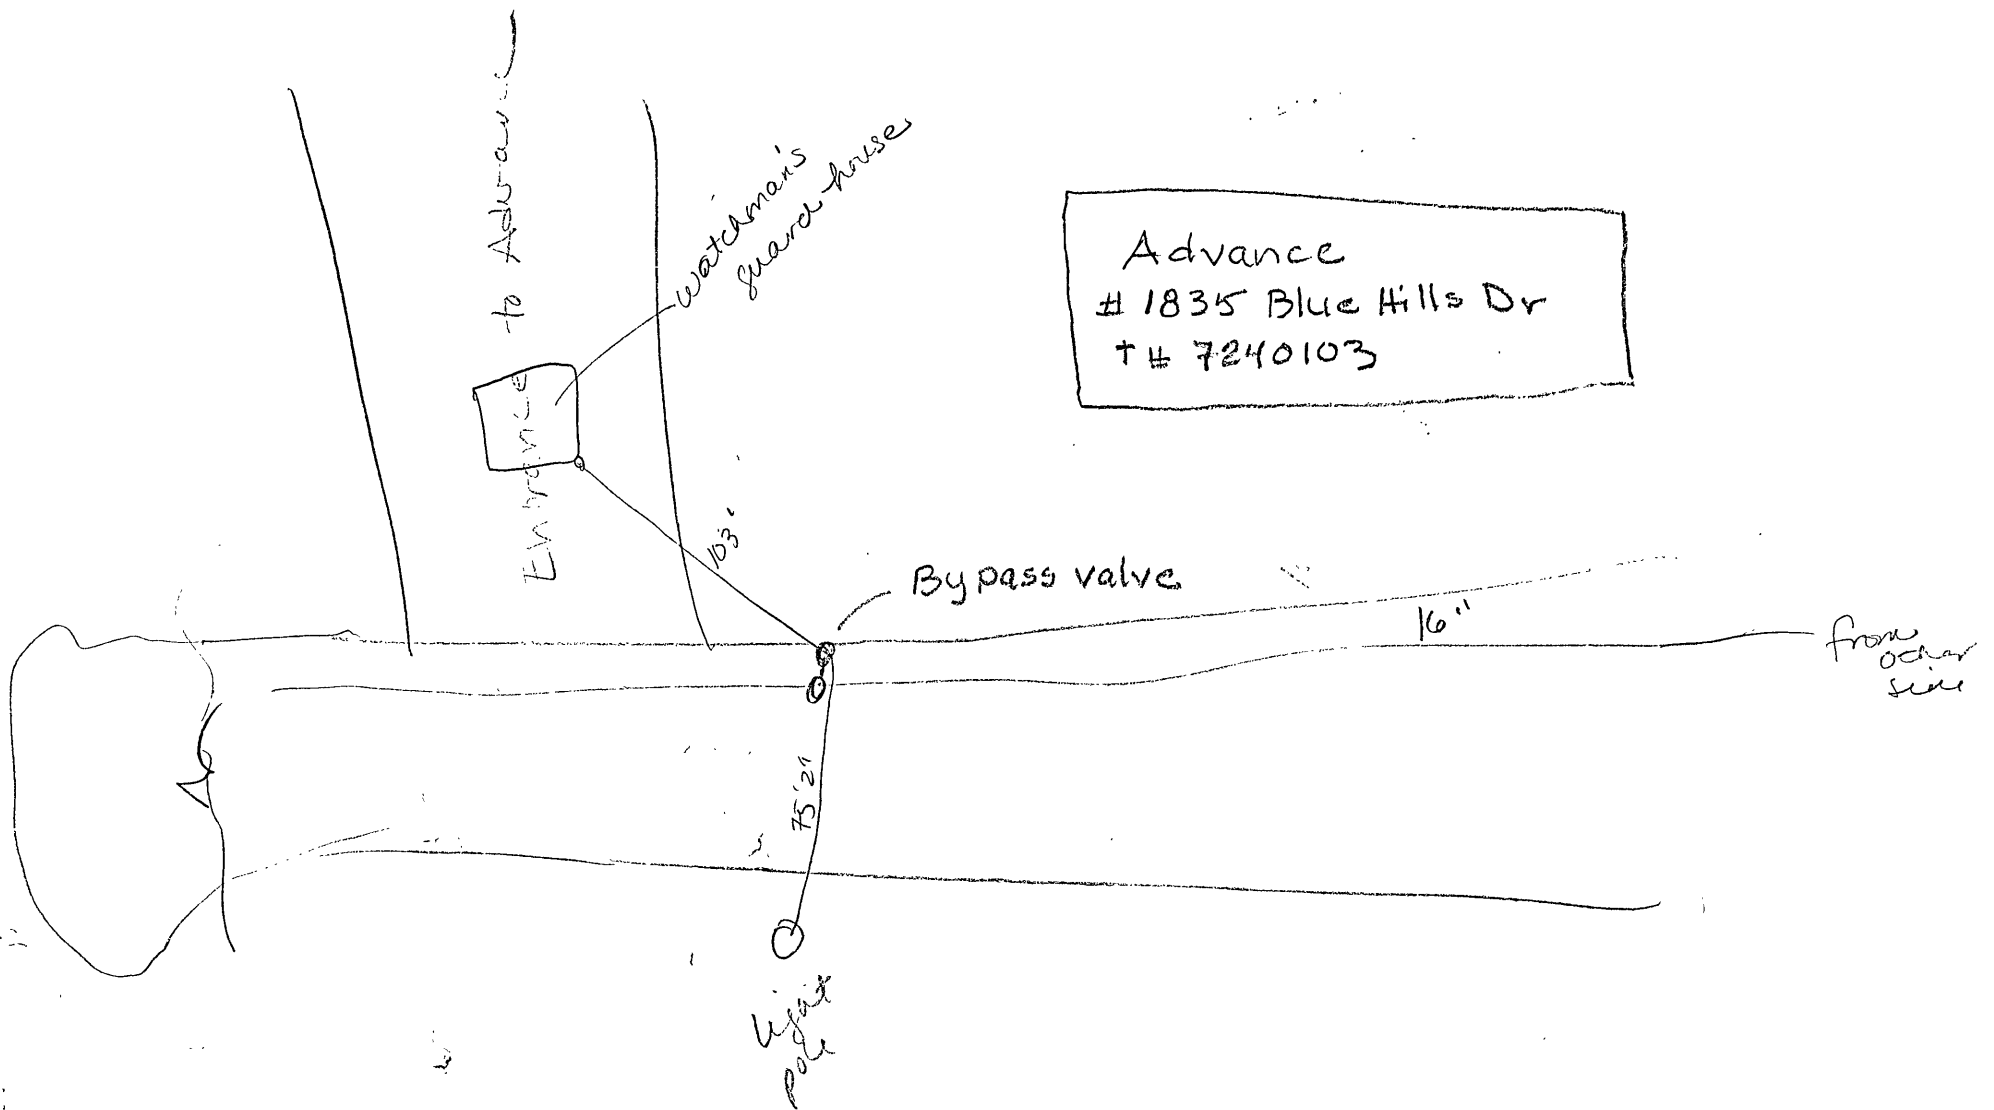

Advance
#1835 Blue Hills Dr
T# 7240103

T# 7240101
#1830 Blue Hills Dr

see sheet 8
Water Dept # 87-08

98 1