


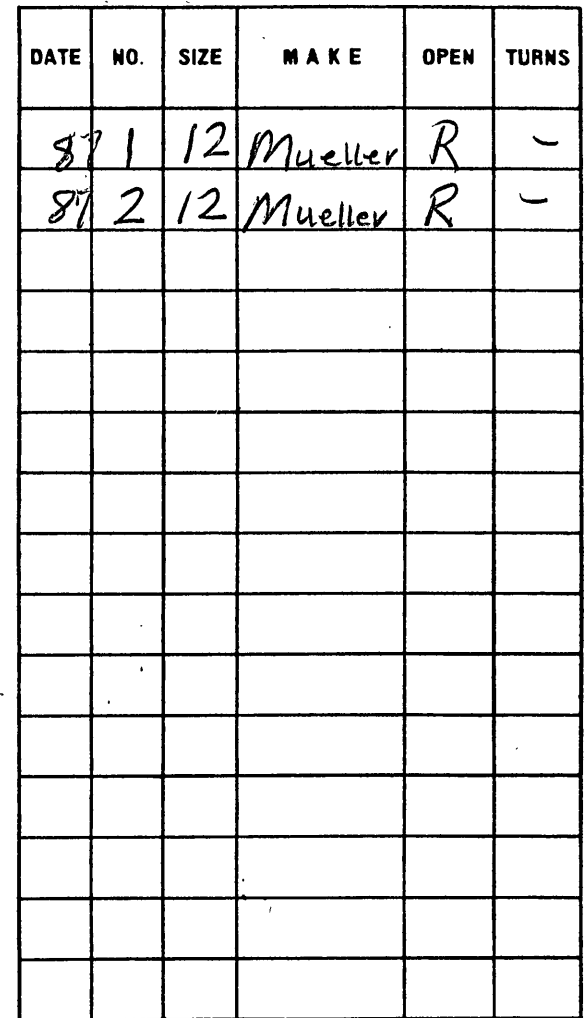

Blue Hills
Dr. —

BLUE HILLS DR, NE.
1800 Block

DATE JAN 87 PAGE NO. 82—

Water Dept's 87-09