


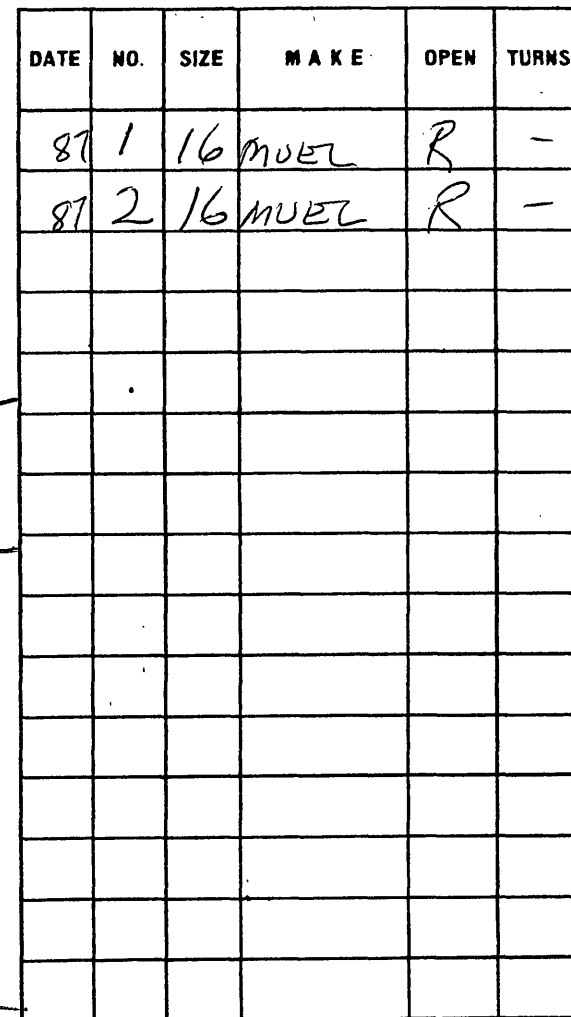

PAGE NO. 78-1