


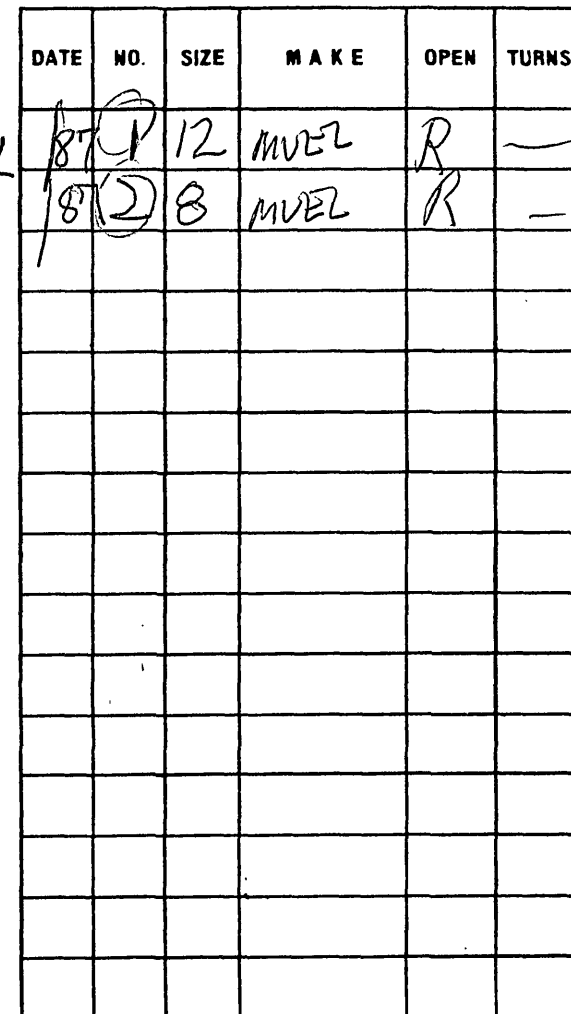

CITY OF ROANOKE—WATER DEPT	
VALVE DIAGRAM	
BLUE HILLS DR.	
#1751	
SEC. MAP	724
DATE	PAGE NO. 602