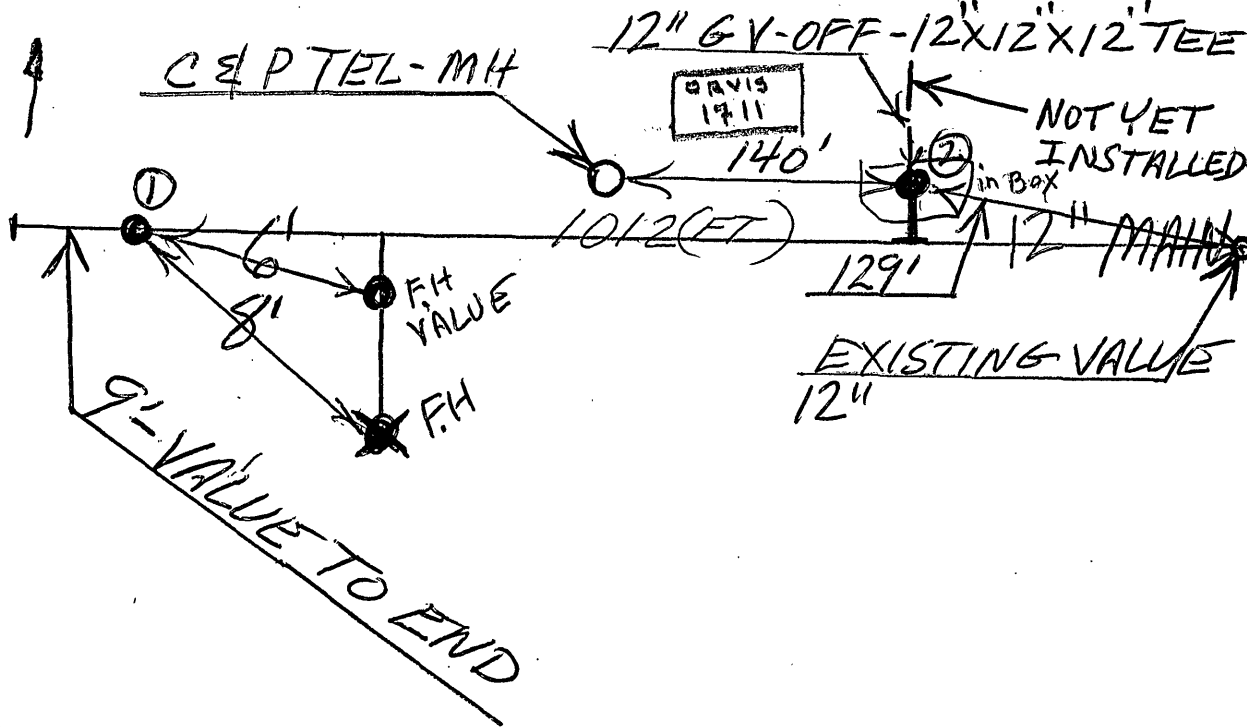


[illegible]

BLUE HILLS RD.

DATE STARTED				
DATE COMP.				
FEET MAIN	SIZE	VALVE	VAULT	BOX
1012	12	2	2	#2
F. H. COMP. 2	4 1/2	6'	2	12
F. H. STUB ONLY				
SERV. INS. BY:				
MAIN INS. BY: DAME-CITY				
NO. 3/4" SERV. INS.				
CITY OR CO.				
DEPT. INSP.				

1702
Cooper Industries

CITY OF ROANOKE—WATER DEPT	
VALVE DIAGRAM	
Blue Hills Drive, NE	
#1711	
SEC. MAP	721
DATE	PAGE NO. 59—