


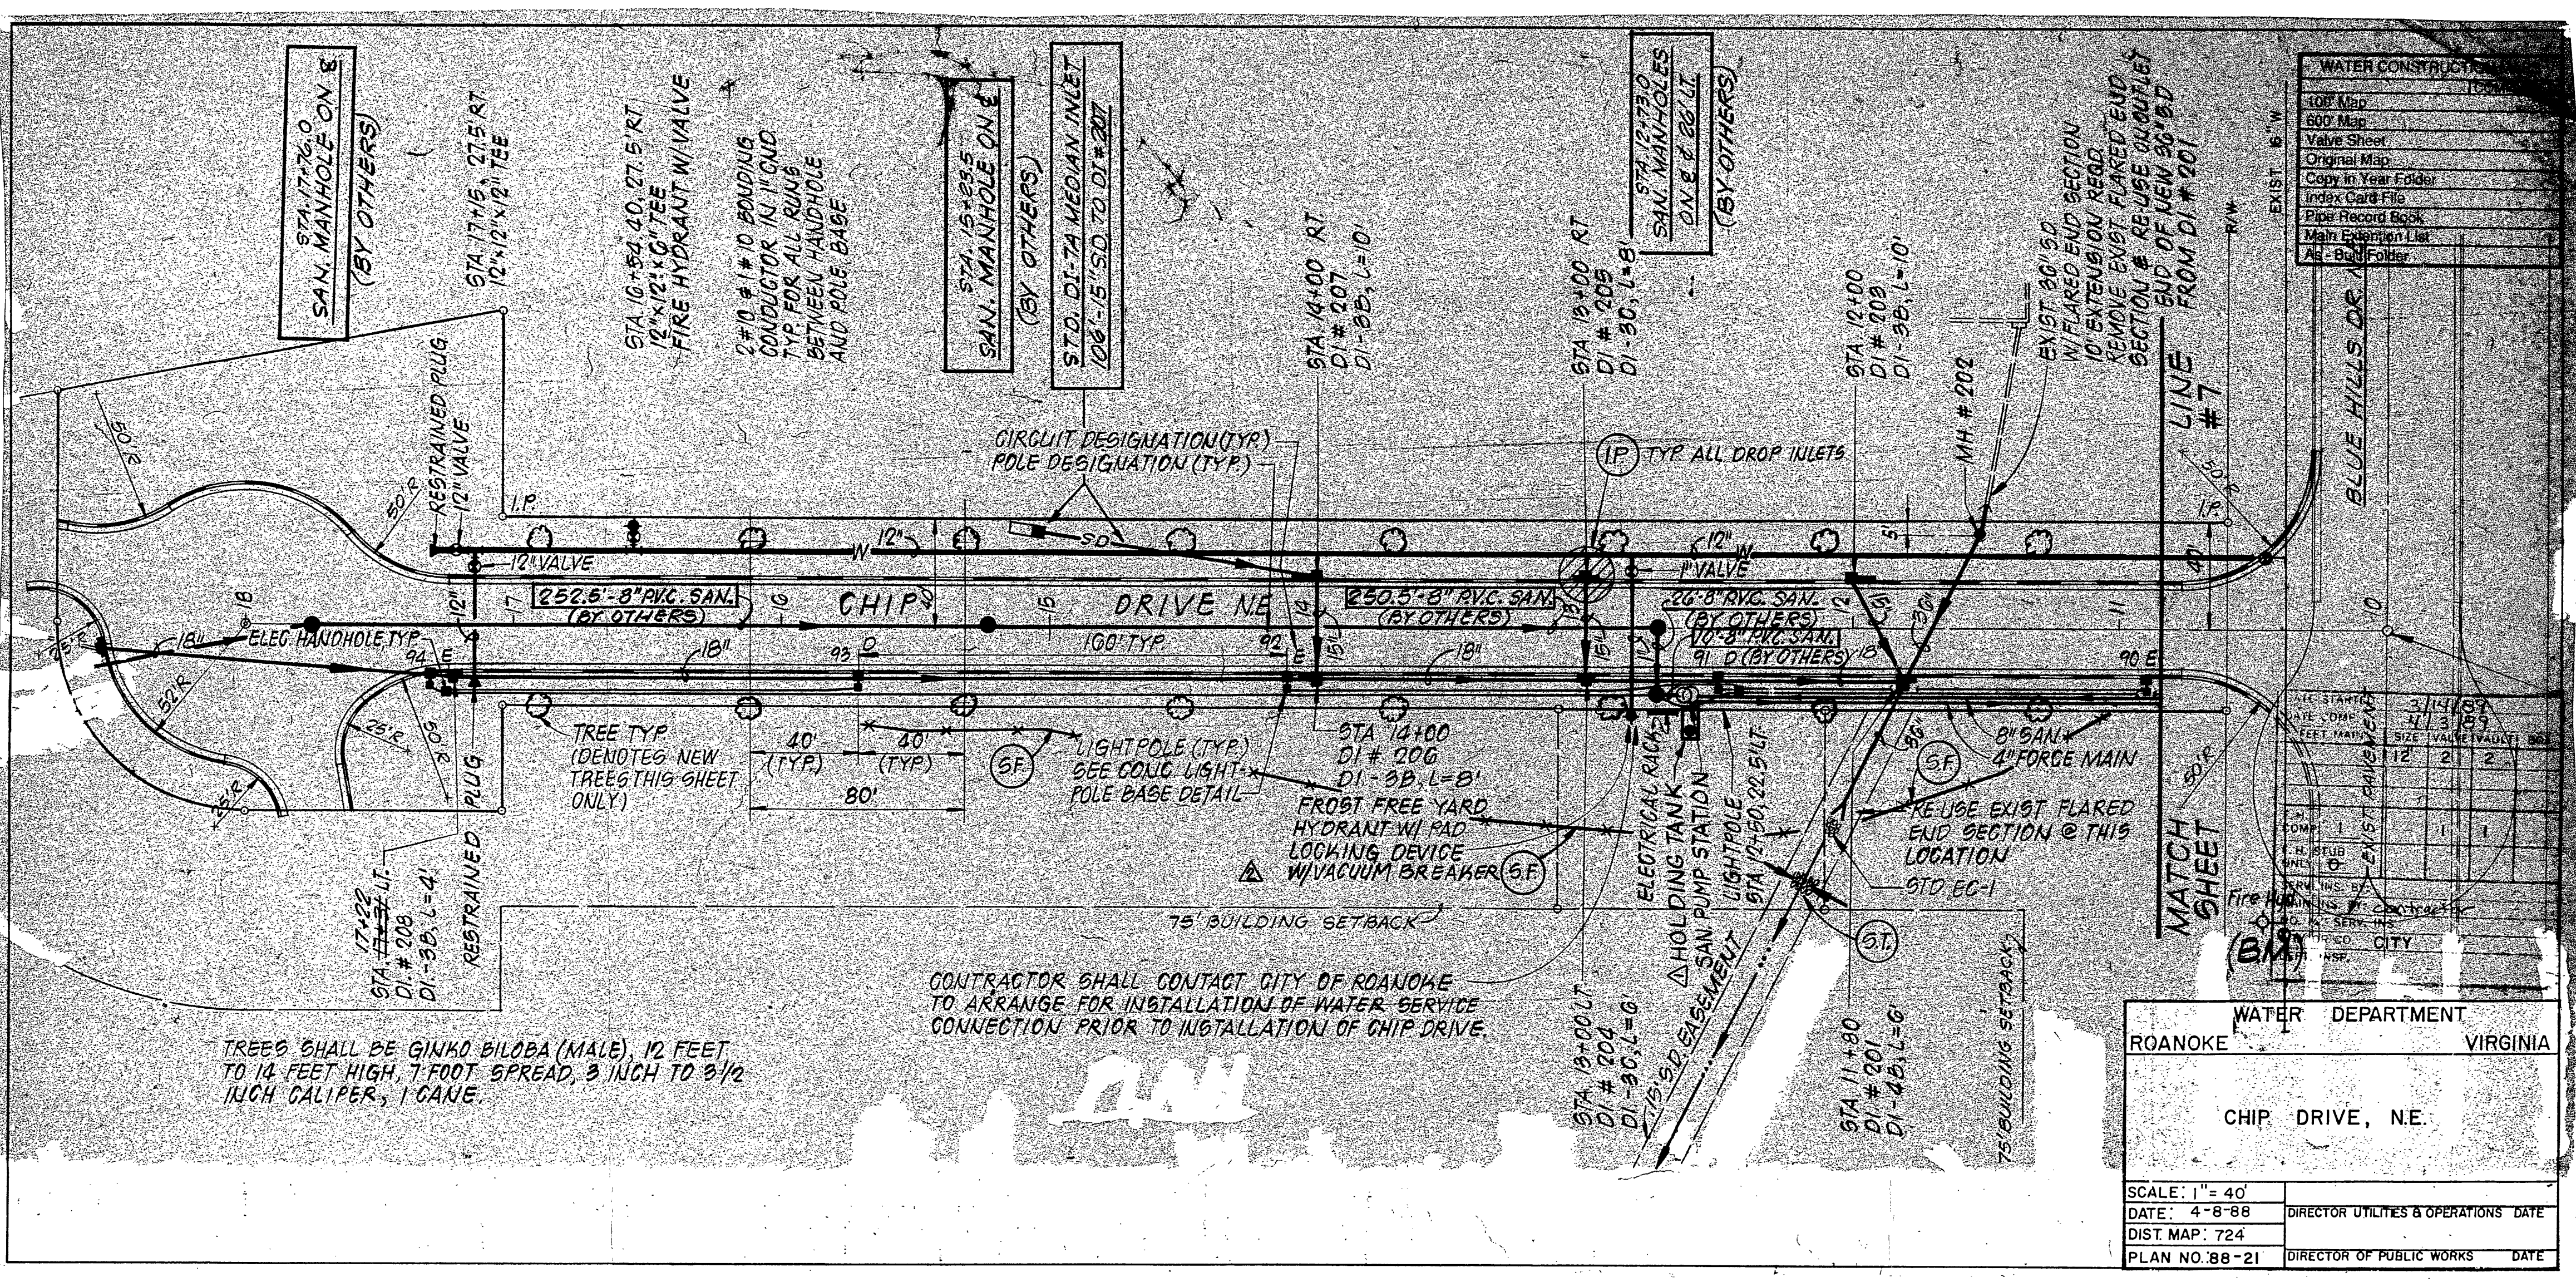

STA. 17+76.0
SAN. MANHOLE ON E
(BY OTHERS)

STA. 17+15, 27.5 RT
12"x12"x12" TEE

STA. 16+54.40, 27.5 RT
12"x12"x6" TEE
FIRE HYDRANT W/ VALVE

2#10 #1 #10 BONDING
CONDUCTOR IN 1" CND
TYP. FOR ALL RUNS
BETWEEN HANDHOLE
AND POLE BASE

STA. 15+23.5
SAN. MANHOLE ON E
(BY OTHERS)

STD. DI-TA MEDIAN INLET
106'-15" SD TO DI #207

STA. 14+00 RT
DI # 207
DI-3B, L=10'

STA. 13+00 RT
DI # 205
DI-3C, L=8'

STA. 12+73.0
SAN. MANHOLES
ON E & 26' LT
(BY OTHERS)

STA. 12+00
DI # 203
DI-3B, L=10'

EXIST 20' SD
W/ FLARED END SECTION
10' EXTENSION REQD
REMOVE EXIST FLARED END
SECTION & RE-USE OUTLET
END OF NEW 20' SD
FROM DI # 201

LINE #7

WATER CONSTRUCTION	
100' Map	100'
600' Map	600'
Valve Sheet	
Original Map	
Copy in Year Folder	
Index Card File	
Pipe Record Book	
Main Extension List	
As-Built Folder	

DATE STARTED	3/14/89
DATE COMP	4/3/89
FEET MAIN	12
SIZE	12"
VALVE	2
VAULT	2
COMP	1
STUB	1
ONLY	0
REPAIRS	0
INS BY	
CONTRACT	
SERV. BY	
CITY	
INS.	

WATER DEPARTMENT
ROANOKE VIRGINIA

CHIP DRIVE, N.E.

SCALE: 1" = 40'	DIRECTOR UTILITIES & OPERATIONS	DATE
DATE: 4-8-88		
DIST. MAP: 724		
PLAN NO. 88-21	DIRECTOR OF PUBLIC WORKS	DATE