


ABBREVIATIONS

SEE SHEET 3

LEGEND

SEE SHEET 3

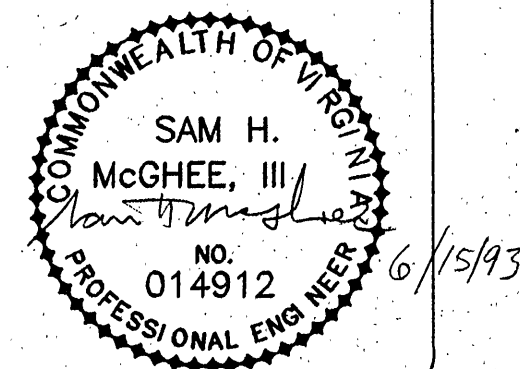

SUMMARY OF QUANTITIES

ITEM	UNIT	QUANTITY	
		ACTUAL	PROPOSAL
PHASE I			
1. MOBILIZATION	LS	1	1
2. EARTHWORK	LS	1	1
3. 15" RCP STORM DRAIN	LF	1000	1100
4. 18" RCP STORM DRAIN	LF	275	310
5. 24" RCP STORM DRAIN	LF	375	415
6. CURB DROP INLET DI 3C, L = 10	EA	2	2
7. CURB DROP INLET DI 3B, L = 14	EA	1	1
8. CURB DROP INLET DI 3B, L = 12	EA	2	2
9. CURB DROP INLET DI 3B, L = 10	EA	3	3
10. CURB DROP INLET DI 3B, L = 8	EA	2	2
11. CURB DROP INLET DI 3B, L = 6	EA	3	3
12. STORM DRAIN MANHOLE	VF	126	140
13. STORM DRAIN RISER	VF	4	5
14. 16" DUCTILE IRON WATERLINE	LF	1312, 1099	1210
15. 16" GATE VALVE	EA	149, 100	1
16. 8" DUCTILE IRON WATERLINE	LF	50	60
17. 8" GATE VALVE	EA	1	1
18. FIRE HYDRANT ASSEMBLY	EA	2	2
19. CONCRETE CURB & GUTTER	LF	1958	2170
20. EROSION CONTROL STONE, STD EC-1, TYPE A	CY	5	10
21. TRENCH STABILIZATION MATERIAL	TONS	23	25
22. AGGREGATE BASE MATL., TYPE I, SIZE 21 OR 21A	TONS	3366	3700
23. ASPHALT CONC BASE MATL., TYPE BM-2	TONS	1645	1810
24. ASPHALT CONC SURFACE MATL., TYPE SM-2A	TONS	411	452
25. SANITARY SEWER MANHOLE FRAME & COVER	EA	8	9
26. SANITARY SEWER MANHOLE	VF	140	155
27. 8" DUCTILE IRON SANITARY SEWER	LF	1533	1690
28. 5" SCHEDULE 40 PVC EMPTY CONDUIT	LF	150	170
29. WIRE AND CONDUIT FOR LIGHTING	LF	2063	2270
30. LIGHT POLE BASES	EA	12	13
31. LIGHTING HANDHOLES	EA	3	3
32. FIELD STAKEOUT	LS	1	1
PHASE II			
33. TREES, GINKO BILOBA (MALE)	EA	48	50
34. TREES, PIN OAK	EA	9	9
35. TREES, RED BUCKEYE	EA	4	4
36. TREES, SOURWOOD	EA	5	5
37. TREES, WHITE PINE	EA	39	39
38. TREES, X CUPRESSOCYPARIS LEYLANDII	EA	48	48
39. SHRUB, ELEAGNUS PUNGENS	EA	73	73
40. SHRUB, LONICERA FRAGRANTISSMA	EA	12	12
41. LIGHTING POLES AND LUMINAIRES	EA	12	13
42. CONCRETE CURB & GUTTER	LF	2392	2630
43. AGGREGATE BASE MATL., TYPE I, SIZE 21 OR 21A	TONS	1907	2100
44. ASPHALT CONC BASE MATL., TYPE BM-2	TONS	1614	1790
45. ASPHALT CONC SURFACE MATL., TYPE SM-2A	TONS	381	425
46. AS-BUILT DRAWINGS	LS	1	1

PROJECT NUMBER 6242

SHEET NUMBER 2 OF 17