




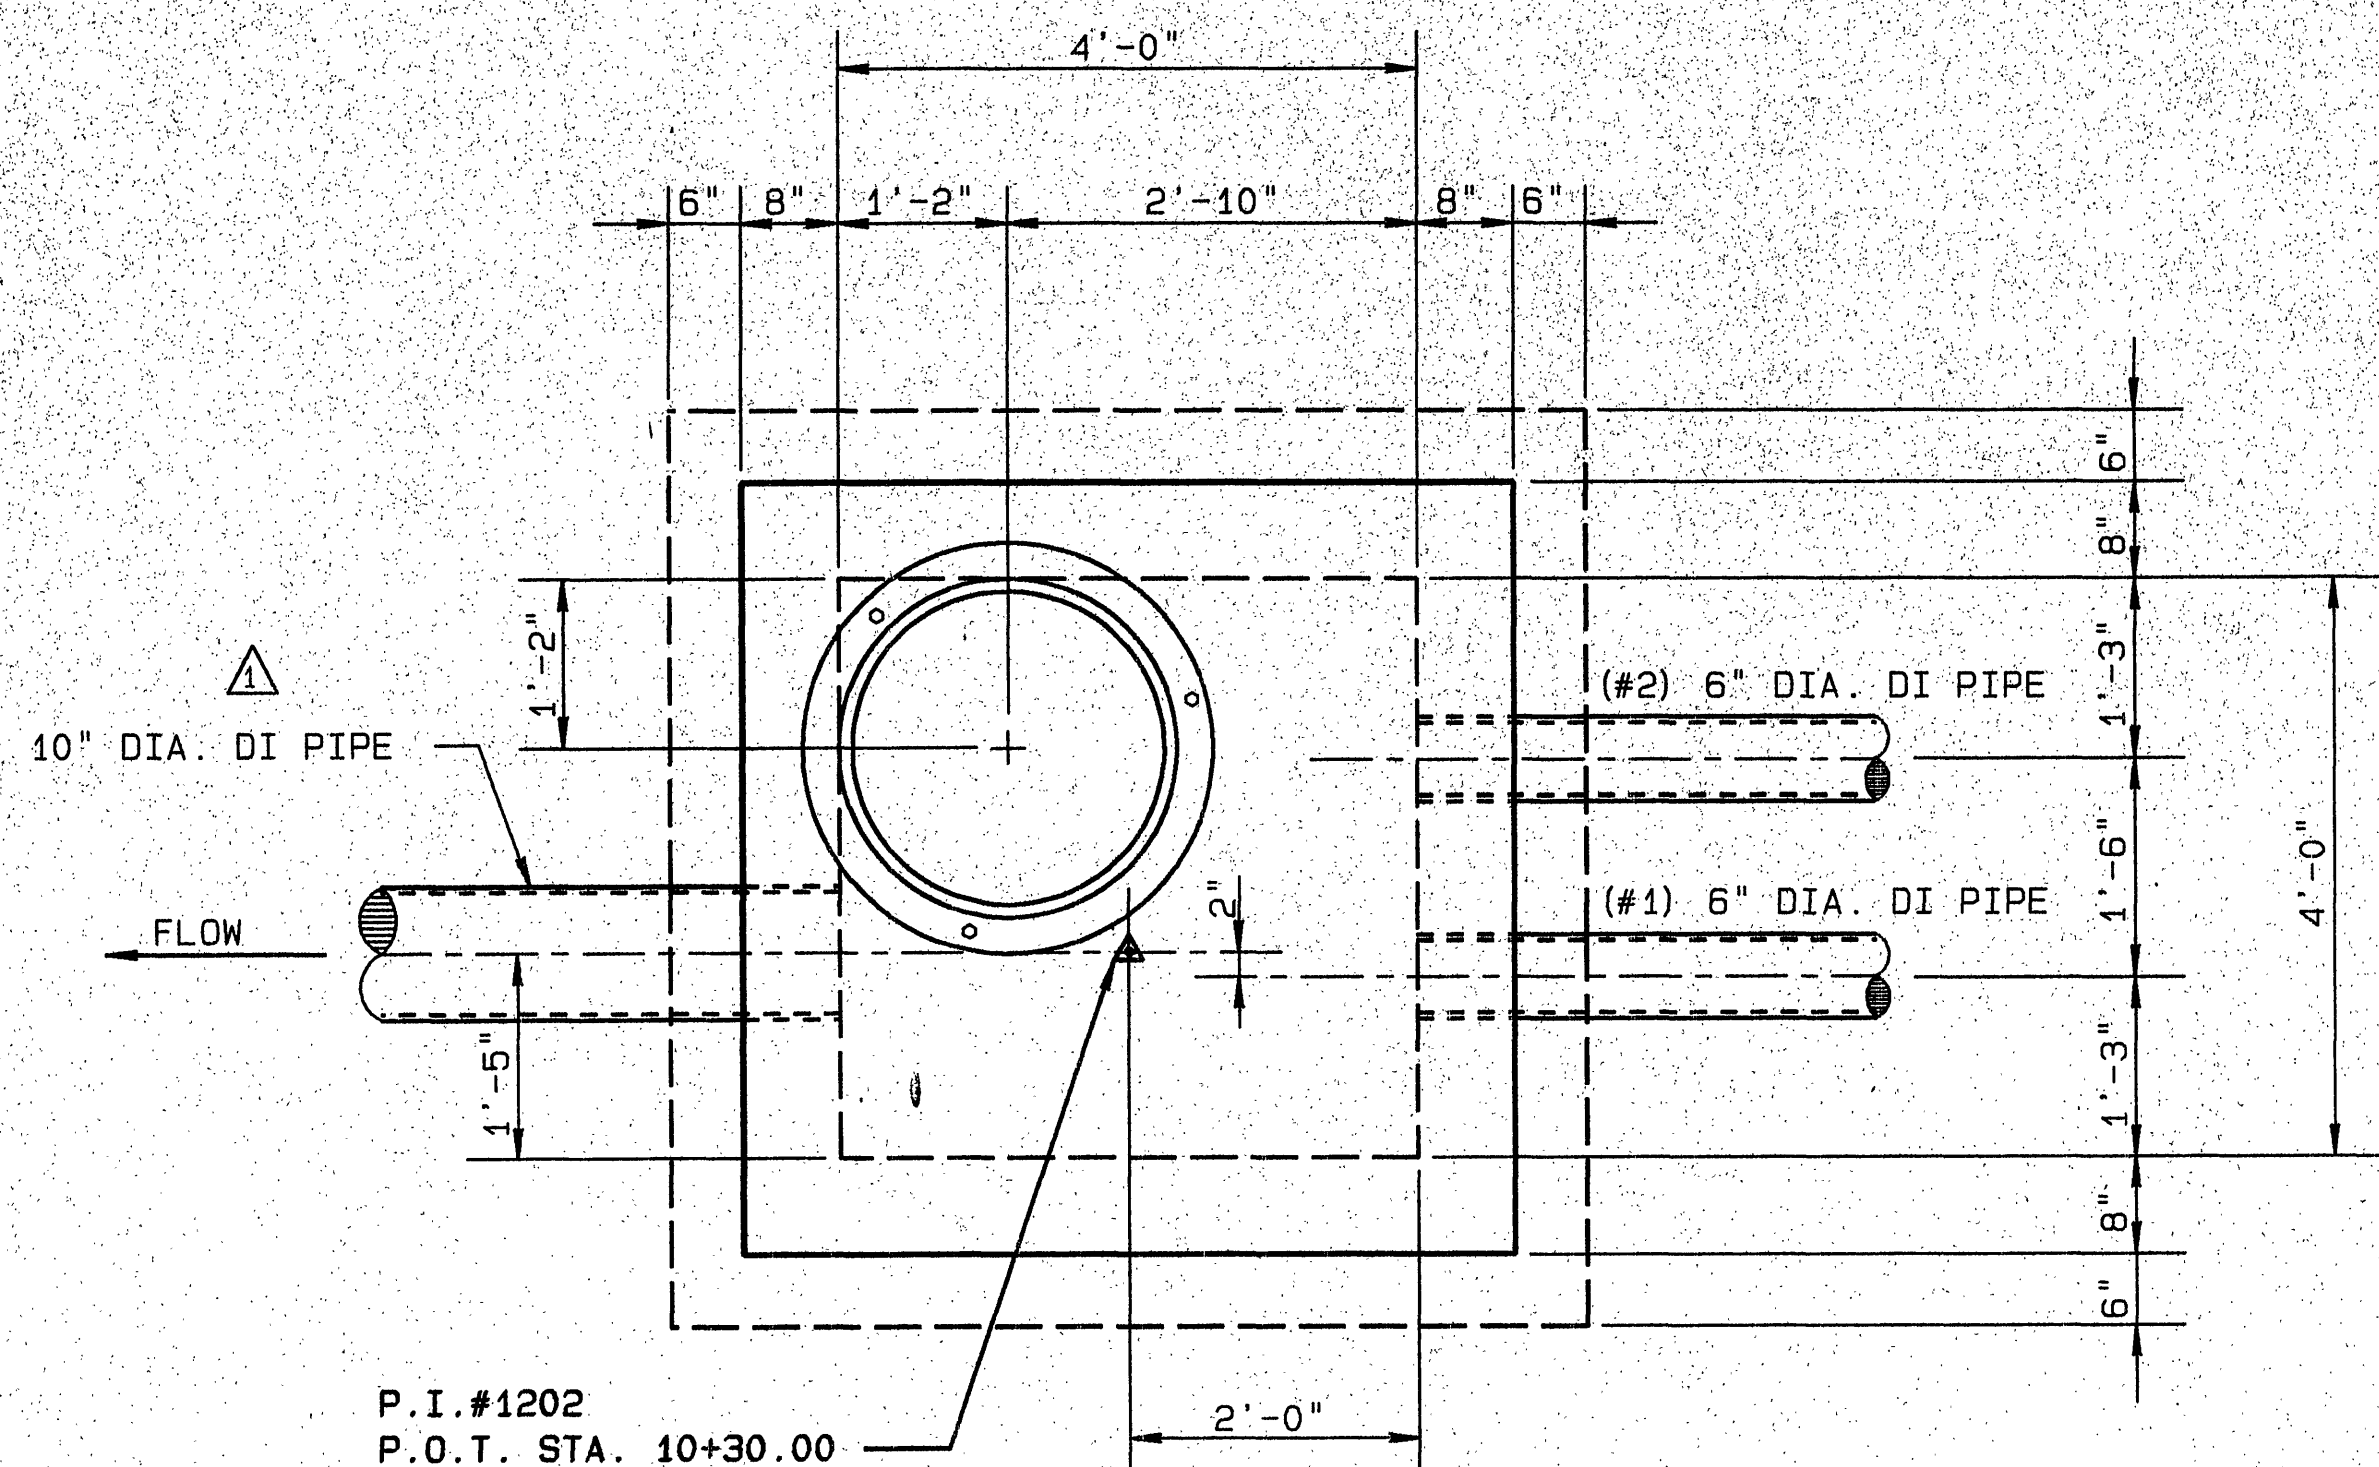


PLAN- INVERTED SIPHON OUTLET CHAMBER

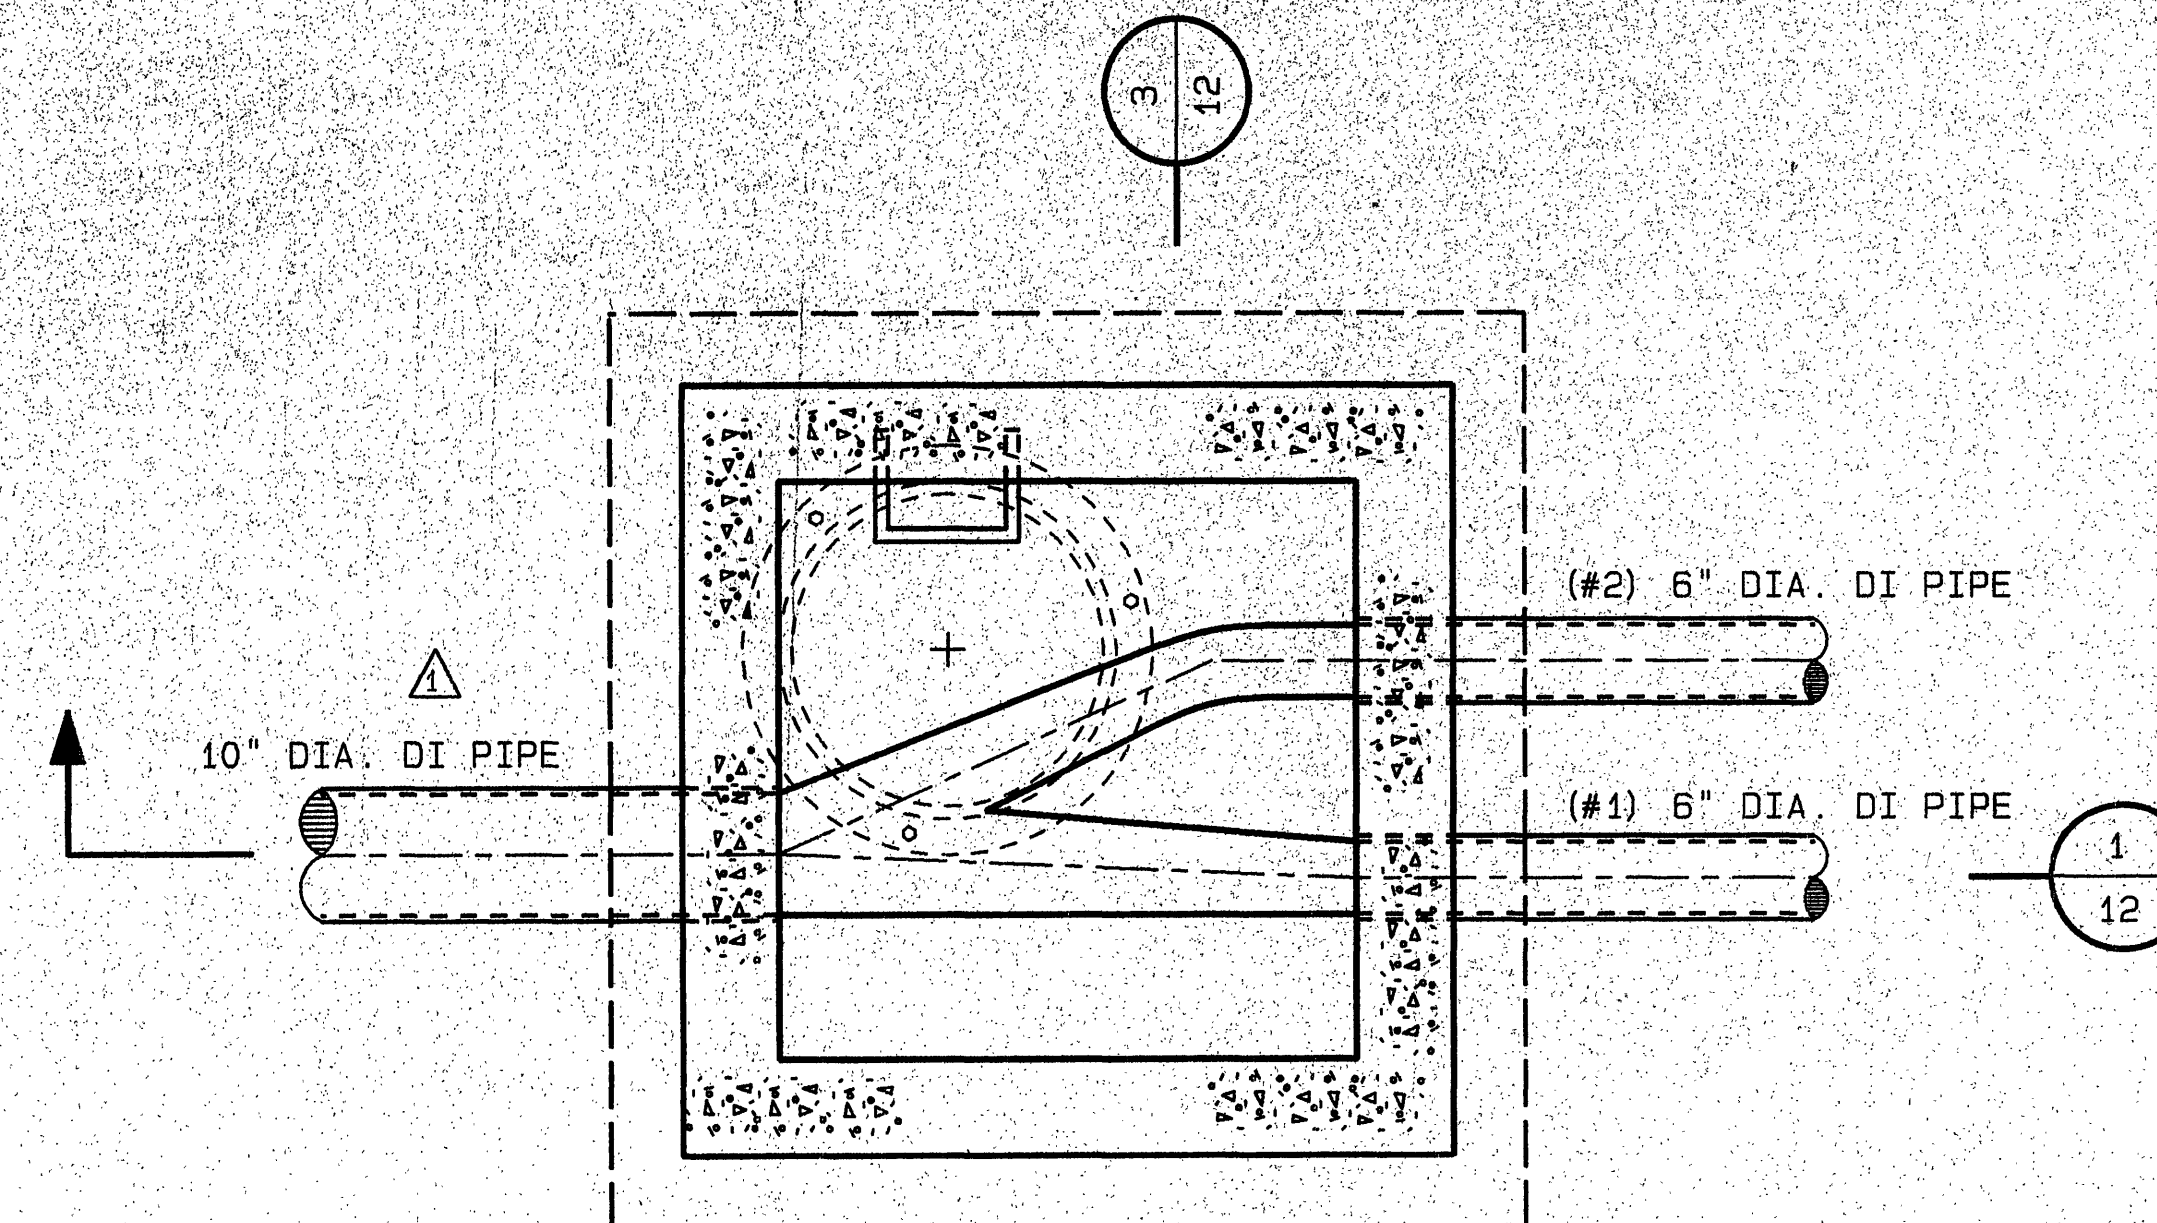


SECTION

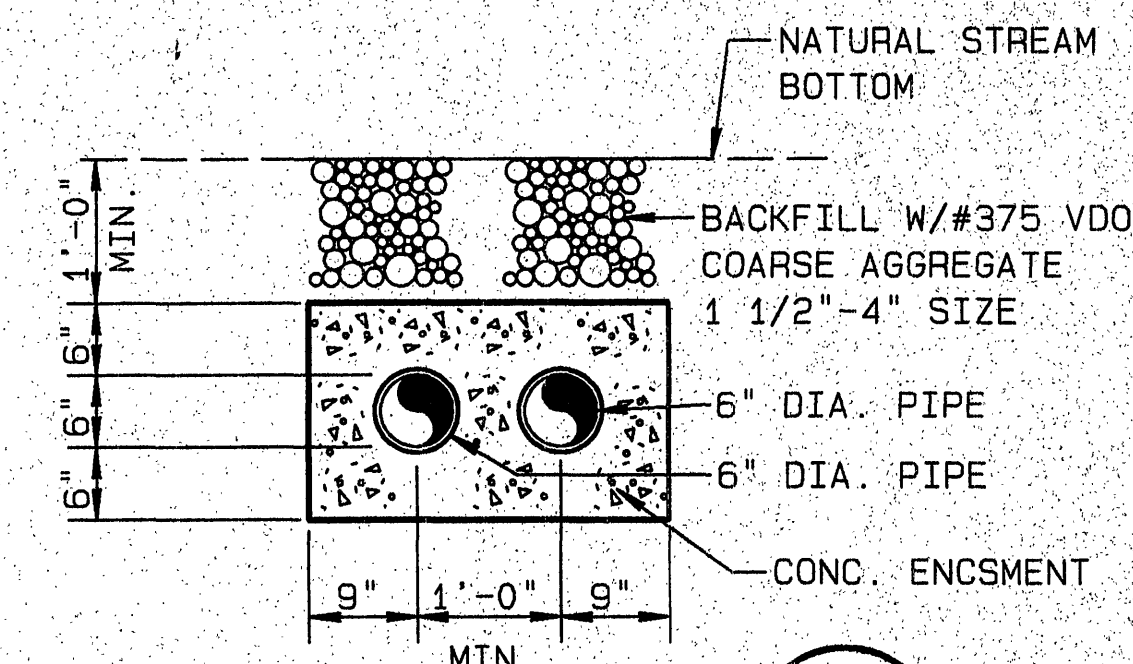


SECTION

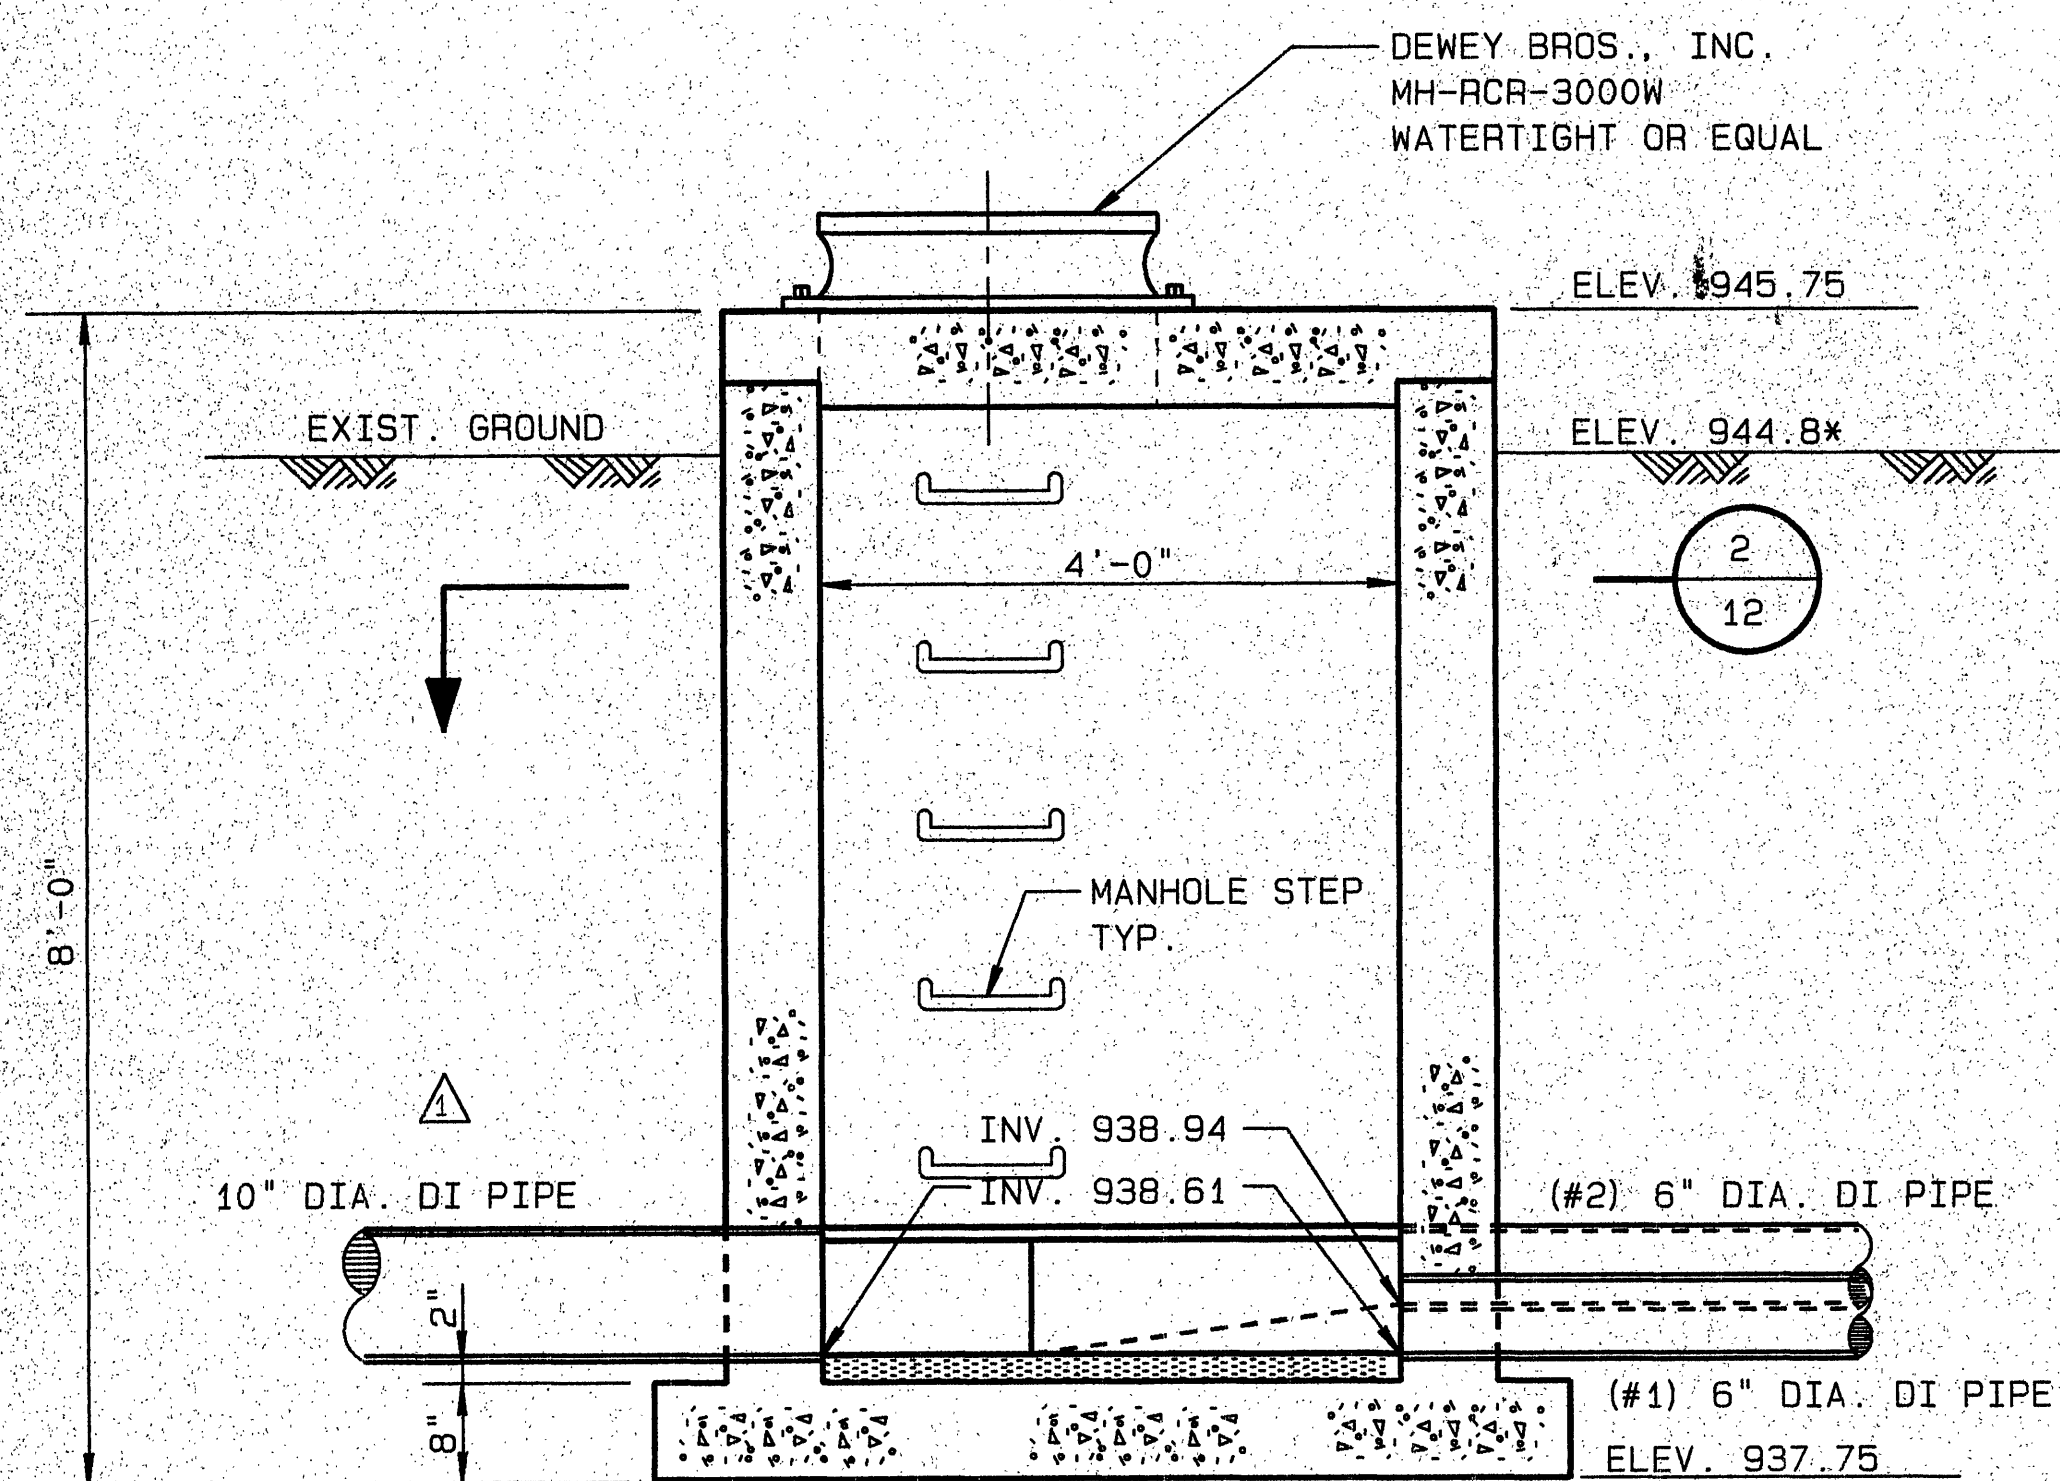

SECTION

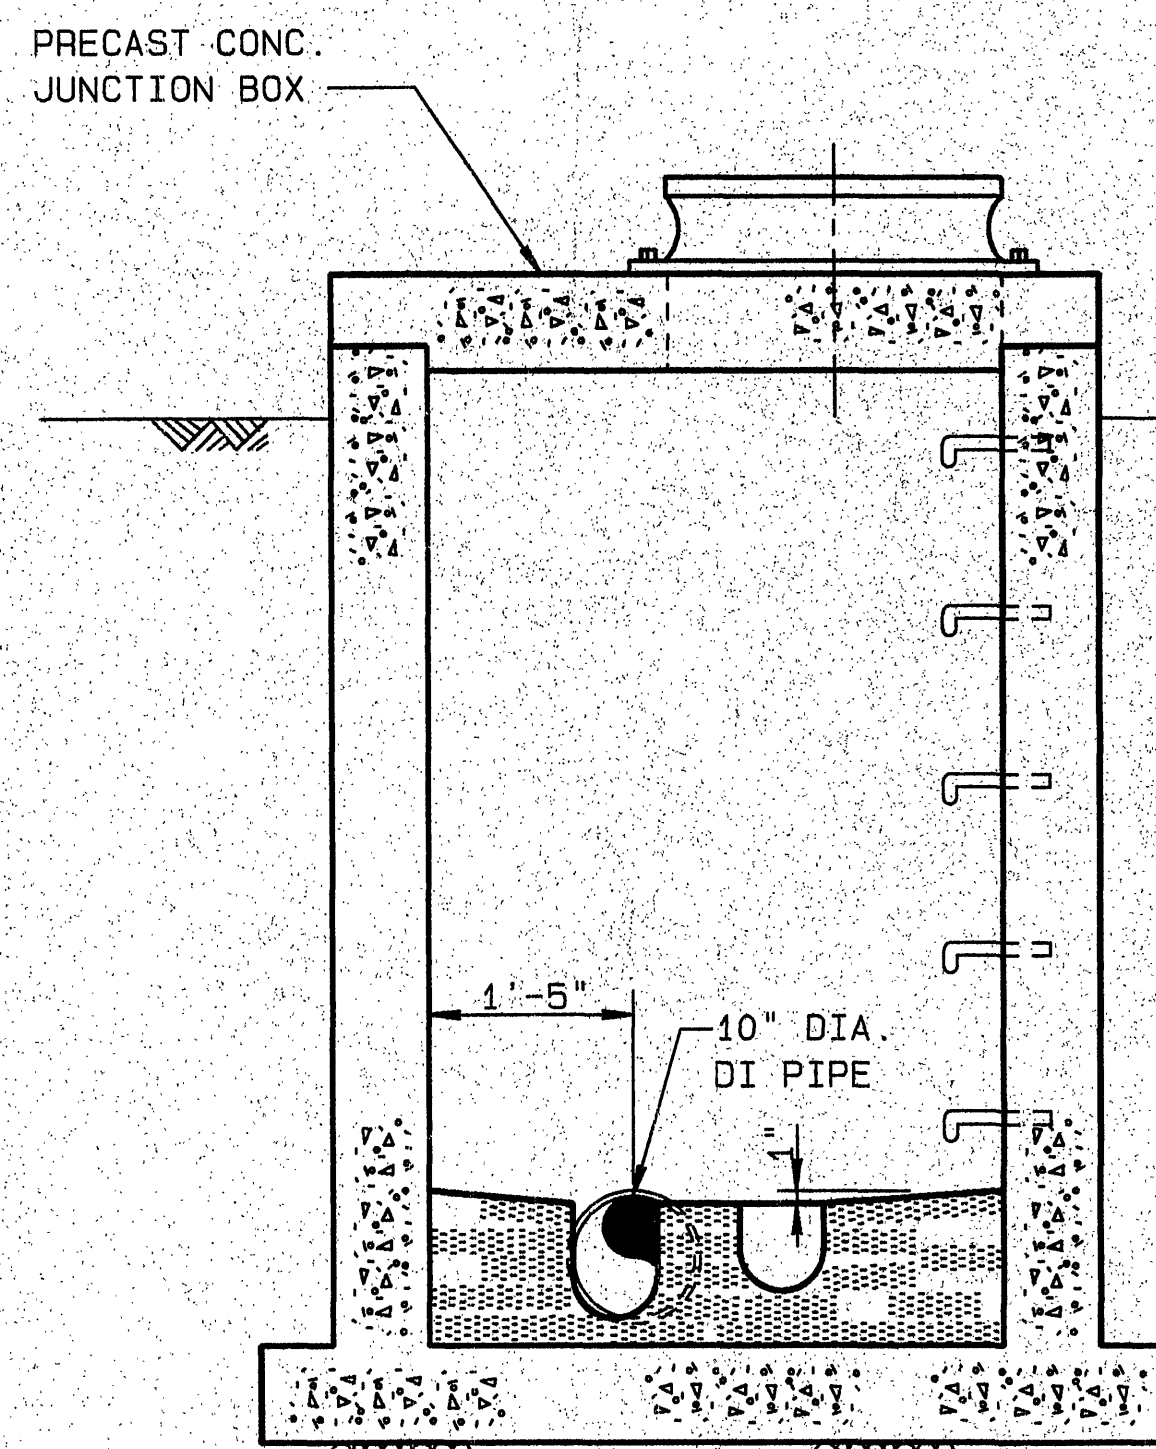

SECTION

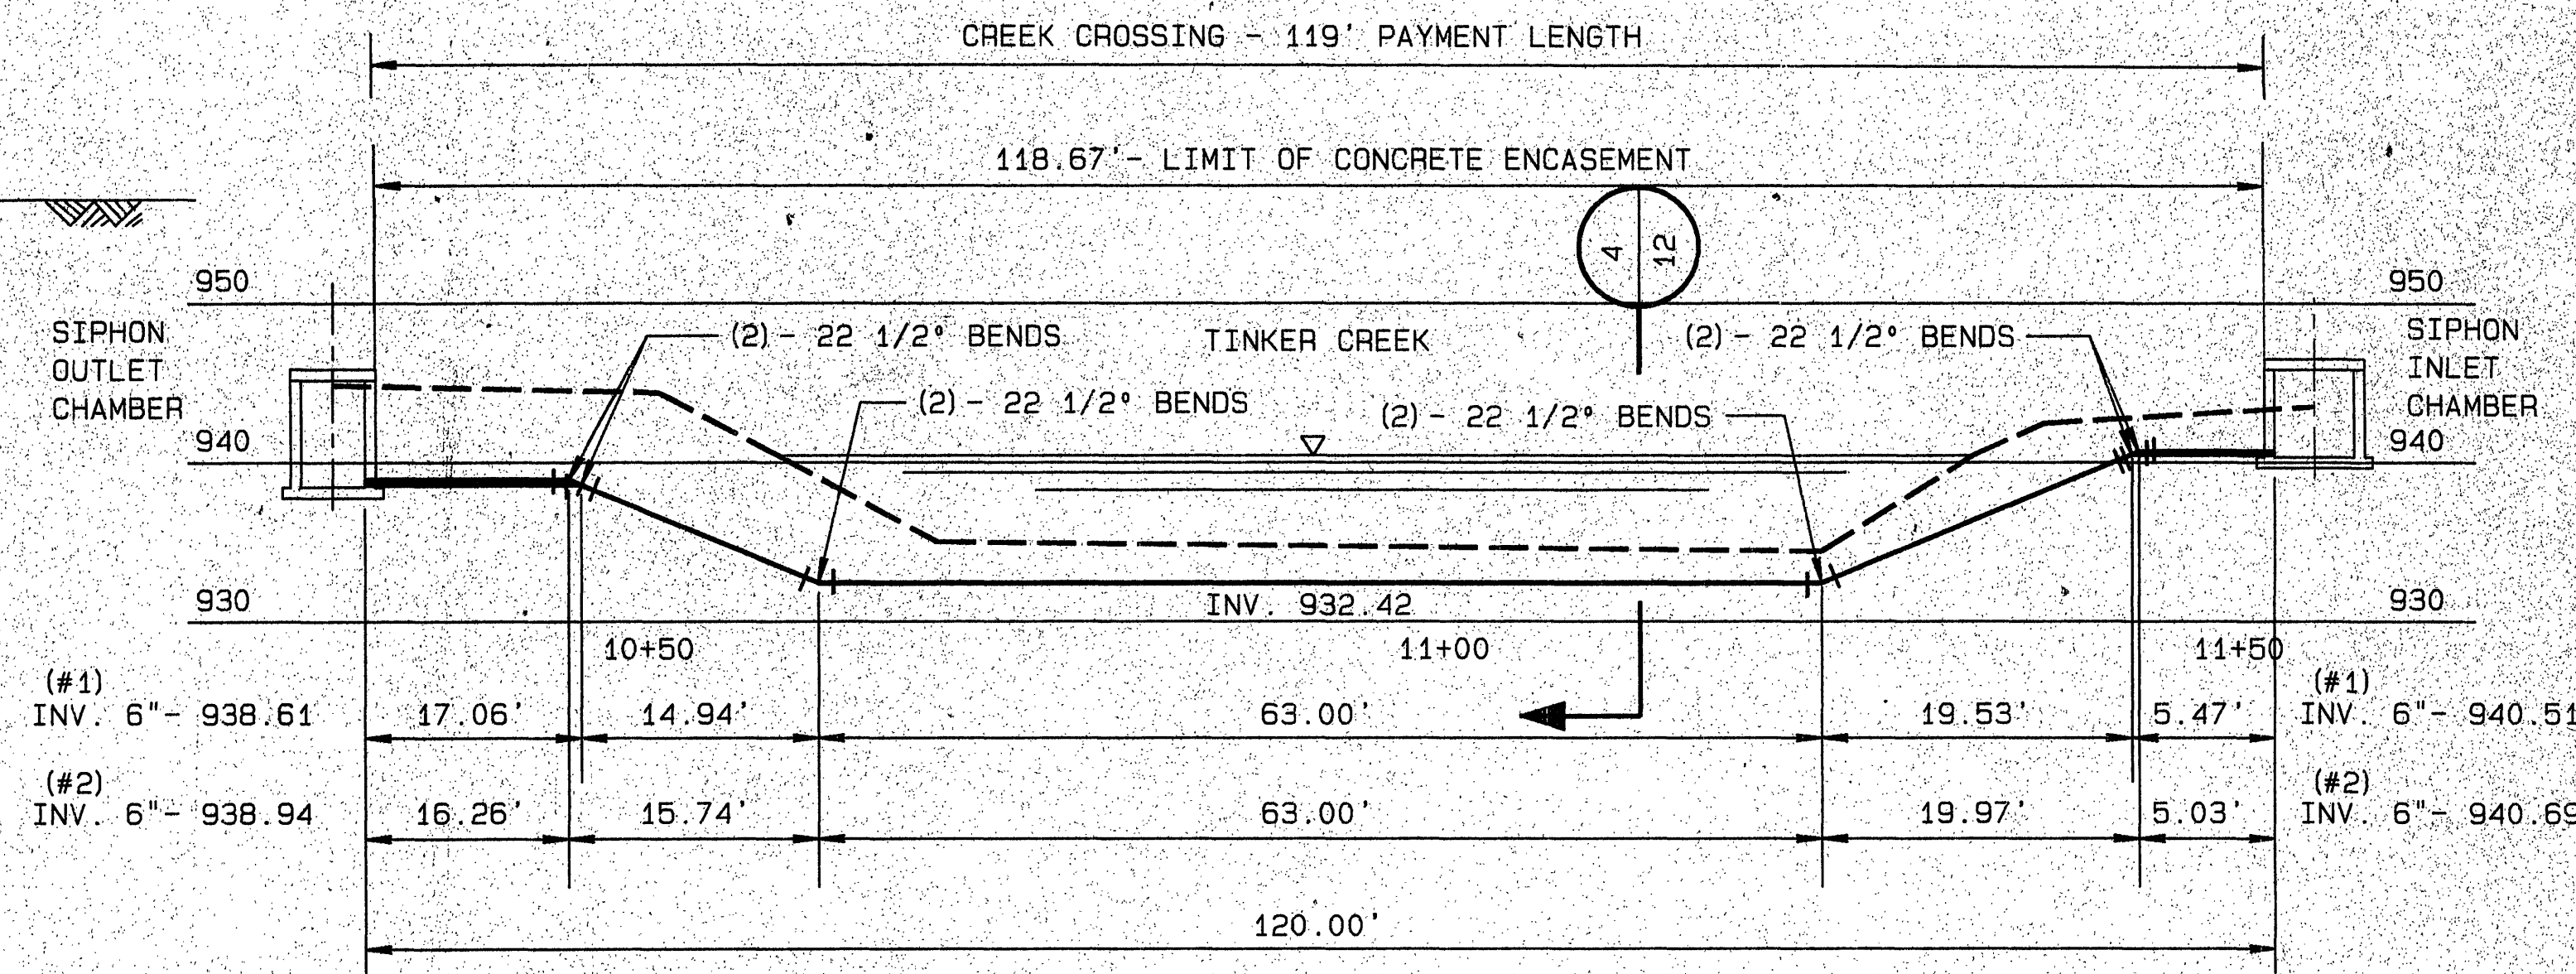


INVERTED SIPHON PIPE LOCATION

SCALE: 1"= 10' HORZ.
1"= 10' VERT.

RECORD DRAWING



DESIGNED: JMB
DRAWN: ARB
APPROVED: SHM

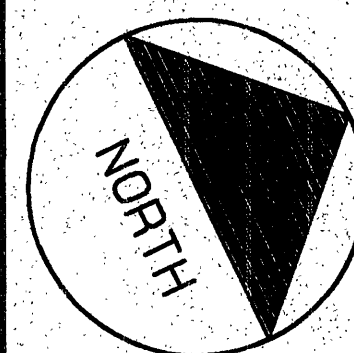

REVISION	DATE	DESCRIPTION	BY	APP.
1	5-17-94	CHANGE PVC PIPE TO DI PIPE	DSG	WJJ

DATE
JUNE
1992
COMM.
1165B

SANITARY SEWER EXTENSION
ROANOKE CENTRE FOR INDUSTRY & TECHNOLOGY
INVERTED SIPHON OUTLET CHAMBER DETAILS
CITY OF ROANOKE, VIRGINIA

SCALE: 3/4"= 1'-0"

SHEET
12
PLAN NO.
6209

DTM2-D-1165B-12