




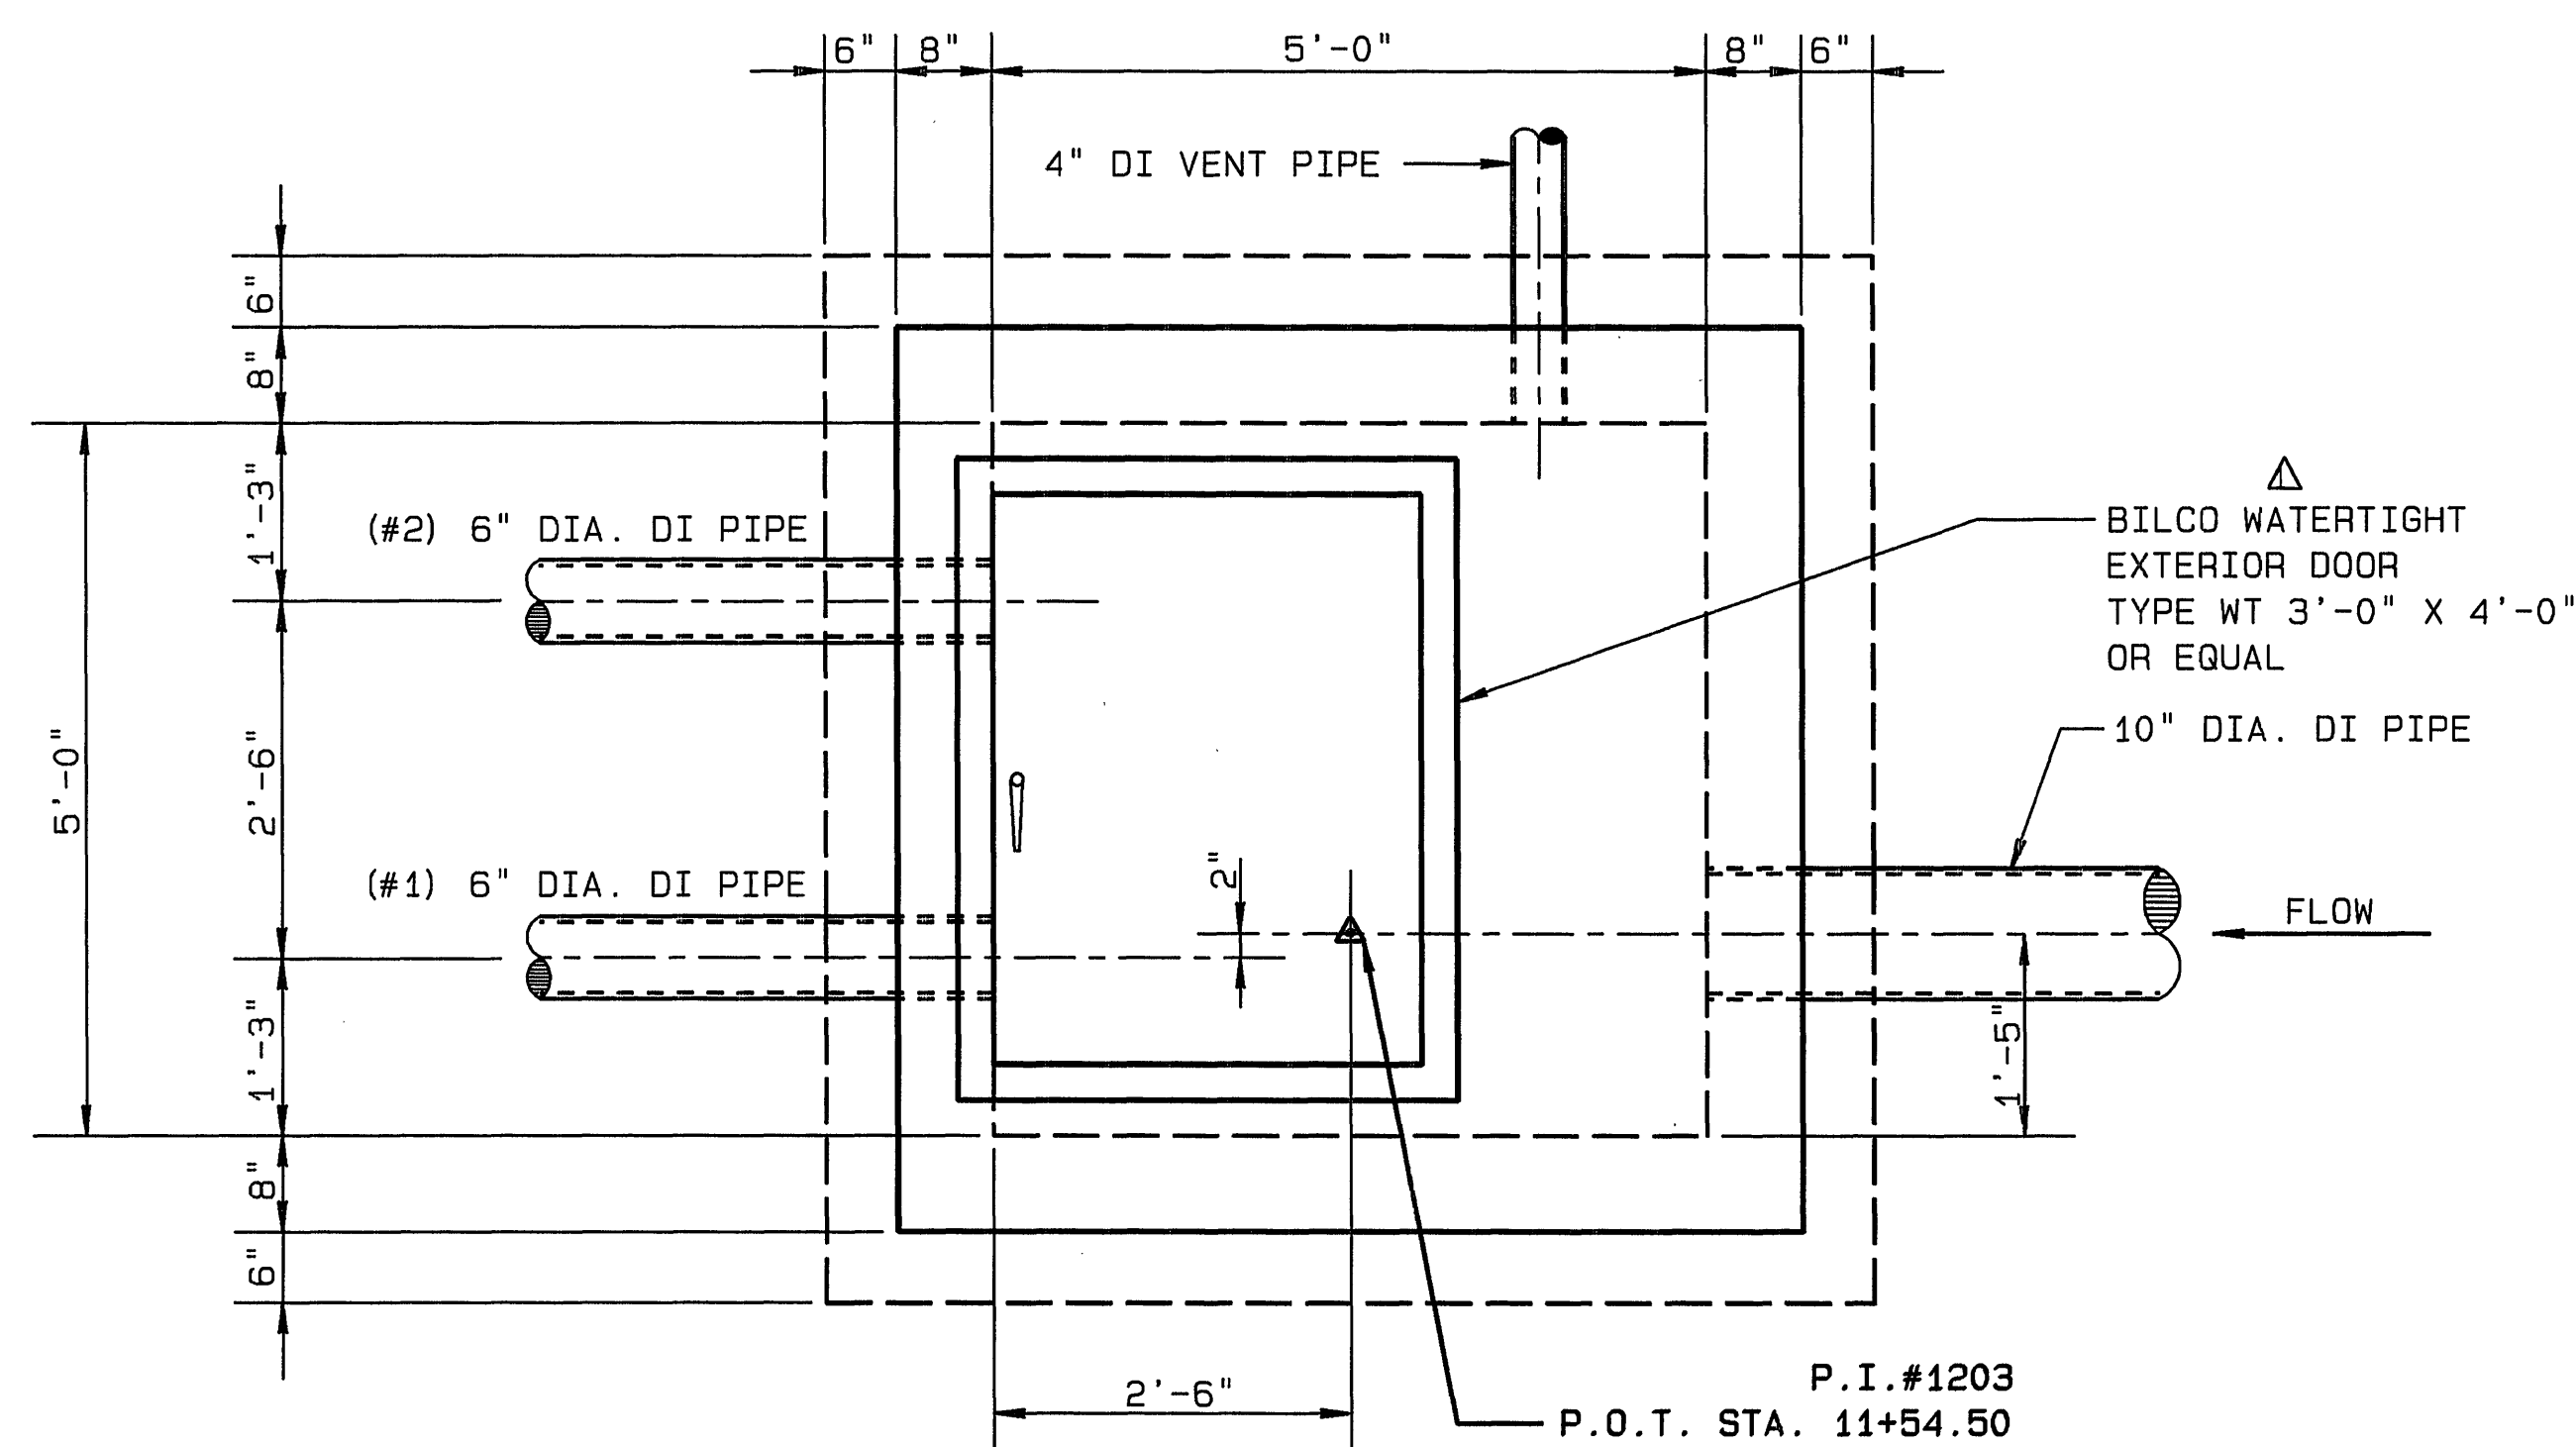


PLAN- INVERTED SIPHON INLET CHAMBER

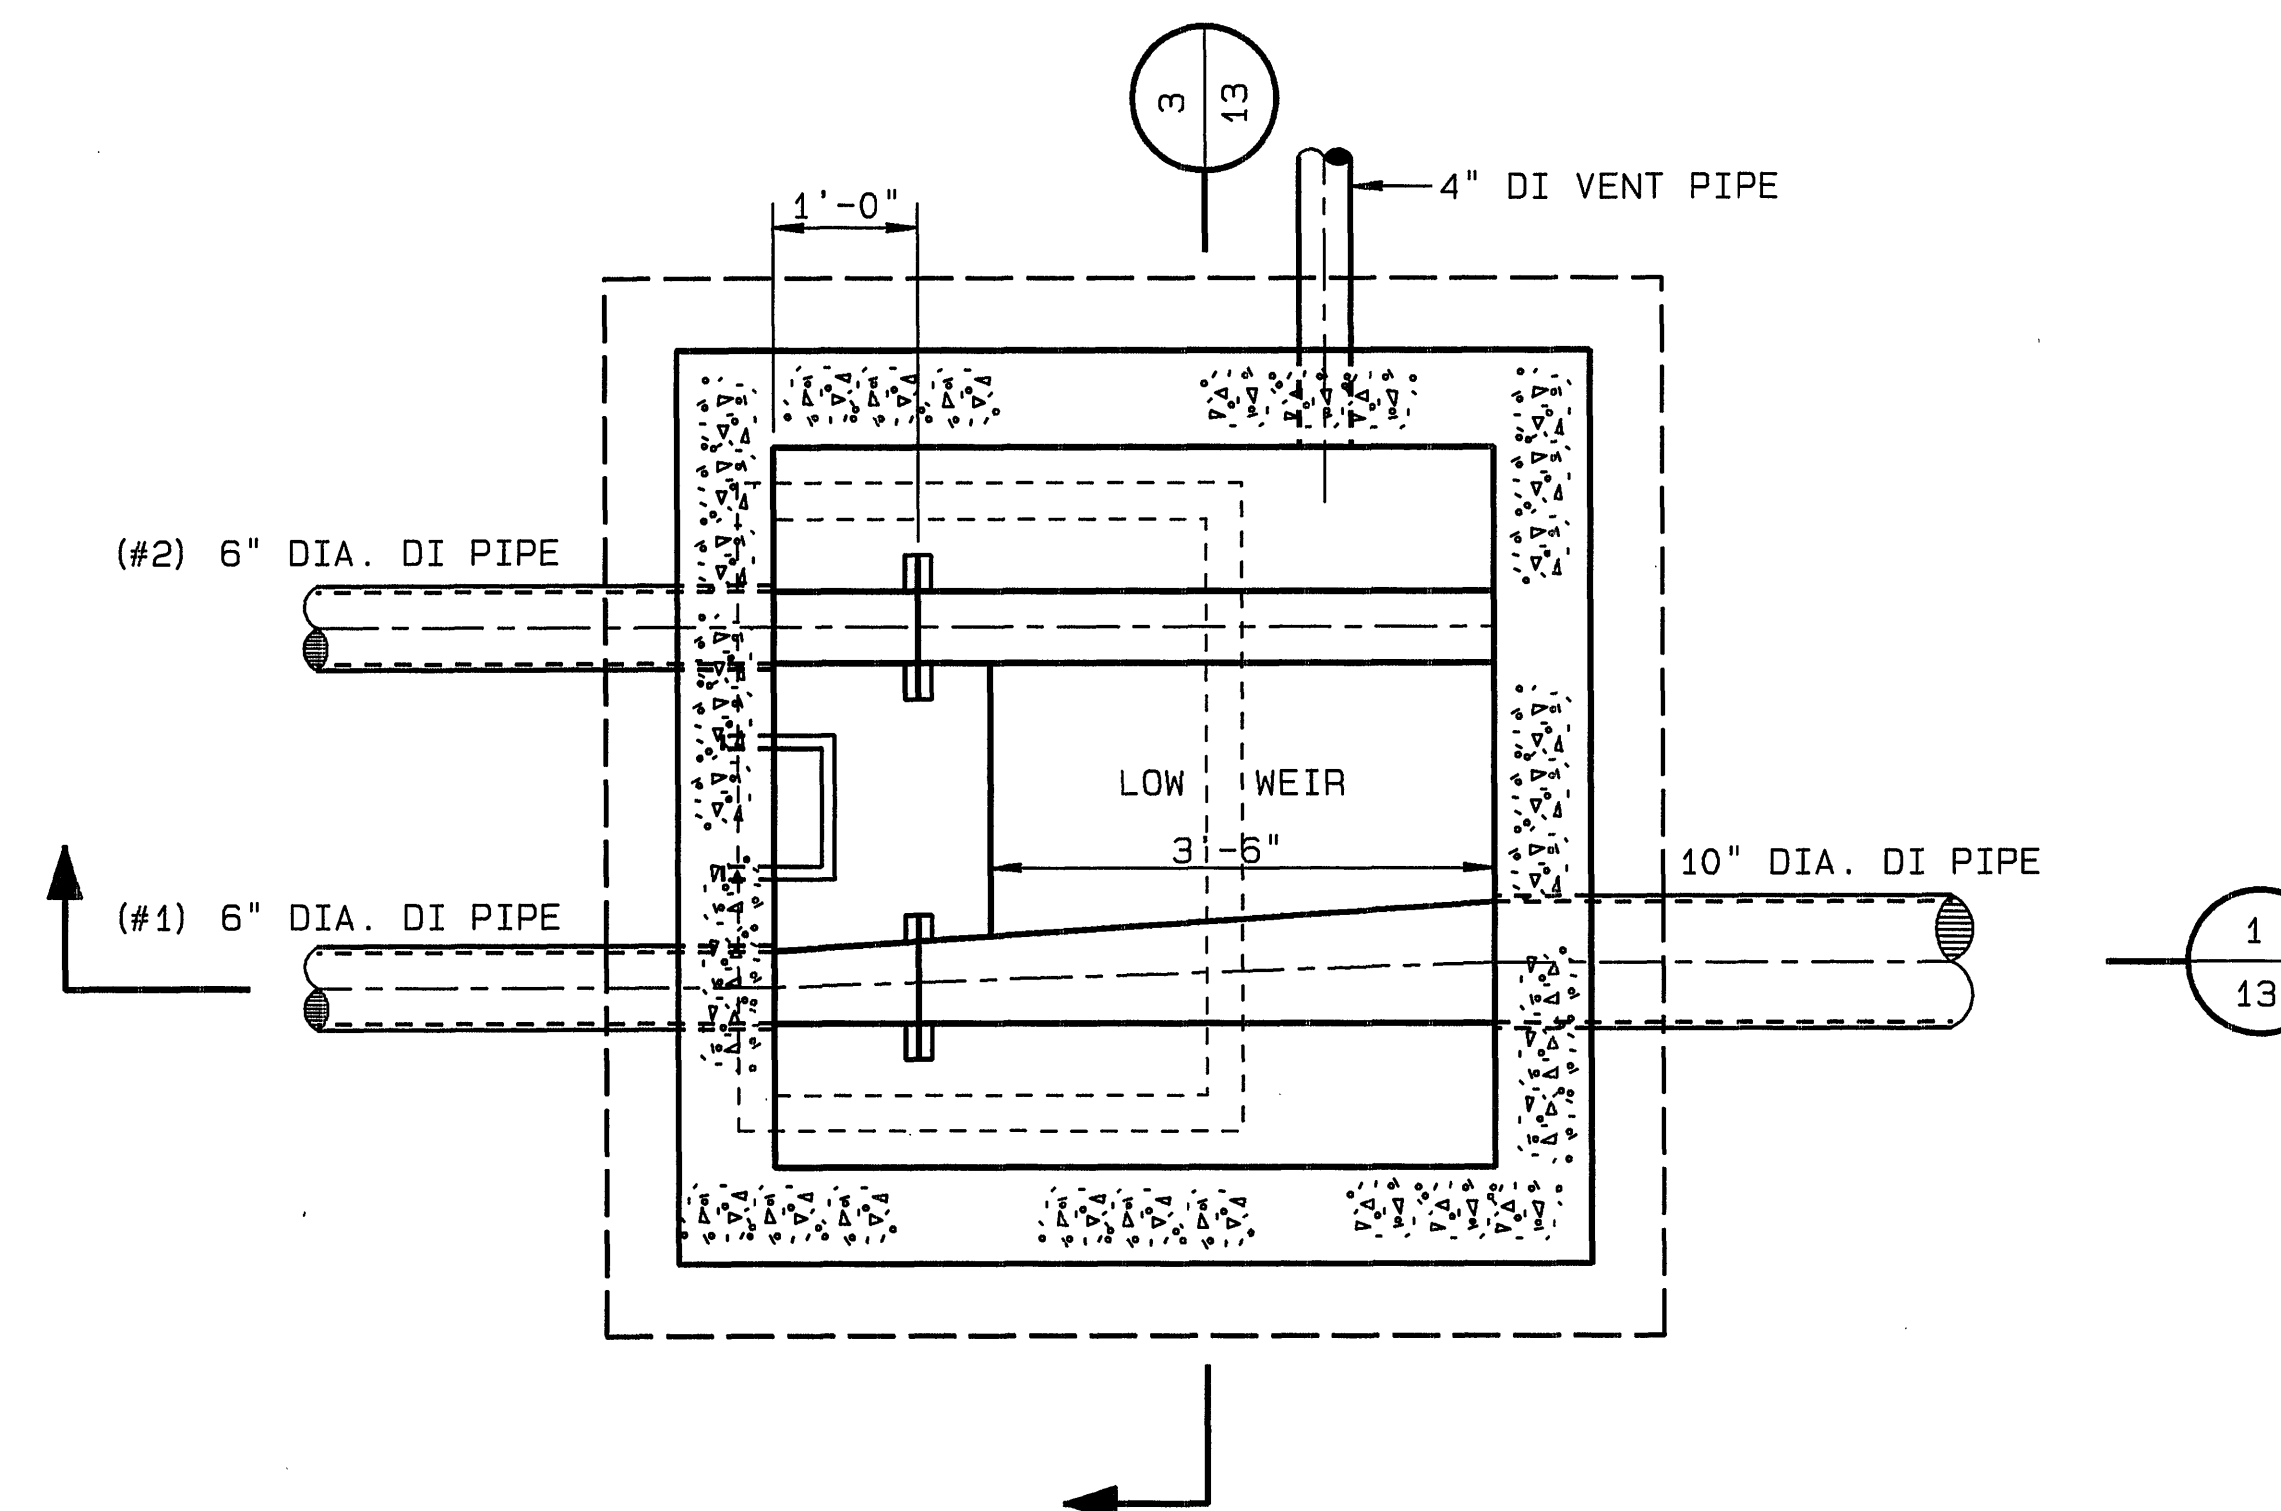

SECTION

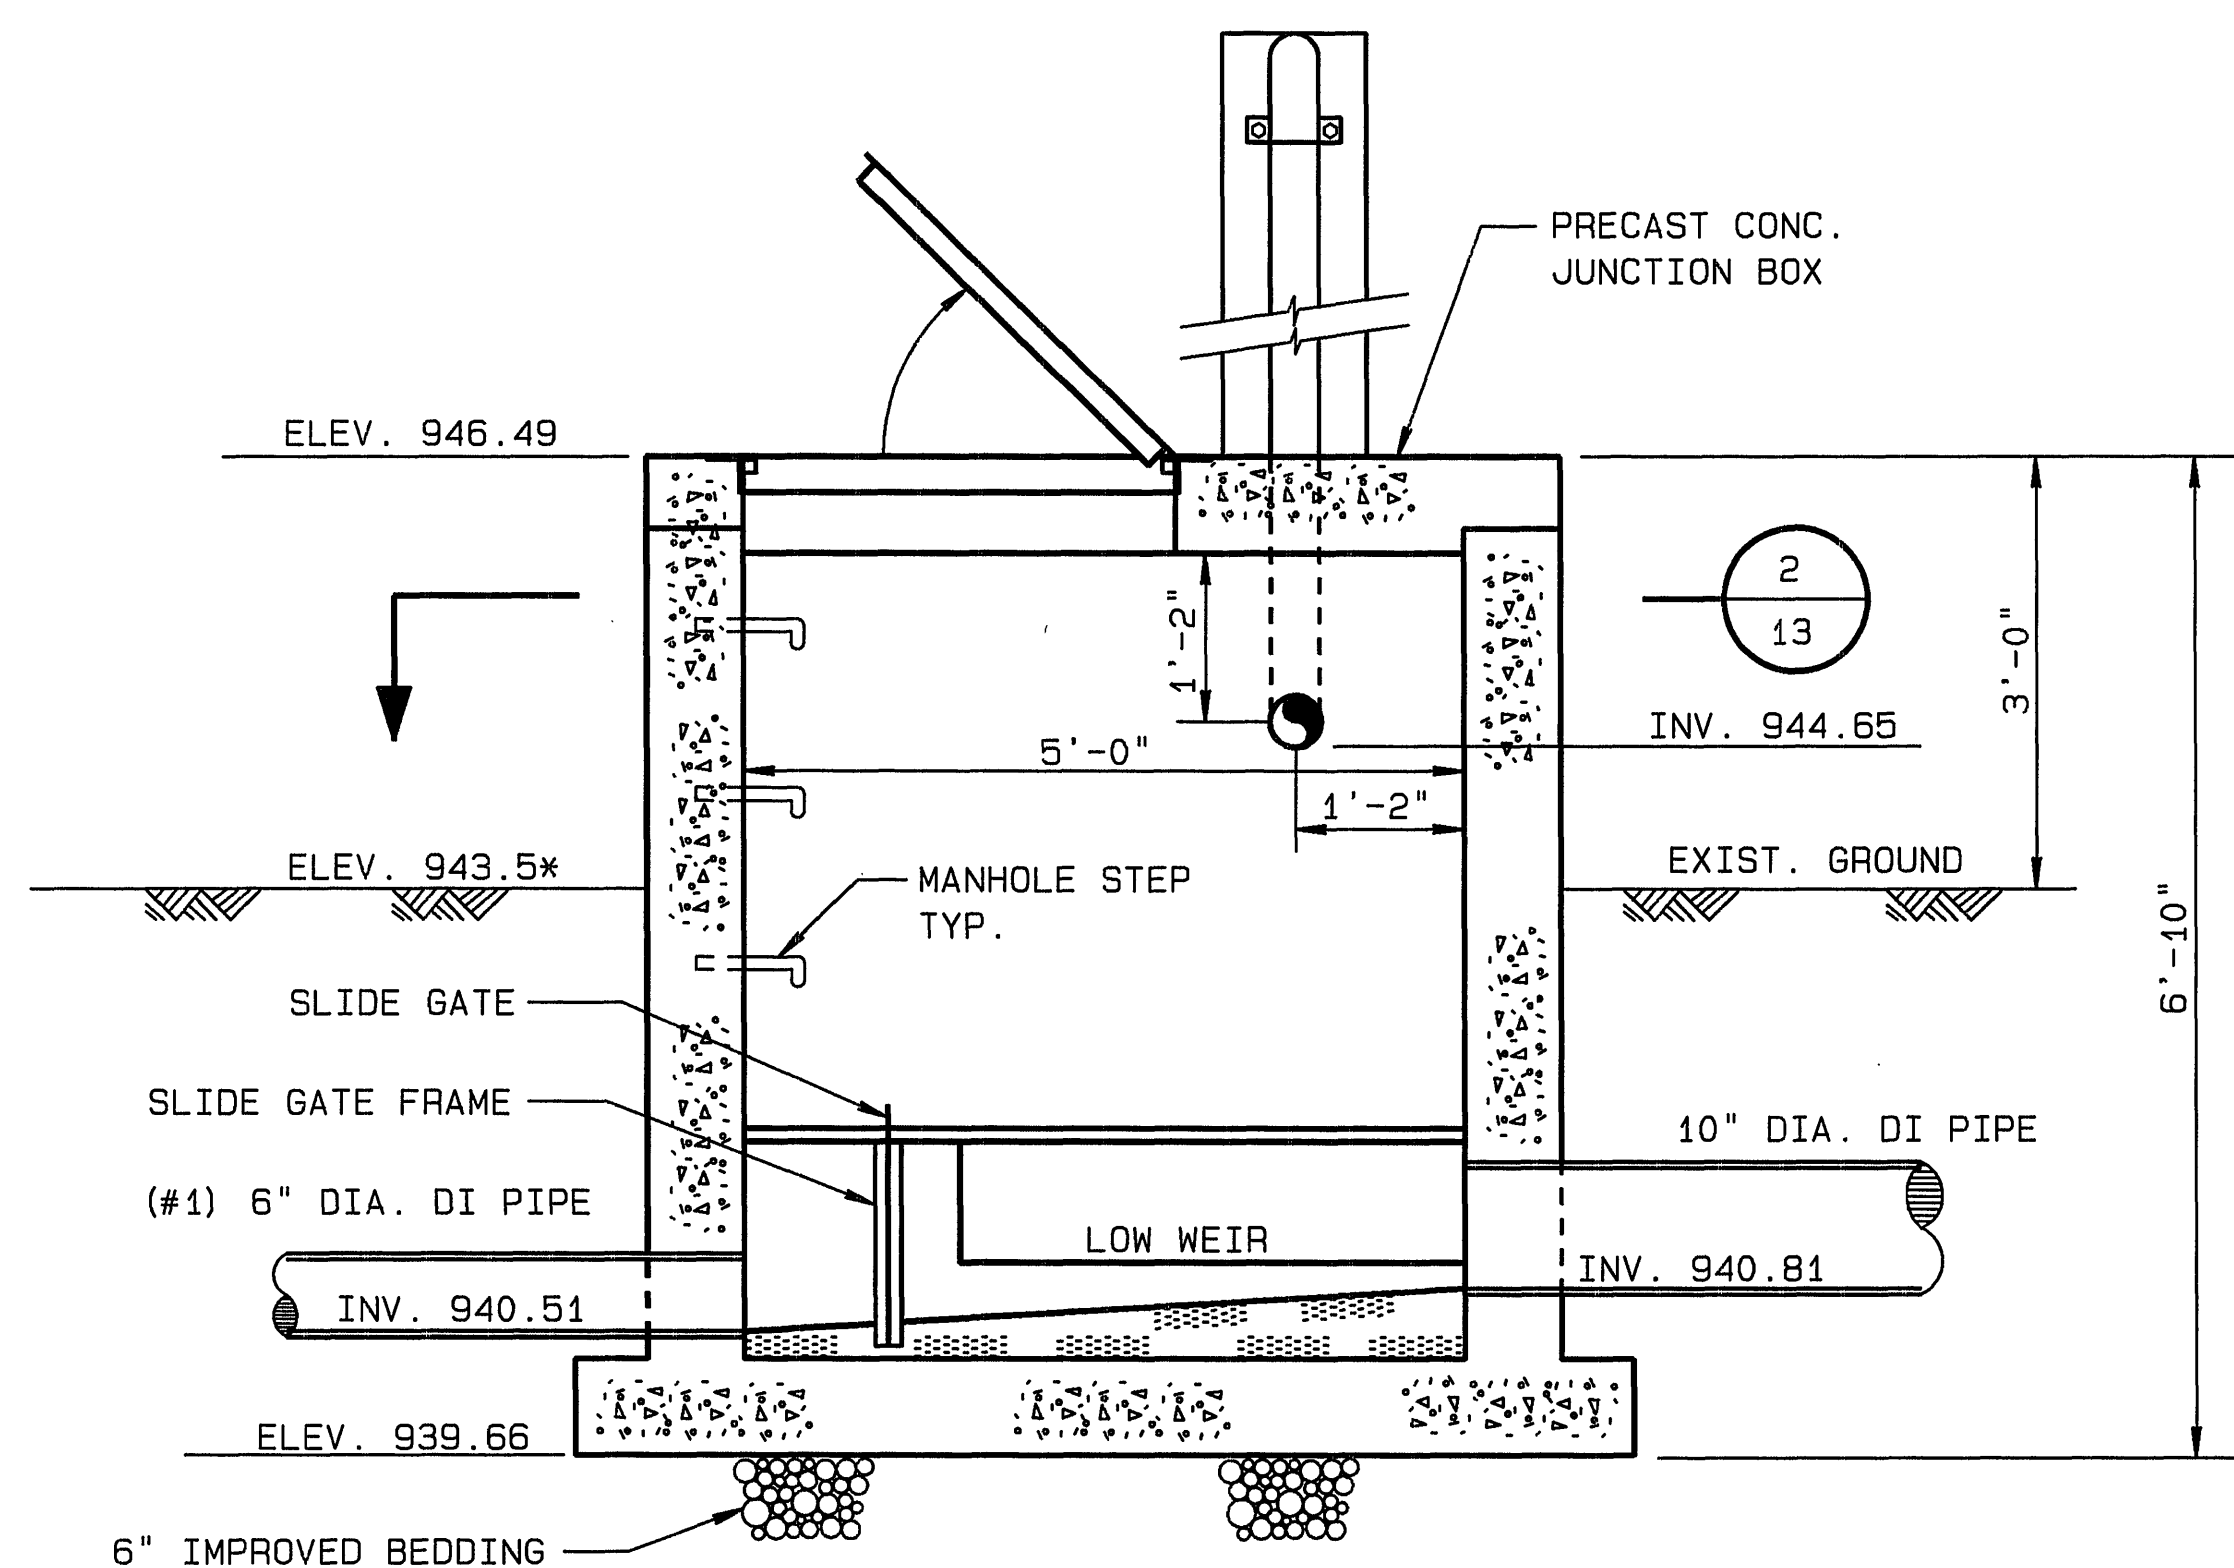

SECTION

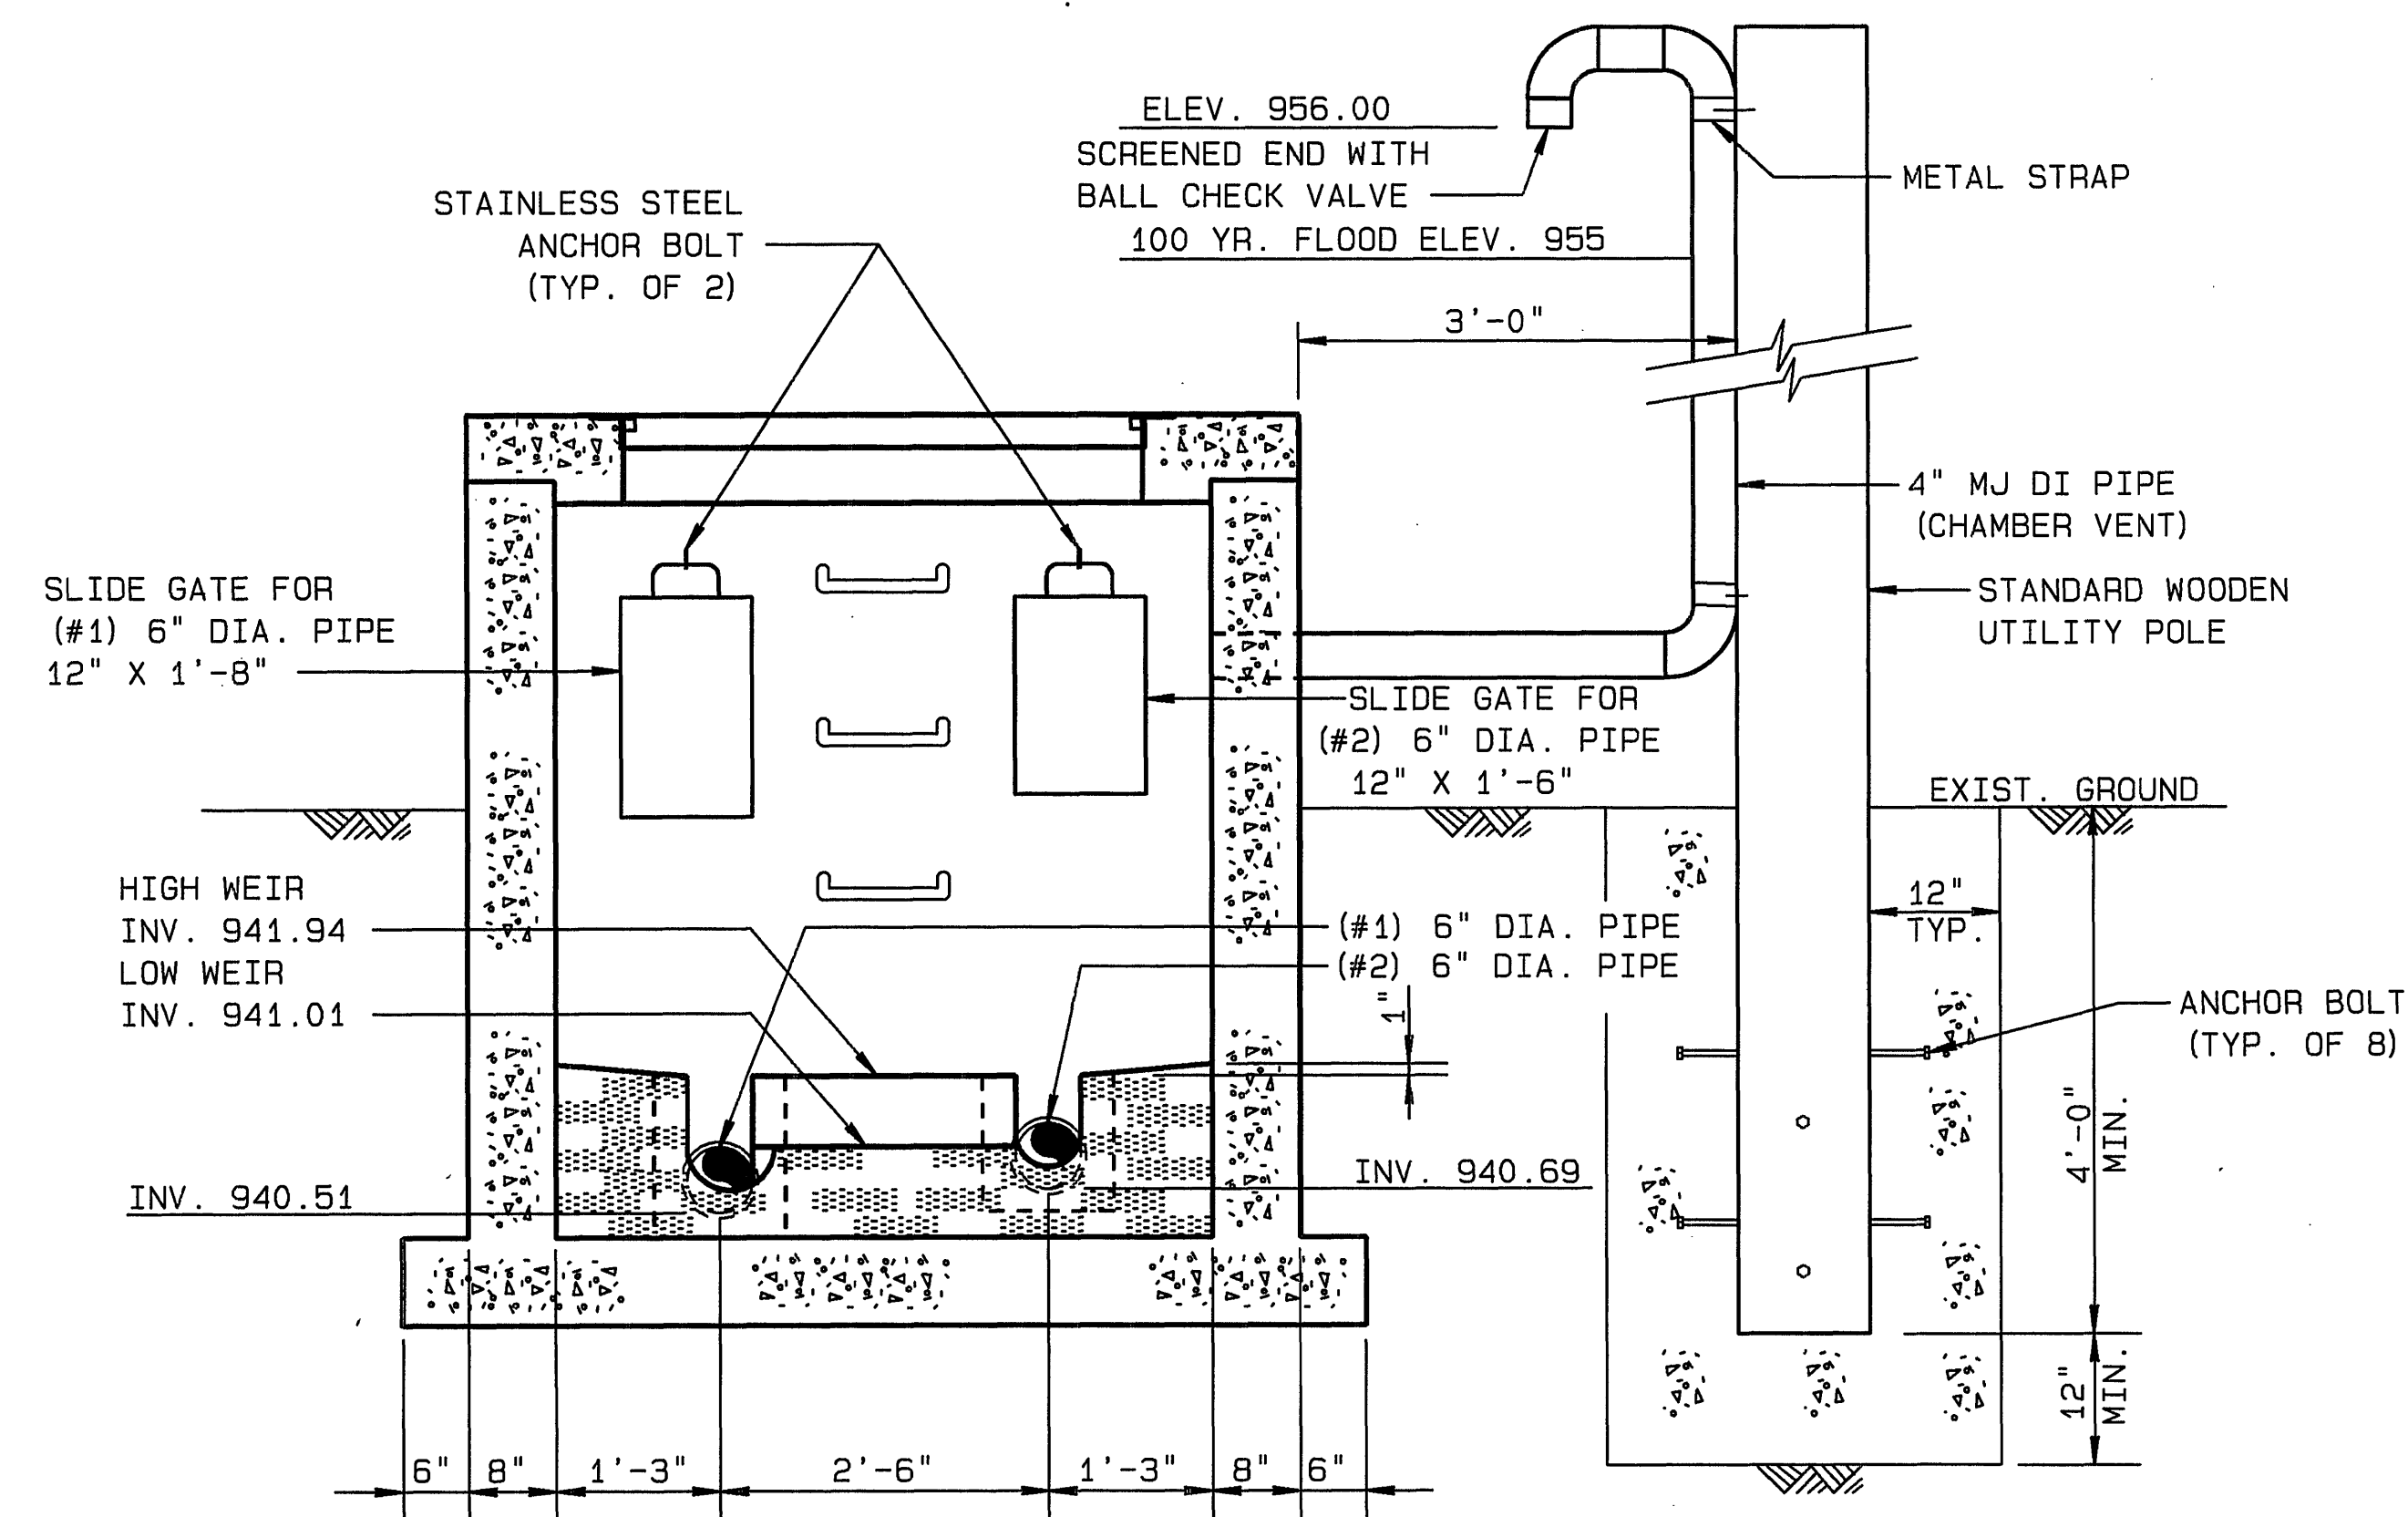


SECTION

RECORD DRAWING



DESIGNED: JMB
DRAWN: ARB
APPROVED: SHM

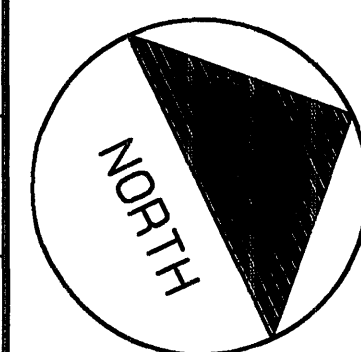

REVISION	DATE	DESCRIPTION	BY	APP.
Δ	12/11/92	AS PER COMMENTS FROM VDH/OWP	ARB	

DATE
JUNE
1992
COMM.
1165B

SANITARY SEWER EXTENSION
ROANOKE CENTRE FOR INDUSTRY & TECHNOLOGY
INVERTED SIPHON INLET CHAMBER DETAILS
CITY OF ROANOKE, VIRGINIA

SCALE: 3/4" = 1'-0"

SHEET
13
PLAN NO.
6209

DTM2-D-1165B-13