


APCO
231-480

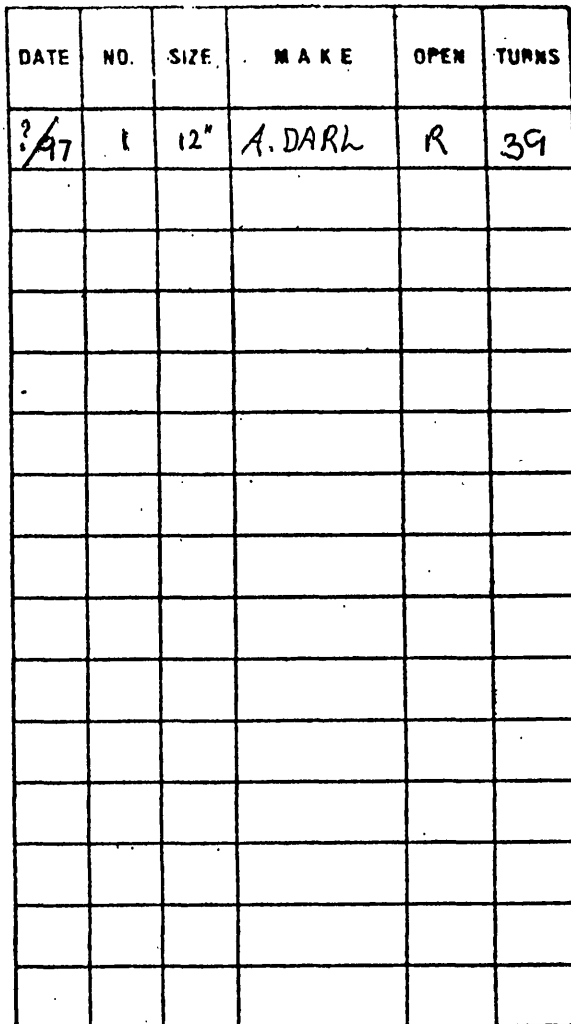

BLUE HILLS DRIVE
(1900 BLOCK)

SEC. MAP. 723

DATE 2-18-98

PAGE NO.