
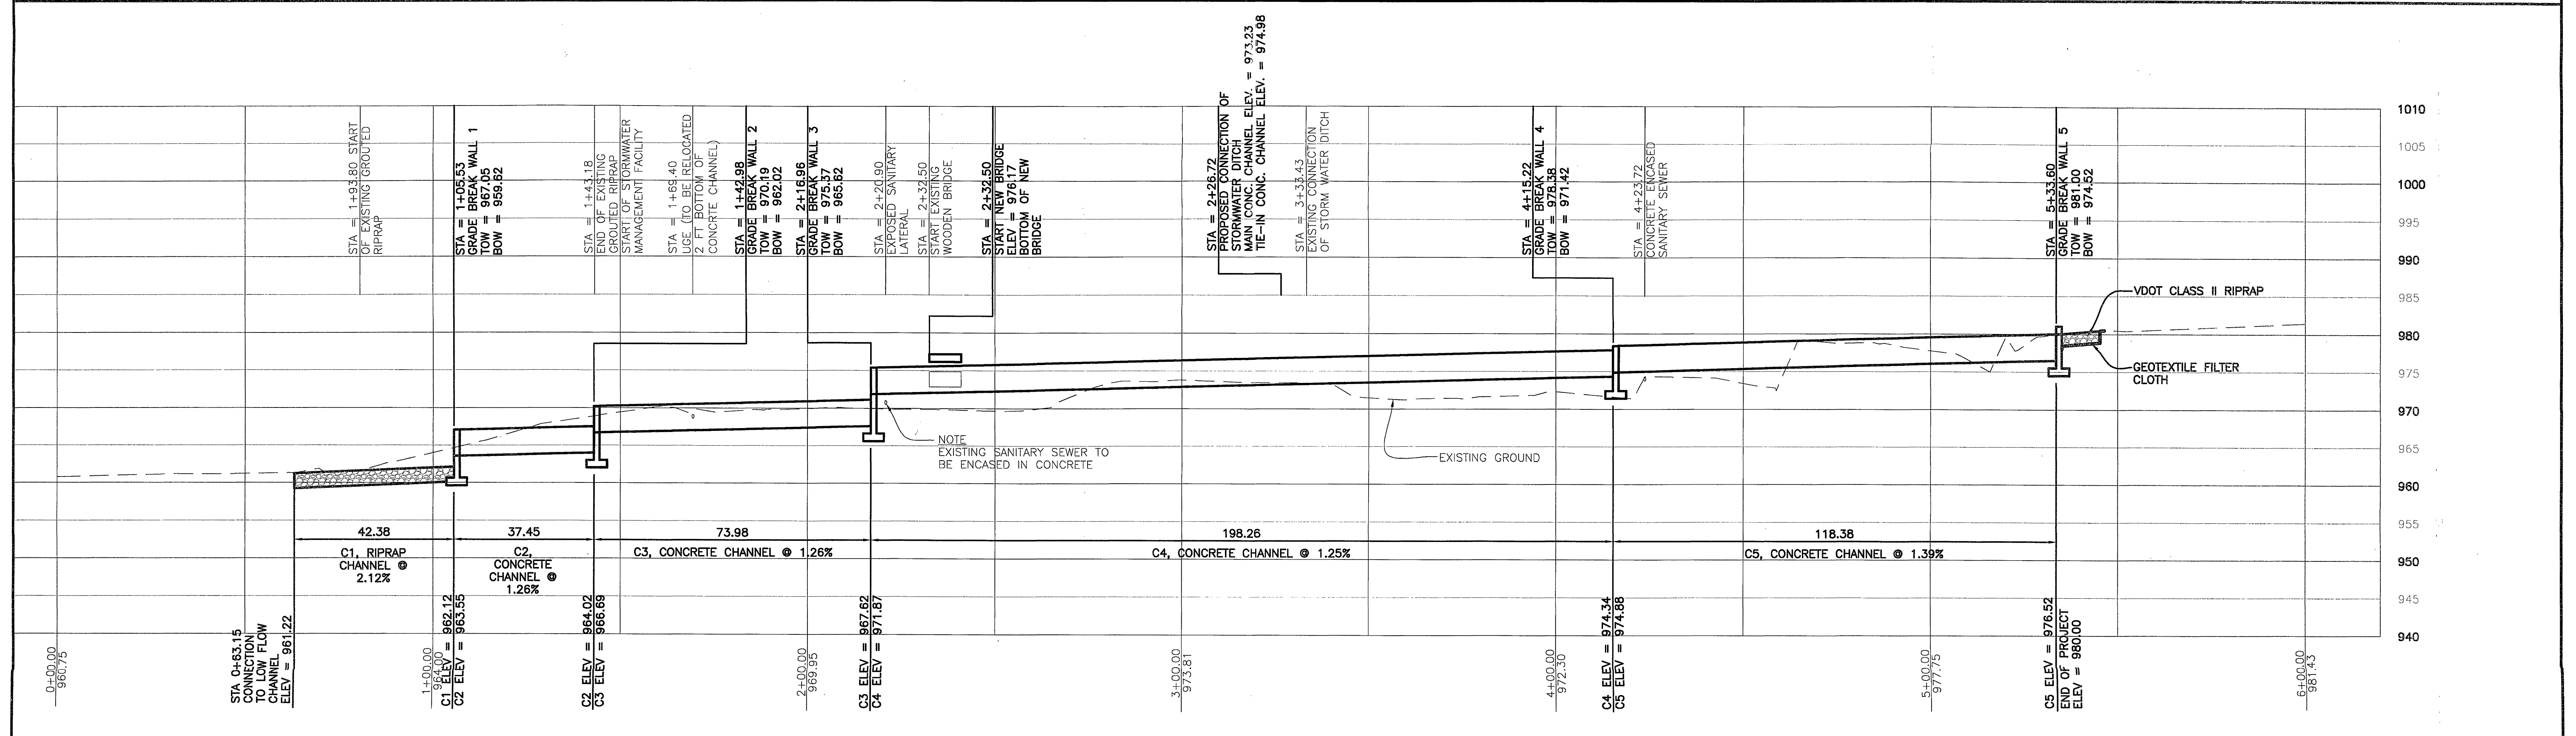


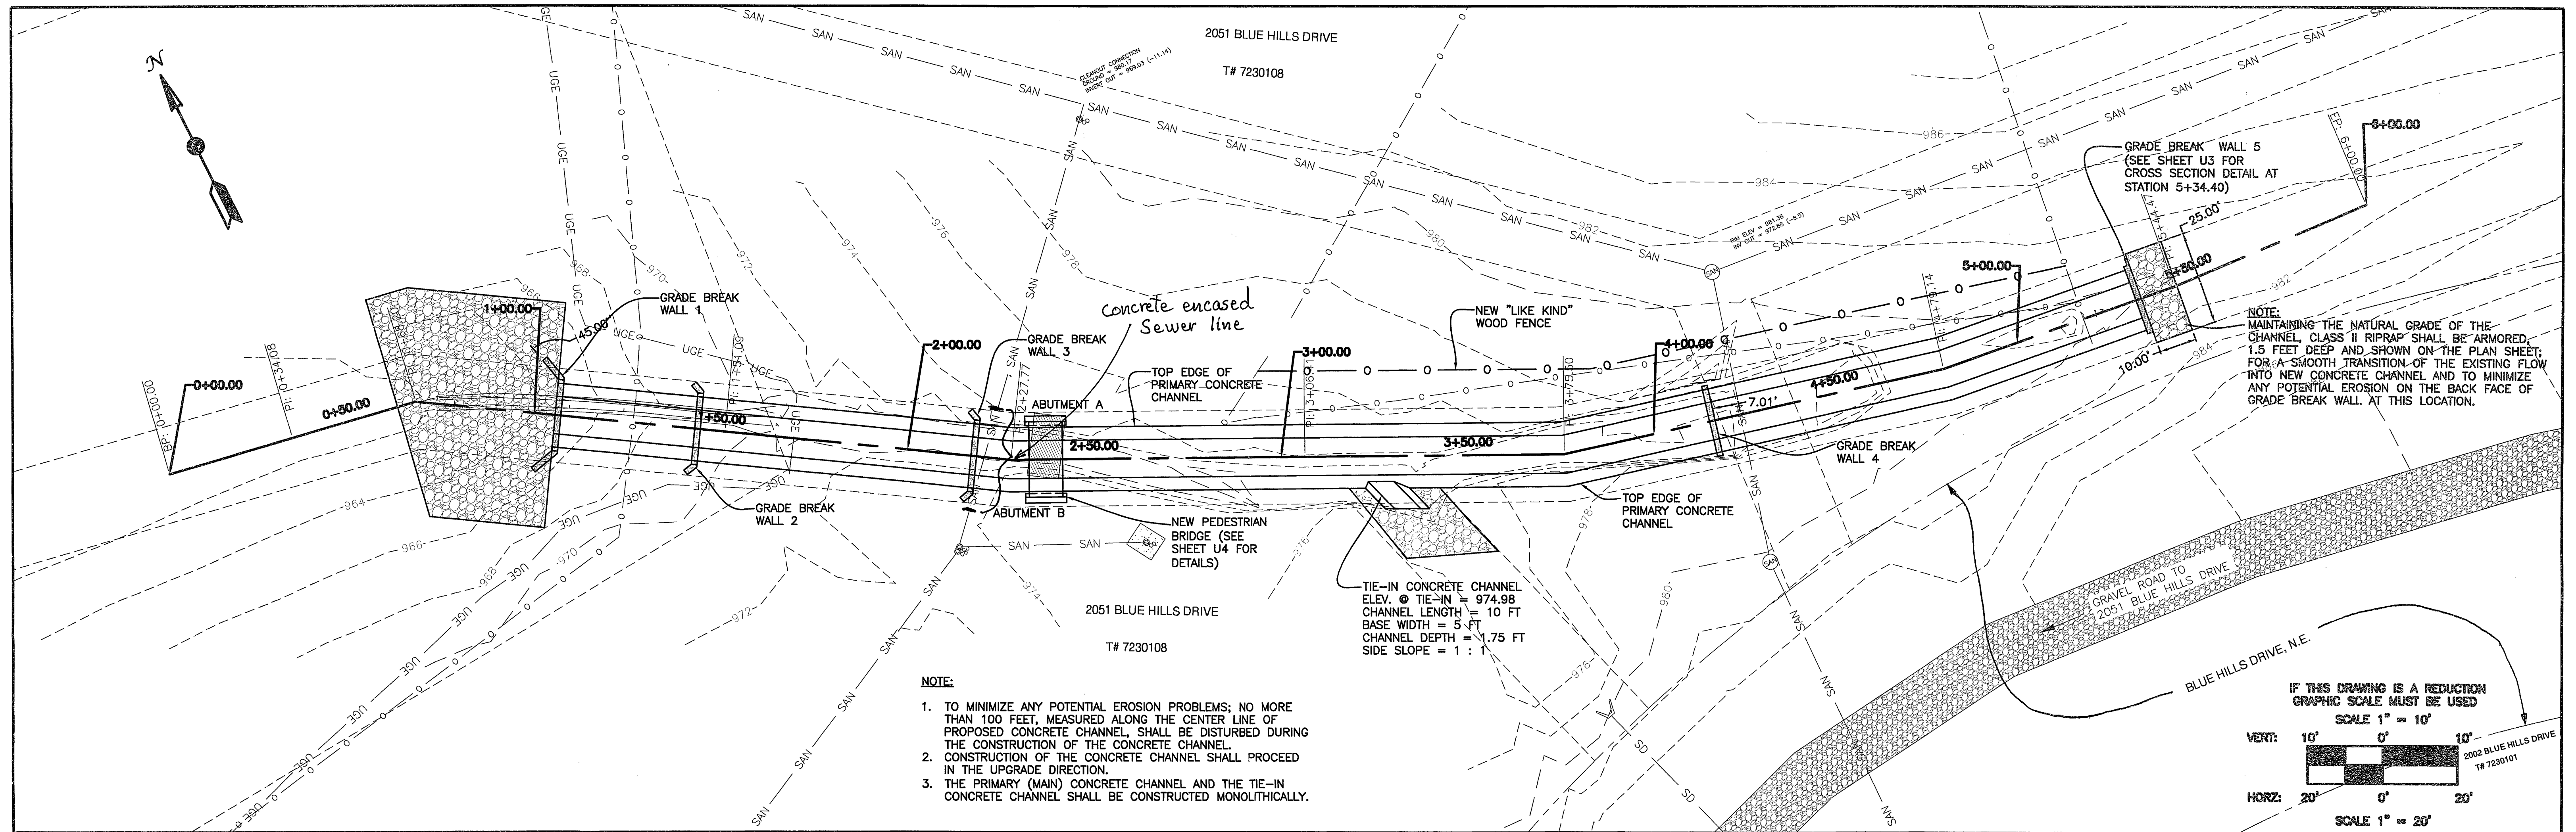

OFFICE OF THE CITY ENGINEER 215 CHURCH AVENUE, S.W. ROOM 350 PHONE: (540) 853-2731 FAX: (540) 853-1364 WWW.ROANOKEVA.GOV	DESIGNED: JJK	JOSEPHUS M. JOHNSON-KOROMA Lic. No. 46165	REV.	DATE:	DESCRIPTION	DATE:	RCIT/HERITAGE POINT EROSION REPAIR CONCRETE CHANNEL PLAN AND PROFILE CITY OF ROANOKE, VIRGINIA	SHEET U1	
	DRAWN: JJK					08/02/13			PLAN NO. 6743
	CHECKED: PCS					AS SHOWN			
						24"x36" SHEET			

As-Built K. Winslow 12.1.14