


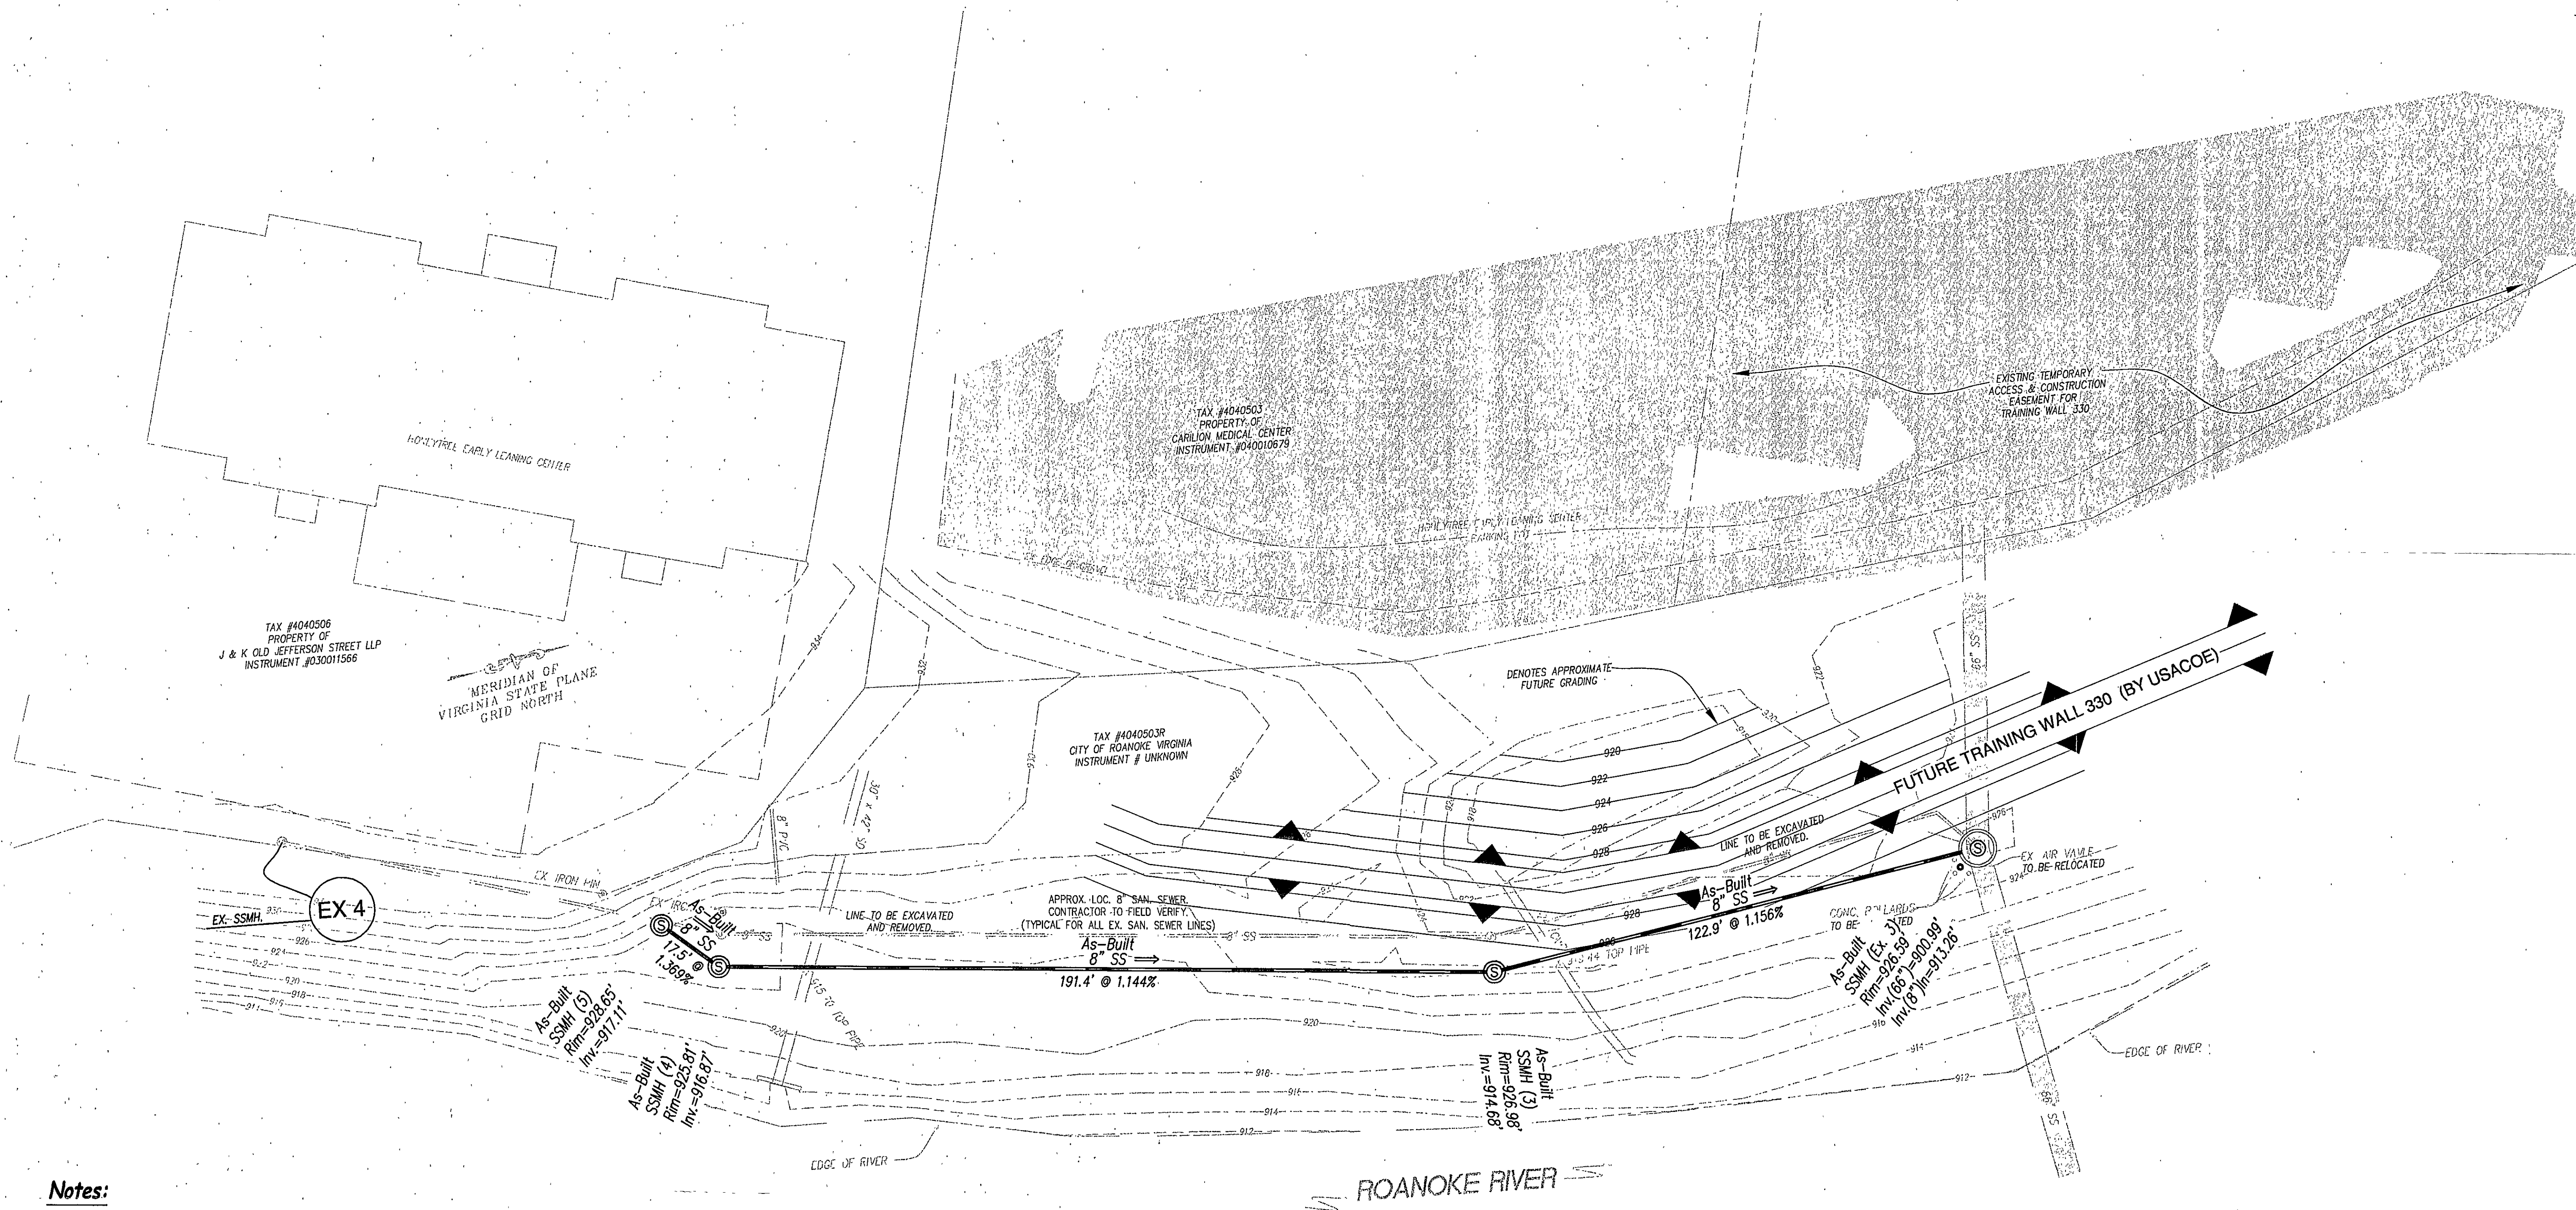


Notes:

- 1) PLAN INFORMATION TAKEN FROM DEVELOPMENT PLANS FOR CITY BID No. 6617, ENTITLED "ROANOKE RIVER FLOOD REDUCTION SANITARY SEWER AND STORM DRAIN RELOCATION AT HANNAH COURT AND SANITARY SEWER RELOCATION AT SOUTH JEFFERSON STREET" PREPARED BY LUMSDEN ASSOCIATES, P.C., DATED MAY 28, 2008.
- 2) AS-BUILT SANITARY SEWER INFORMATION BASED ON FIELD OBSERVATIONS DATED FEBRUARY 18, 2009.
- 3) SANITARY SEWER LENGTHS AND PERCENTAGES OF SLOPE AS SHOWN HEREON WERE CALCULATED FROM CENTER OF MANHOLE TO CENTER OF MANHOLE.

Working Drawing Showing
Sanitary Sewer As-Built
for
Roanoke River Flood Reduction
Relocation at South Jefferson Street, SE
Roanoke, Virginia

Calc's By: JNG
Stakeout of: Sewer As-Built

DATE: February 23, 2009
COMPL. NO.: 2008-027112
SCALE: 1" = 20'
SHEET 1 OF 1

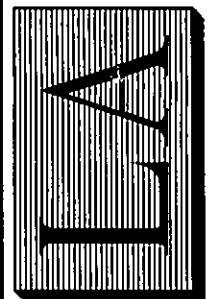

Working Drawing

4664 BRAMBLETON AVENUE, SW
P.O. BOX 20669
ROANOKE, VIRGINIA 24018

PHONE: (540) 774-4411
FAX: (540) 772-9445
E-MAIL: MAIL@LUMSDENPC.COM