



Fire Hydrant at corner of Hamilton Terrace, Piedmont, Riverview

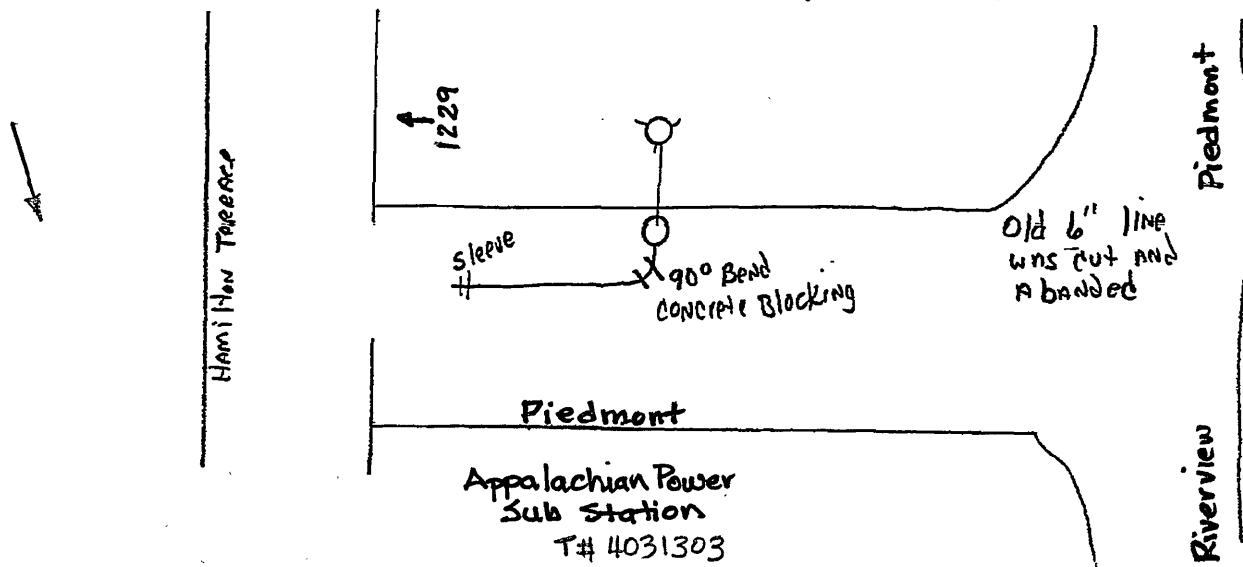

Valve at Piedmont + Hamilton Terrace

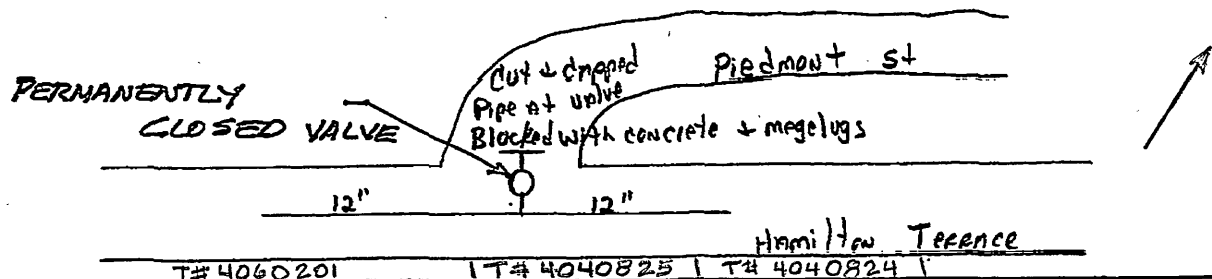

Fire Hydrant at Piedmont - Behind 1301 Hamilton Terrace and 1302 T#4040701

Abandoned 6" main



Took out old Fire Hydrant

AS BUILT
8/3/07
M. SINK