


920
910
900
890
880
870

Top
16.6' FROM TOP
NEW TOP
± 905

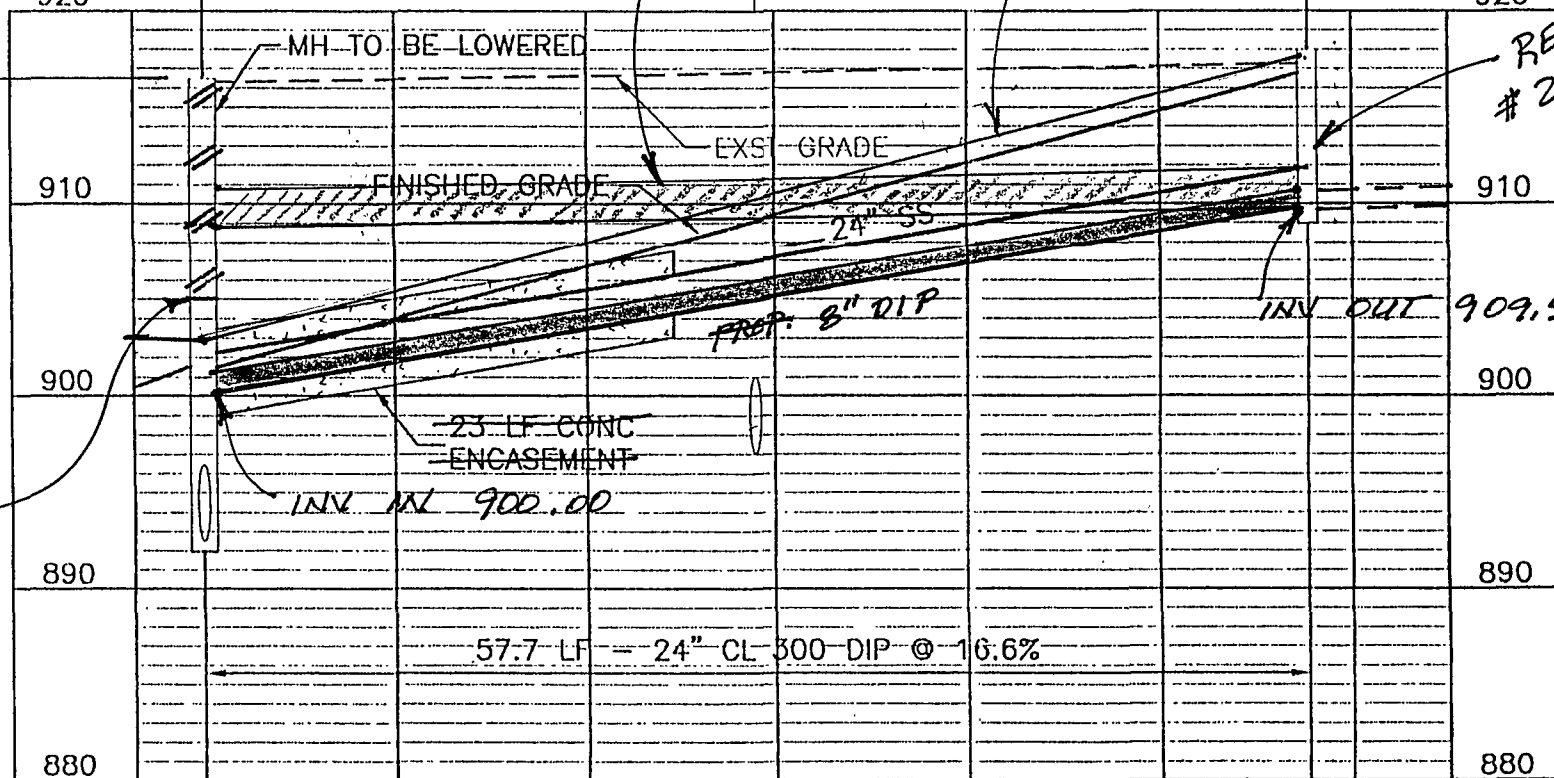

EMH-27 MH 20A-0020
66" INV OUT=892.75'
INV IN=900.00
TOP 916.59

MH-1U13 M.H. 20A-3295
INV OUT=909.50
8" SS INV IN=UNKNOWN
TOP 918.1

REPLACE M.H.
20A-3295

PLAN VIEW

EXST 24" 48" SS

REVISED BENCH

EXST. 8"

24" CMP

0+00 0+10 0+20 0+30 0+40 0+50 0+60

DEATON RD, SE T#4170202R

AS-BUILT

PROFILE - 24" LINE

SCALE: HORIZ- 1"=20' VERT - 1"=10'

BENCH CUT 411

12/6/05

JEP

WVWA ID# 6GPMAG