


PROJECT LOCATION MAP

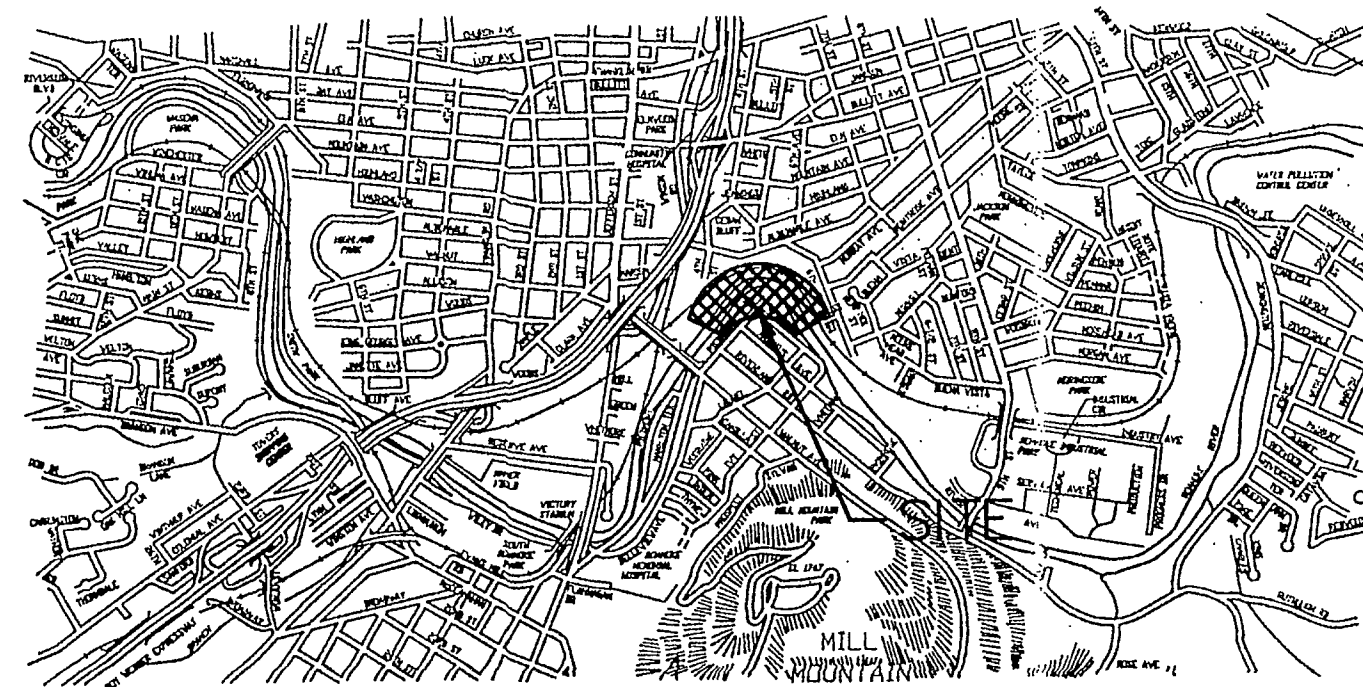

OFFICE OF CITY ENGINEER
ROOM 350
MUNICIPAL BUILDING
215 CHURCH AVENUE, S.W.
ROANOKE, VIRGINIA 24011

INDEX OF SHEETS

U1 OF U6 COVER SHEET
U2 OF U6 QUANTITY SHEET & DETAILS
U3 OF U6 GENERAL NOTES, ABBREVIATIONS AND LEGENDS
U4 OF U6 DETAILS
U5 OF U6 NIC
U6 OF U6 STA 353+00 TO 374+00 BENCH CUT 353

RECEIVED
JAN 20 2006
CITY OF ROANOKE
PLANNING BUILDING AND DEVELOPMENT

FAILURE TO COMPLY WITH THE CONSTRUCTION PROCEDURE REQUIREMENTS LISTED BELOW MAY RESULT IN THE COSTLY REMOVAL OF STRUCTURES, TIME DELAYS OR THE ISSUANCE OF A STOP WORK ORDER.

CONSTRUCTION PROCEDURE REQUIREMENTS

- RIGHT OF WAY EXCAVATION PERMIT** - Prior to the commencement of any digging, alteration or construction within the public right-of-way (streets, alleys, public easements), a right-of-way excavation permit shall be applied for and obtained by the contractor from the City of Roanoke.
- LAND DISTURBANCE PERMIT** - An approved erosion and sediment control plan for any borrow/fill sites associated with the project must be submitted prior to the issuance of a land disturbance permit.
- PLANS AND PERMITS** - A copy of the plans as approved by the City (signed by the proper City officials) and all permits issued by the City shall be available at the construction site at all times of ongoing construction.
- LOCATION OF UTILITIES** - The contractor shall verify the location of all existing utilities prior to the commencement of any construction.
- CONSTRUCTION ENTRANCE** - The contractor shall install an adequate construction entrance for all construction related egress from the site. Size and composition of construction entrance shall be as shown on the plans.
- STREETS TO REMAIN CLEAN** - It shall be the responsibility of the contractor to insure that the public street adjacent to the construction entrance remains free of mud, dirt, dust, and/or any type of construction materials or litter at all times.
- BARRICADES/DITCHES** - The contractor shall maintain the integrity of all excavated ditches and shall furnish and ensure that all barricades proper and necessary for the safety of the public are in place.
- SEWER AND PAVEMENT REPLACEMENT** - Construction of sanitary sewers and the replacement of pavement shall be in accordance with approved standards and specification of the City of Roanoke and the West Virginia Water Authority.
- APPROVED PLANS/CONSTRUCTION CHANGES** - Any change or variation from construction design as shown on the officially approved plans shall be approved by the erosion and sediment control agent prior to said changes or variation in construction being made.
- FINAL ACCEPTANCE/CITY** - The owner or developer shall furnish the City of Roanoke's Planning Building and Development Department with a final correct set of as-built plans prior to final acceptance by the City.

APPROVED
[Signature]
Project Manager
Date: 02-14-07

AS - BUILT 04/13/2007

CONSULTING ENGINEERS



Engineering
Architecture
Surveying
Landscape Design


102 Albemarle Ave
Roanoke, Virginia
24013

www.imwpc.com

ph: 540.345.0675
fax: 540.342.4456

lmweng@lmw.roacoxmail.com

COMMISSION NUMBER: 3161

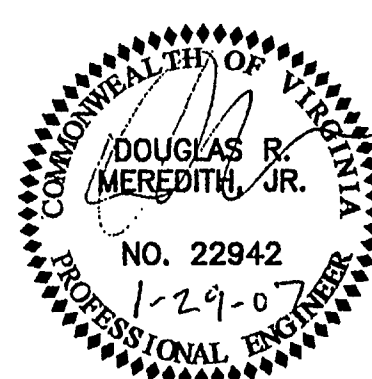

PROJECT NAME

ROANOKE RIVER
FLOOD REDUCTION
UTILITY RELOCATION PROJECT
RIVERVIEW BOULEVARD SANITARY
SEWER RELOCATION

PROJECT NUMBER: 6580

WVWA
REVISION BY

DESCRIPTION: ADDITIONAL SEWER LINES & LATERALS, RENUMBER MH

09/05/06
DATE

CITY OF ROANOKE
REVISION BY

DESCRIPTION: E&S DETAILS & NOTES; CITY CONSTRUCTION NOTES

01/16/07
DATE

REVISION BY

DESCRIPTION:

DATE

REVISION BY

DESCRIPTION:

DATE

APPROVED FOR CONSTRUCTION

ROANOKE CITY ENGINEER

DATE

DIRECTOR OF PUBLIC WORKS

DATE

DIRECTOR OF UTILITIES AND OPERATIONS

DATE

DATE

DATE

ADVERTISED DATE:

SET NUMBER:

SHEET NUMBER: U1 OF U6