


MS + S
5th St

434 Church Ave SW
(Back of Building)



*NOTE - Contractor Removed hydrant
From Existing hydrant line
and extended past sidewalk,
Relocated hydrant for New
Fire line.

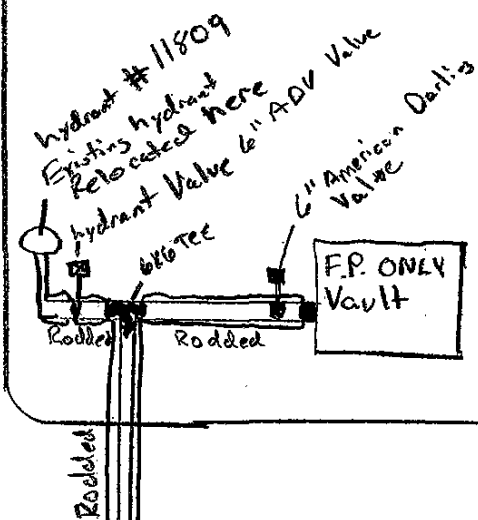

As-built 4/16/18
Job: 434 Church Ave Fire Vault
+ Sewer
Inspector: Brian Whiteneck
Contractor: Major City Sprinkler
5/3/18

Existing 6" Cast Iron

Luck Ave SW

NEW WATERLINE FOR
ROANOKE COLUMN STAGE LLC
434 CHURCH AVENUE SW ROANOKE, VIRGINIA

ENLARGED
DETAIL
FIRE SERVICE
AND
FIRE HYDRANT

