


1. THIS AS-BUILT HAS BEEN PREPARED FROM AN ACTUAL FIELD SURVEY.
2. THIS AS-BUILT IS TO SHOW THE SANITARY SEWER FROM EXISTING SEWER MANHOLE TO NEW SS CO. 42-2, AND THE NEW 2" WATERLINE FROM THE EXISTING CONNECTION IN PRIVATE DRIVE TO THE APZJER. ALL OTHER ITEMS ARE TAKEN FROM THE CONSTRUCTION DOCUMENTS AND SHOULD BE USED FOR GENERAL INFORMATION ONLY.
3. DUE TO THE WATERLINE BEING BURIED BY THE TIME OF THIS SURVEY, THE UNDERGROUND CONNECTIVITY IS SHOWN AS POINTED OUT IN THE FIELD BY KIRKLAND, INC.

CHALLENGER AVE
(U.S. ROUTE 400)
(ROAD VALUES)

PLAN NORTH

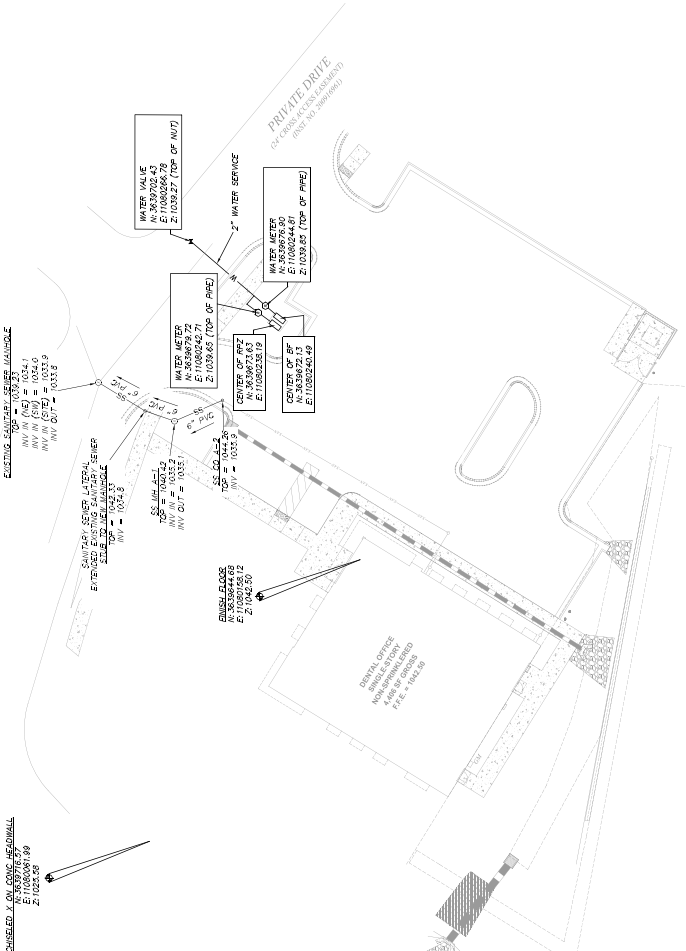

LEGEND
BF BACKFLOW ASSEMBLY
+ BOXHILLER



PROJECT# 230280
DATE: 05-10-2024
DRAWN BY: RW
SHEET 1 OF 1

