
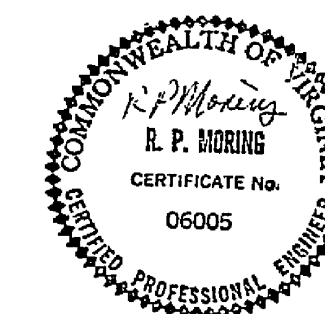


DEVELOPMENT PLANS  
FOR  
**ROANOKE HYUNDAI**  
ROANOKE VIRGINIA

DATE: 26 FEBRUARY, 1988  
3 NOVEMBER 1988 - "AS-BUILT"

INDEX OF DRAWINGS

| SHEET | DESCRIPTION                              |
|-------|------------------------------------------|
| 1     | COVER SHEET                              |
| 2     | ROANOKE COUNTY COVER SHEET               |
| 3     | DIMENSIONAL LAYOUT & UTILITY PLAN        |
| 4     | GRADING, DRAINAGE & EROSION CONTROL PLAN |
| 5     | SANITARY & STORM PROFILES                |
| 6     | DETAILS                                  |
| 7     | EROSION CONTROL DETAILS                  |
| 8     | LANDSCAPING PLAN                         |
| 9     | SANITARY SEWER DETAILS                   |
| 10    | WATER DETAILS                            |

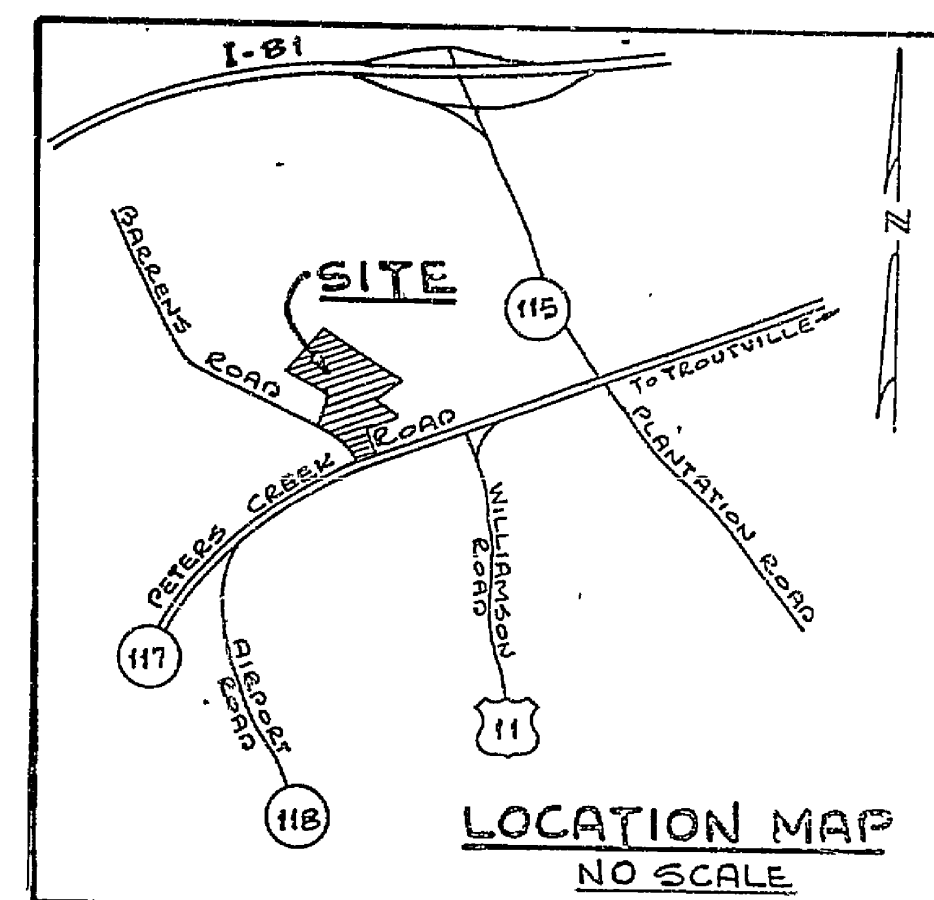

**BUFORD T. LUMSDEN & ASSOCIATES, P.C.**  
**ENGINEERS - SURVEYORS**  
**ROANOKE, VIRGINIA**

\* 85 541 G

SHEET # 1 OF 10

