


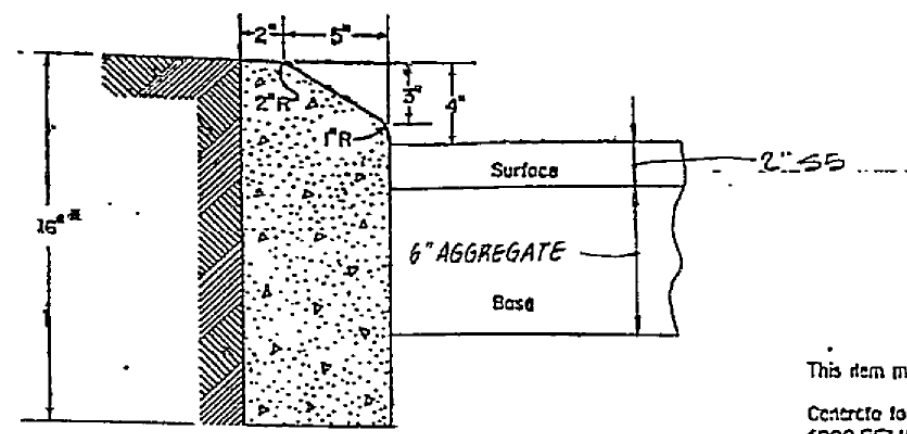


NOTES
This item may be precast or cast in place.
Concrete to be Class A3 if cast in place,
4000 PSI if precast.

Curb having a radius of 300 ft. or less
(along face of curb) will be paid for as
radius curb.


When this standard is to be tied into existing
barrier curb, the transition is to be made within
10' or the change in standards made at regular
openings.

This curb shall be used when design speed is
greater than 40 MPH on Rural Highways and
45 MPH in developed Urban and Suburban
areas.


1 4" CURB CG-3
NO SCALE

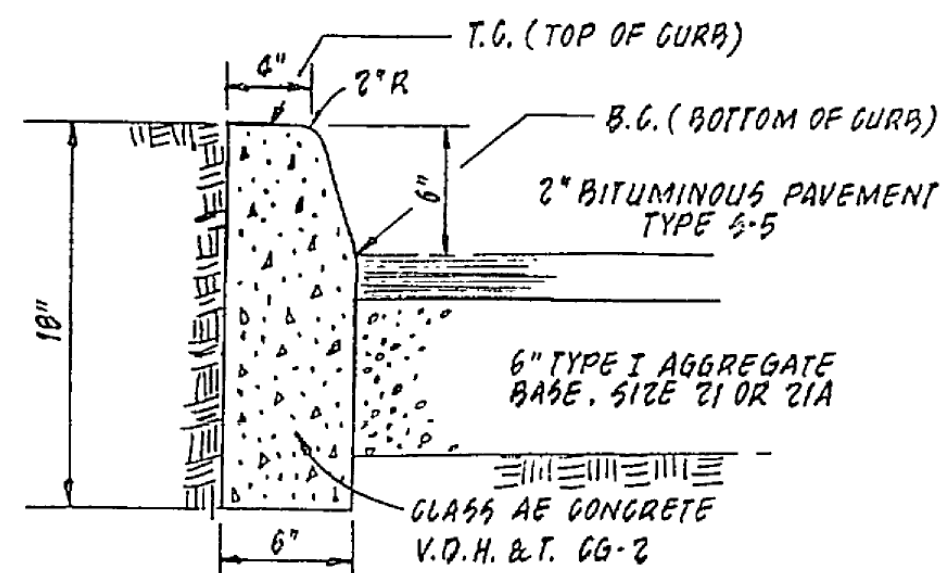

2 CURB & PAVEMENT DETAIL
NO SCALE

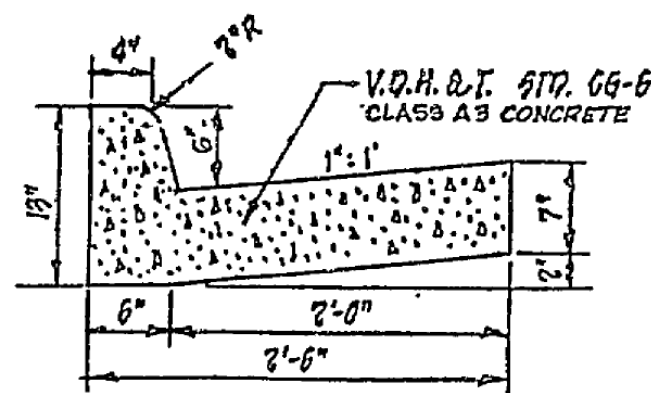

3 TYPICAL SECTION: CURB & GUTTER
NO SCALE

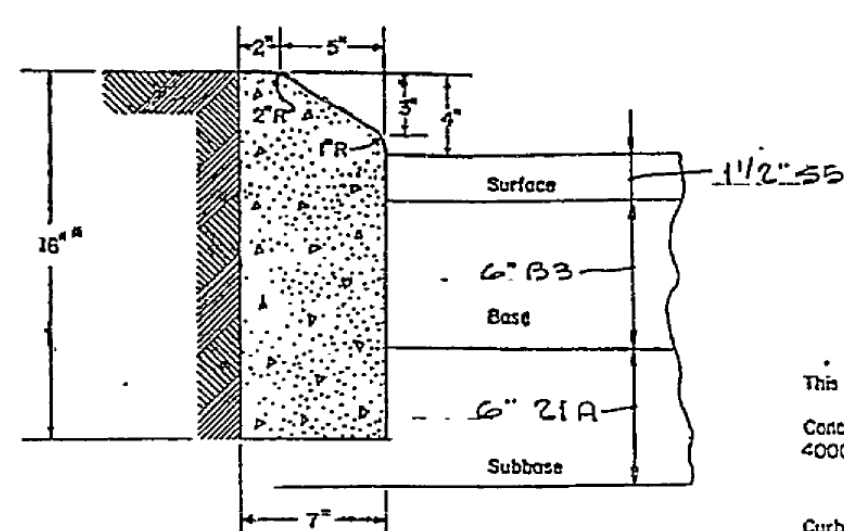


NOTES
This item may be precast or cast in place.
Concrete to be Class A3 if cast in place,
4000 PSI if precast.

Curb having a radius of 300 ft. or less
(along face of curb) will be paid for as
radius curb.


When this standard is to be tied into existing
barrier curb, the transition is to be made within
10' or the change in standards made at regular
openings.

This curb shall be used when design speed is
greater than 40 MPH on Rural Highways and
45 MPH in developed Urban and Suburban
areas.

4 4" CURB CG-3
NO SCALE

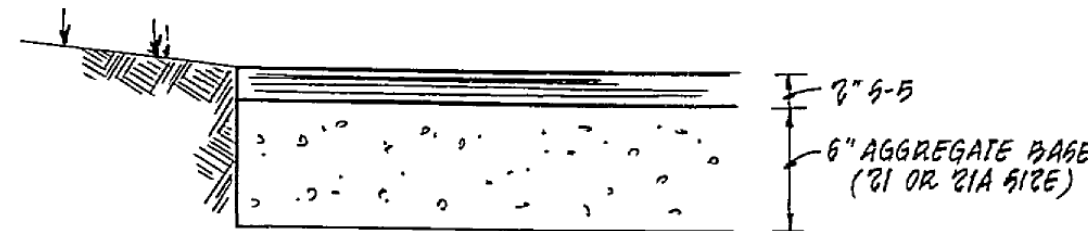


5 TYPICAL LOT PAVEMENT
NO SCALE

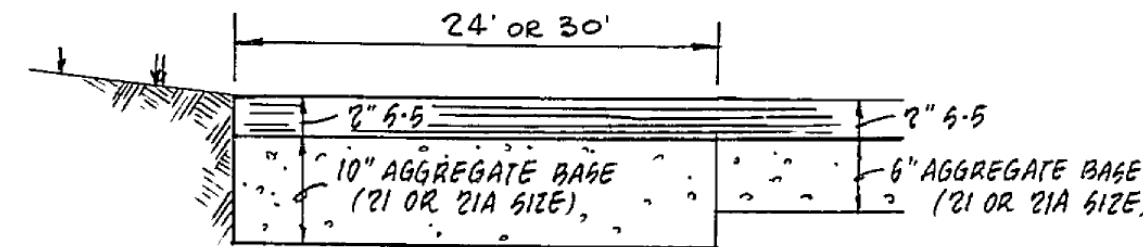


6 STREET & LOT PAVEMENT
WEST OF PROPOSED BUILDING
NO SCALE


NOTE:
10" BASE TO EXTEND FROM BARBERS ROAD
TO PAVEMENT TERMINATION.

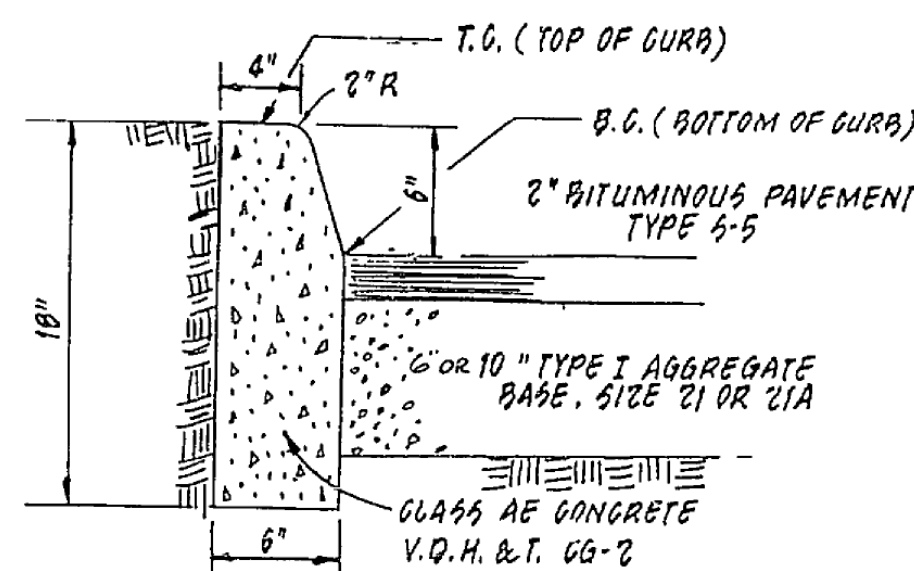

7 CURB & PAVEMENT DETAIL
NO SCALE

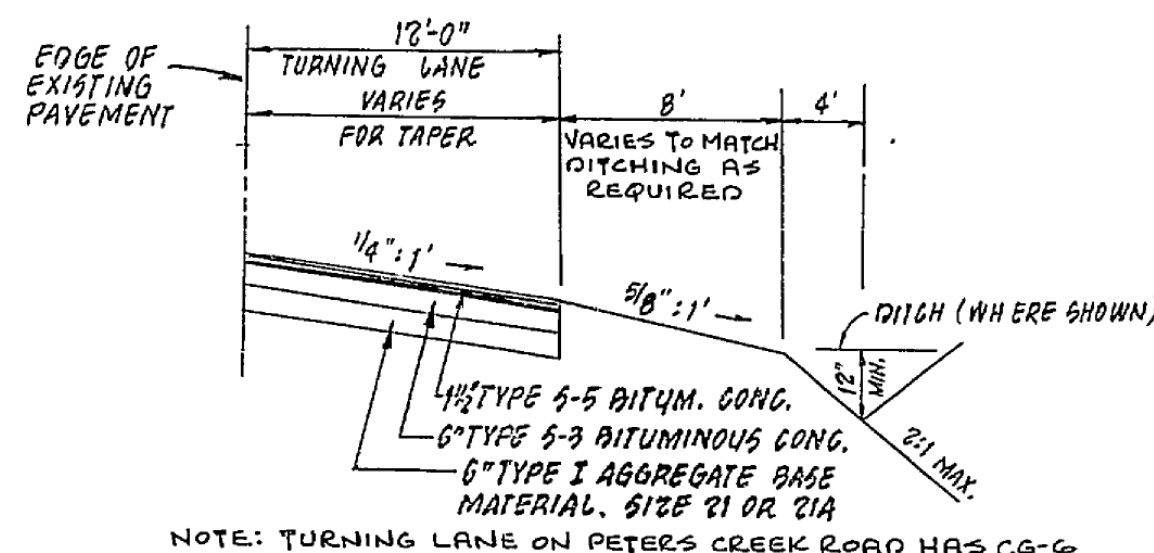


8 TAPER & TURNING LANE
NO SCALE


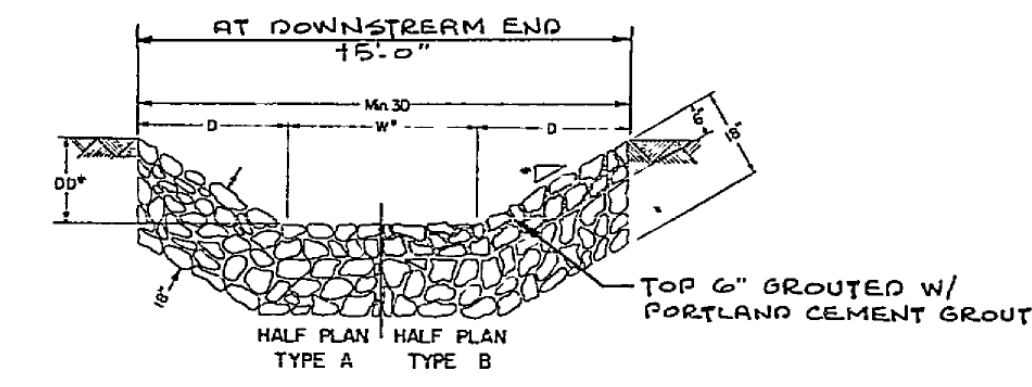


9 EROSION CONTROL APRON
NO SCALE

* USE NATURAL SIDE SLOPE,
BOTTOM WIDTH & DEPTH OF CHANNEL

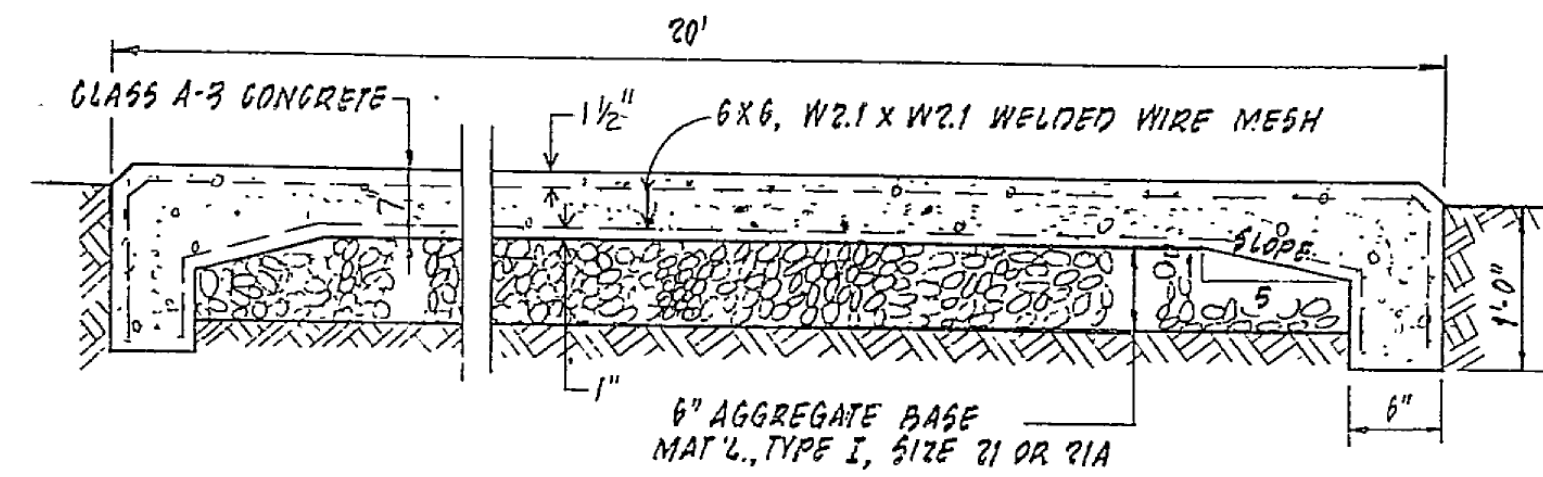


10 TYPICAL SECTION: DUMPSTER PAD
NO SCALE

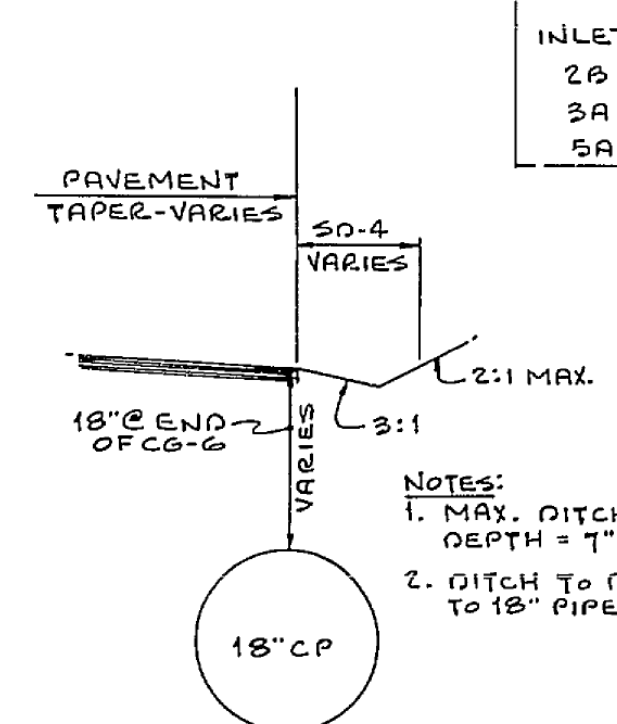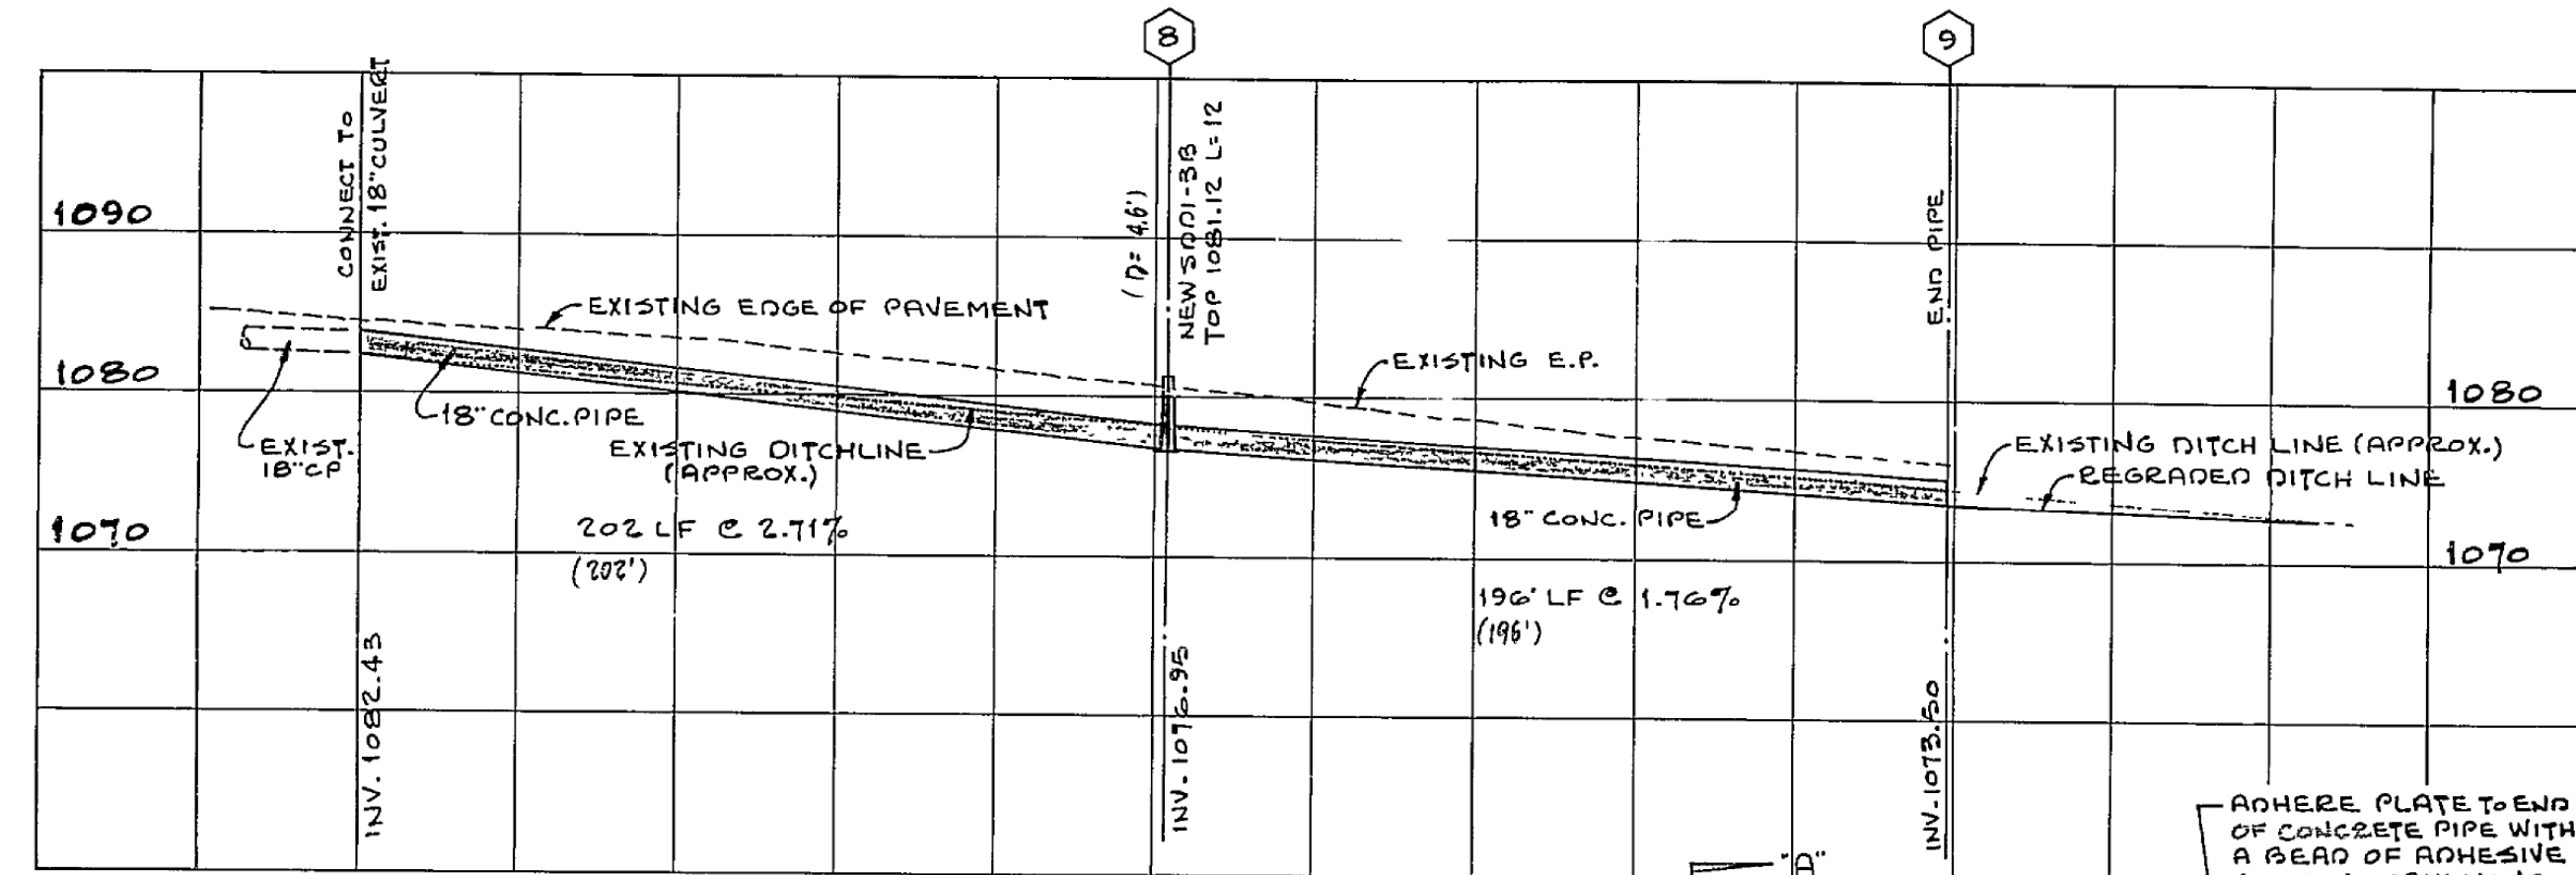

11 DRAINAGE DITCH DETAIL
AT PAVEMENT TAPER
PETERS CREEK ROAD
NO SCALE

INLET	P. 10	O.D.	"X"	R.O.D.
2B	15"	8 1/4"	2 1/4"	19 1/2"
3A	18"	10 5/8"	2 1/2"	23"
5A	15"	7 1/2"	2 1/4"	19 1/2"

NOTES:
1. MAX. DITCH
DEPTH = 7" AT END OF TRANSITION
2. DITCH TO DISCHARGE
TO 18" PIPE OUTFALL.

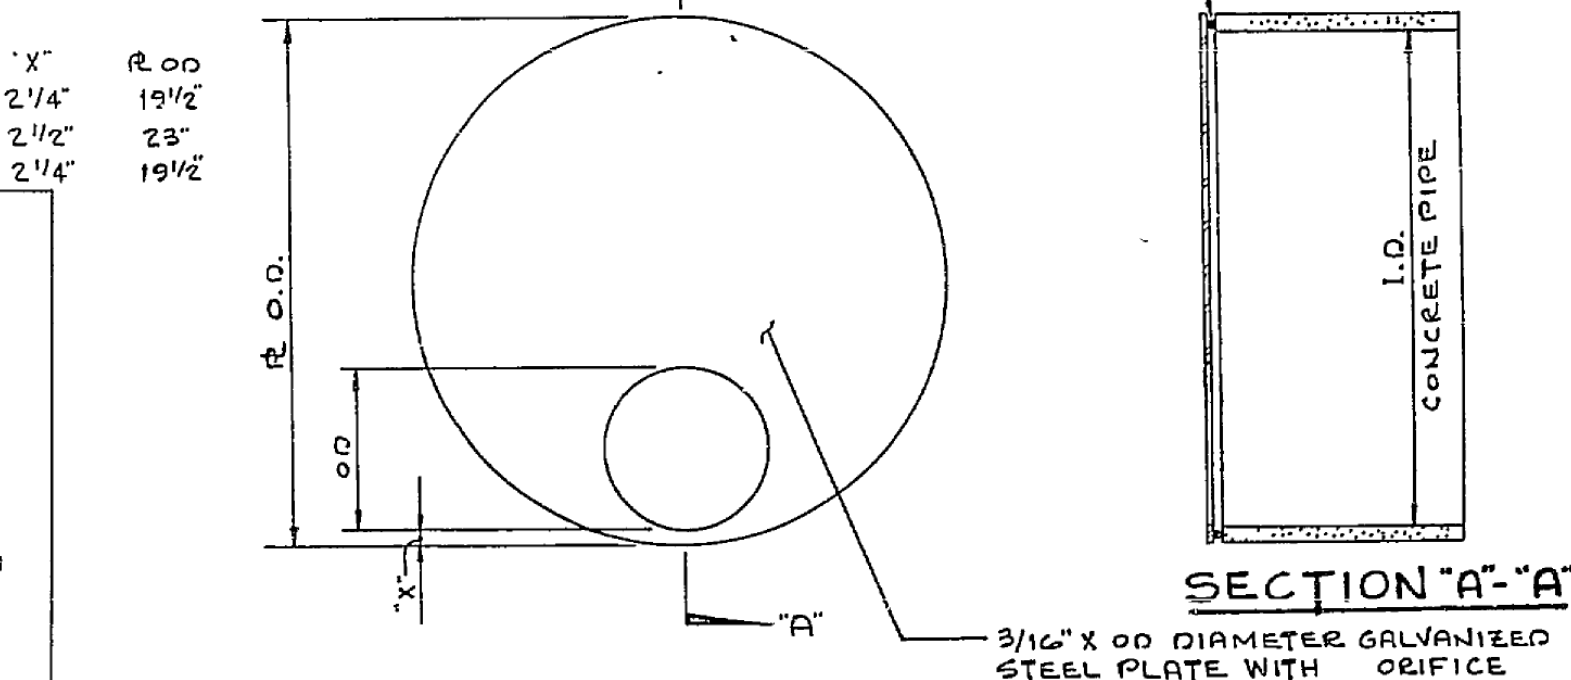

12 DETAIL-OUTFLOW RESTRICTING PLATE
FOR INLETS 2B, 3A & 5A
NO SCALE

DETAILS

"ROANOKE HYUNDAI"

ROANOKE COUNTY, VIRGINIA

OWNER

LEWIS - GIBBS CORPORATION


SCALE: 1" = 40' DATE: 26 FEBRUARY, 1988

3 NOV. 1988 - "AS-BUILT" STORM DRAIN

BUFORD T. LUMSDEN & ASSOCIATES, P.C.

ENGINEERS - SURVEYORS

ROANOKE, VIRGINIA

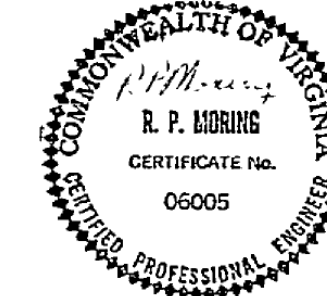

NOTE:
"AS-BUILT" INFORMATION
TAKEN FROM PLANS FURNISHED
BY J.P. TURNER BROTHERS, CONTRACTOR.

"AS-BUILT" DIMENSIONS
SHOWN IN BRACKETS

85-541 G

SHEET #6 OF 10

