

PERMANENT SEDIMENT BASIN PLAN

FOR

ROANOKE QUARRY



ROCKYDALE QUARRIES CORPORATION

LOCATED AT

4592 FRANKLIN ROAD, S.W.

THE CITY OF ROANOKE, VIRGINIA

DATE: September 22, 2017

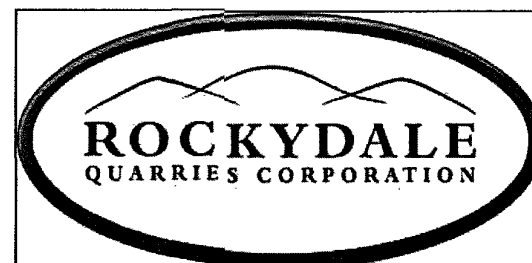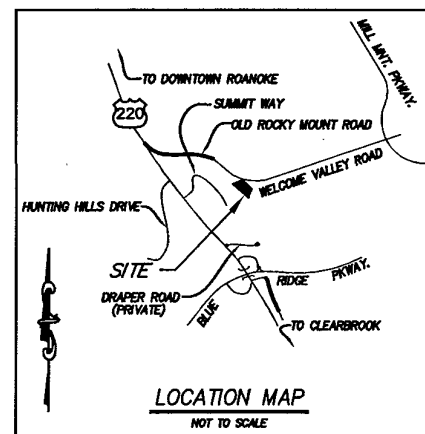

ROCKYDALE QUARRIES CORPORATION

2343 HIGHLAND FARM RD NW

ROANOKE, VA 24017

*As-Built: 12/18/2017
Contractor: Bowman Contracting*