


PROJECT LOCATION MAP

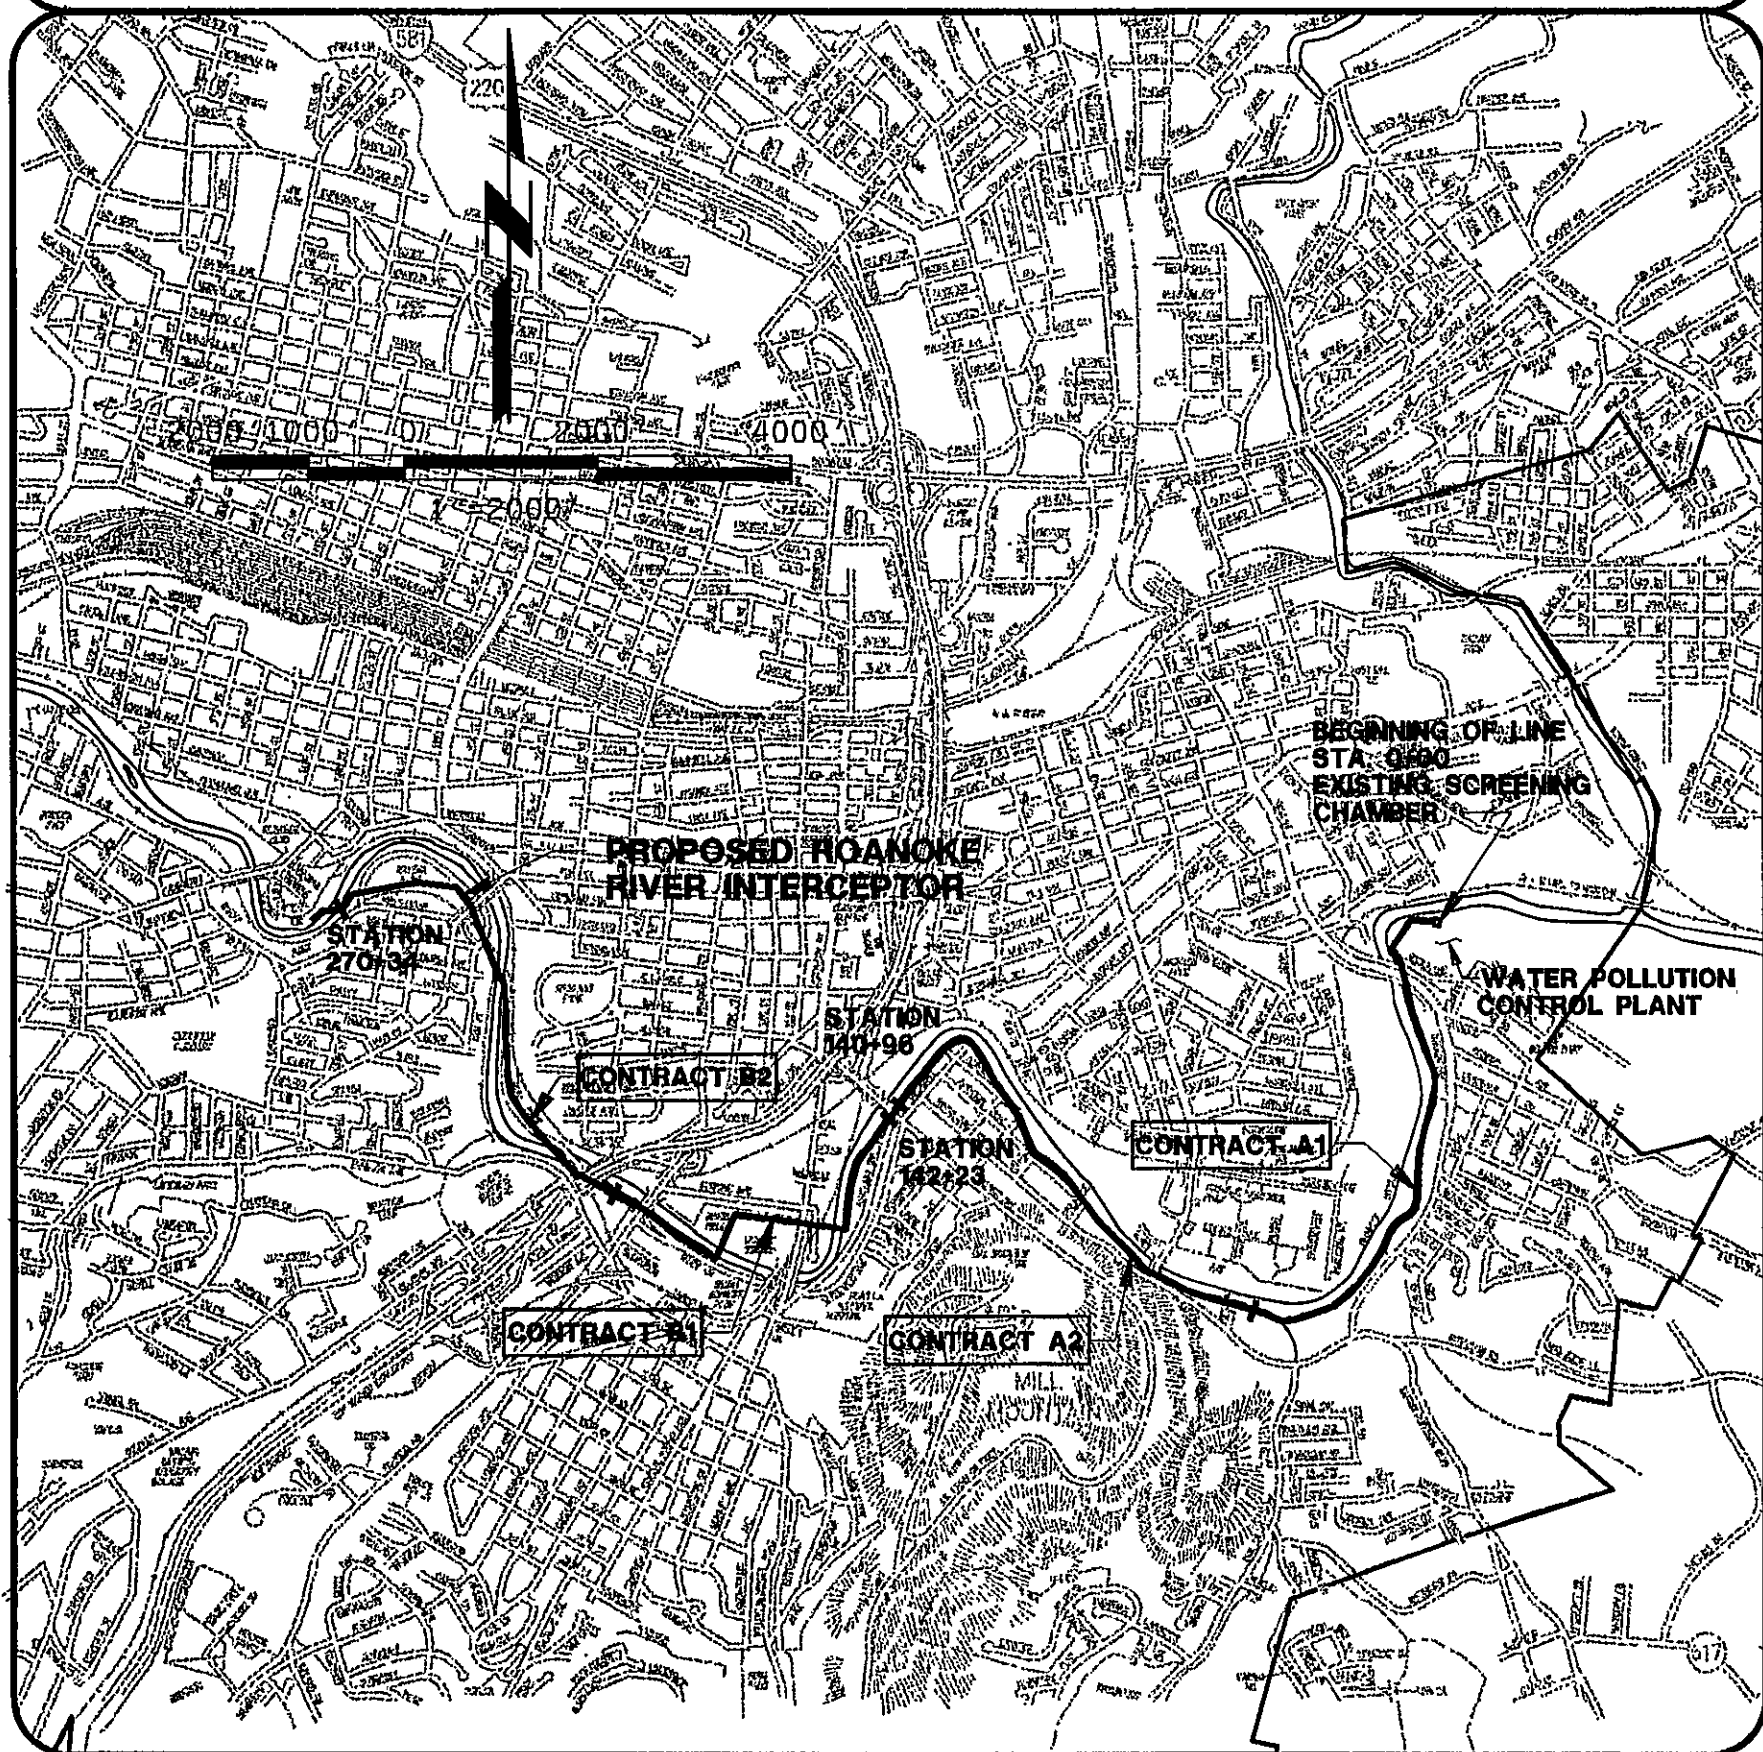

OFFICE OF CITY ENGINEER
ROOM 350
MUNICIPAL BUILDING
215 CHURCH AVENUE, S.W.
ROANOKE, VIRGINIA 24011

INDEX OF SHEETS

SHEET NO	DWG REF NO	TITLE
1.	-	COVER SHEET
2.	G2	LEGEND, ABBREVIATIONS, AND GENERAL NOTES
3.	G3	INDEX MAP
4.	C1	PLAN AND PROFILE-STA 0+00 TO STA 15+00
5.	C2	PLAN AND PROFILE-STA 15+00 TO STA 30+00
6.	C3	PLAN AND PROFILE-STA 30+00 TO STA 45+00
7.	C4	PLAN AND PROFILE-STA 45+00 TO STA 60+00
8.	C5	PLAN AND PROFILE-STA 60+00 TO STA 75+00
9.	C6	PLAN AND PROFILE-STA 75+00 TO STA 90+00
10.	C7	PLAN AND PROFILE-STA 90+00 TO STA 105+00
11.	C8	PLAN AND PROFILE-STA 105+00 TO STA 120+00
12.	C9	PLAN AND PROFILE-STA 120+00 TO STA 135+00
13.	C10	PLAN AND PROFILE-STA 135+00 TO STA 150+00
14.	C11	PLAN AND PROFILE-STA 150+00 TO STA 165+00
15.	C12	PLAN AND PROFILE-STA 165+00 TO STA 180+00
16.	C13	PLAN AND PROFILE-STA 180+00 TO STA 195+00
17.	C14	PLAN AND PROFILE-STA 195+00 TO STA 210+00
18.	C15	PLAN AND PROFILE-STA 210+00 TO STA 225+00
19.	C16	PLAN AND PROFILE-STA 225+00 TO STA 240+00
20.	C17	PLAN AND PROFILE-STA 240+00 TO STA 255+00
21.	C18	PLAN AND PROFILE-STA 255+00 TO STA 270+00
22.	C19	PLAN AND PROFILE-STA 270+00 TO STA 285+00
23.	C33	SITE PLAN-ROANOKE MEMORIAL HOSPITAL AREA
24.	C34	PROFILES-EXISTING MANHOLES TO NEW MANHOLES
25.	C36	MISCELLANEOUS DETAILS
26.	C40	RAILROAD CROSSING DETAILS
27.	C41	MANHOLE DETAILS
28.	C42	MANHOLE DETAILS
29.	C43	MANHOLE SCHEDULE
30.	C44	MISCELLANEOUS DETAILS
		TITLE (DESIGN BY OTHERS)
P-22		MISCELLANEOUS DETAILS
P-39		BENCH CUT AND REC. TRAIL PLAN STA 20+20-32+33 R5
P-40		BENCH CUT AND REC. TRAIL PLAN STA 32+33-41+17 R5
P-41		BENCH CUT AND REC. TRAIL PLAN STA 41+17-54+93 R5

CONSULTING ENGINEERS



B & V PROJECT NUMBER 26444

COMMISSION NUMBER: N/A

THIS DOCUMENT
ORIGINALLY ISSUED
AND SEALED BY
BRENT M. REUSS
PROFESSIONAL ENGINEER,
COMMONWEALTH OF VIRGINIA
REGISTRATION NO. 026345
ON
5-30-97

PROJECT NAME

ROANOKE RIVER INTERCEPTOR
ROANOKE, VIRGINIA
CONTRACTS A1, A2, B1, AND B2

PROJECT NUMBER: 6312

REVISION BY	DESCRIPTION:	DATE
REVISION BY	DESCRIPTION:	DATE
REVISION BY	DESCRIPTION:	DATE
REVISION BY	DESCRIPTION:	DATE

RECORD DRAWING

THIS DRAWING HAS BEEN MODIFIED TO REFLECT
CHANGES MADE DURING CONSTRUCTION BASED
UPON INFORMATION AS MAY BE PROVIDED BY THE
CONTRACTOR AND CONSTRUCTION OBSERVATION
BY THE ENGINEER'S AUTHORIZED REPRESENTATIVE
BY: *[Signature]* DATE: 9/28/97
ENGINEER DATE

APPROVED FOR CONSTRUCTION

ORIGINAL DOCUMENT SIGNED BY CHARLES M. HUFFINE ROANOKE CITY ENGINEER	5-22-97 DATE
ORIGINAL DOCUMENT SIGNED BY WILLIAM F. CLARK DIRECTOR OF PUBLIC WORKS	5-22-97 DATE
ORIGINAL DOCUMENT SIGNED BY KIT B. KISER DIRECTOR OF UTILITIES AND OPERATIONS	5-22-97 DATE
	DATE
	DATE

ADVERTISED DATE: JUNE 1, 1997

SET NUMBER: N/A

SHEET NUMBER: 1 OF 30