

05/28/97 12:28:39 RCD-12

A

B

C

D

E

F

26444-300-WMCC-C-8000001.KY
G1031
F000000

1

2

3

4

5


6

7


8

9


10

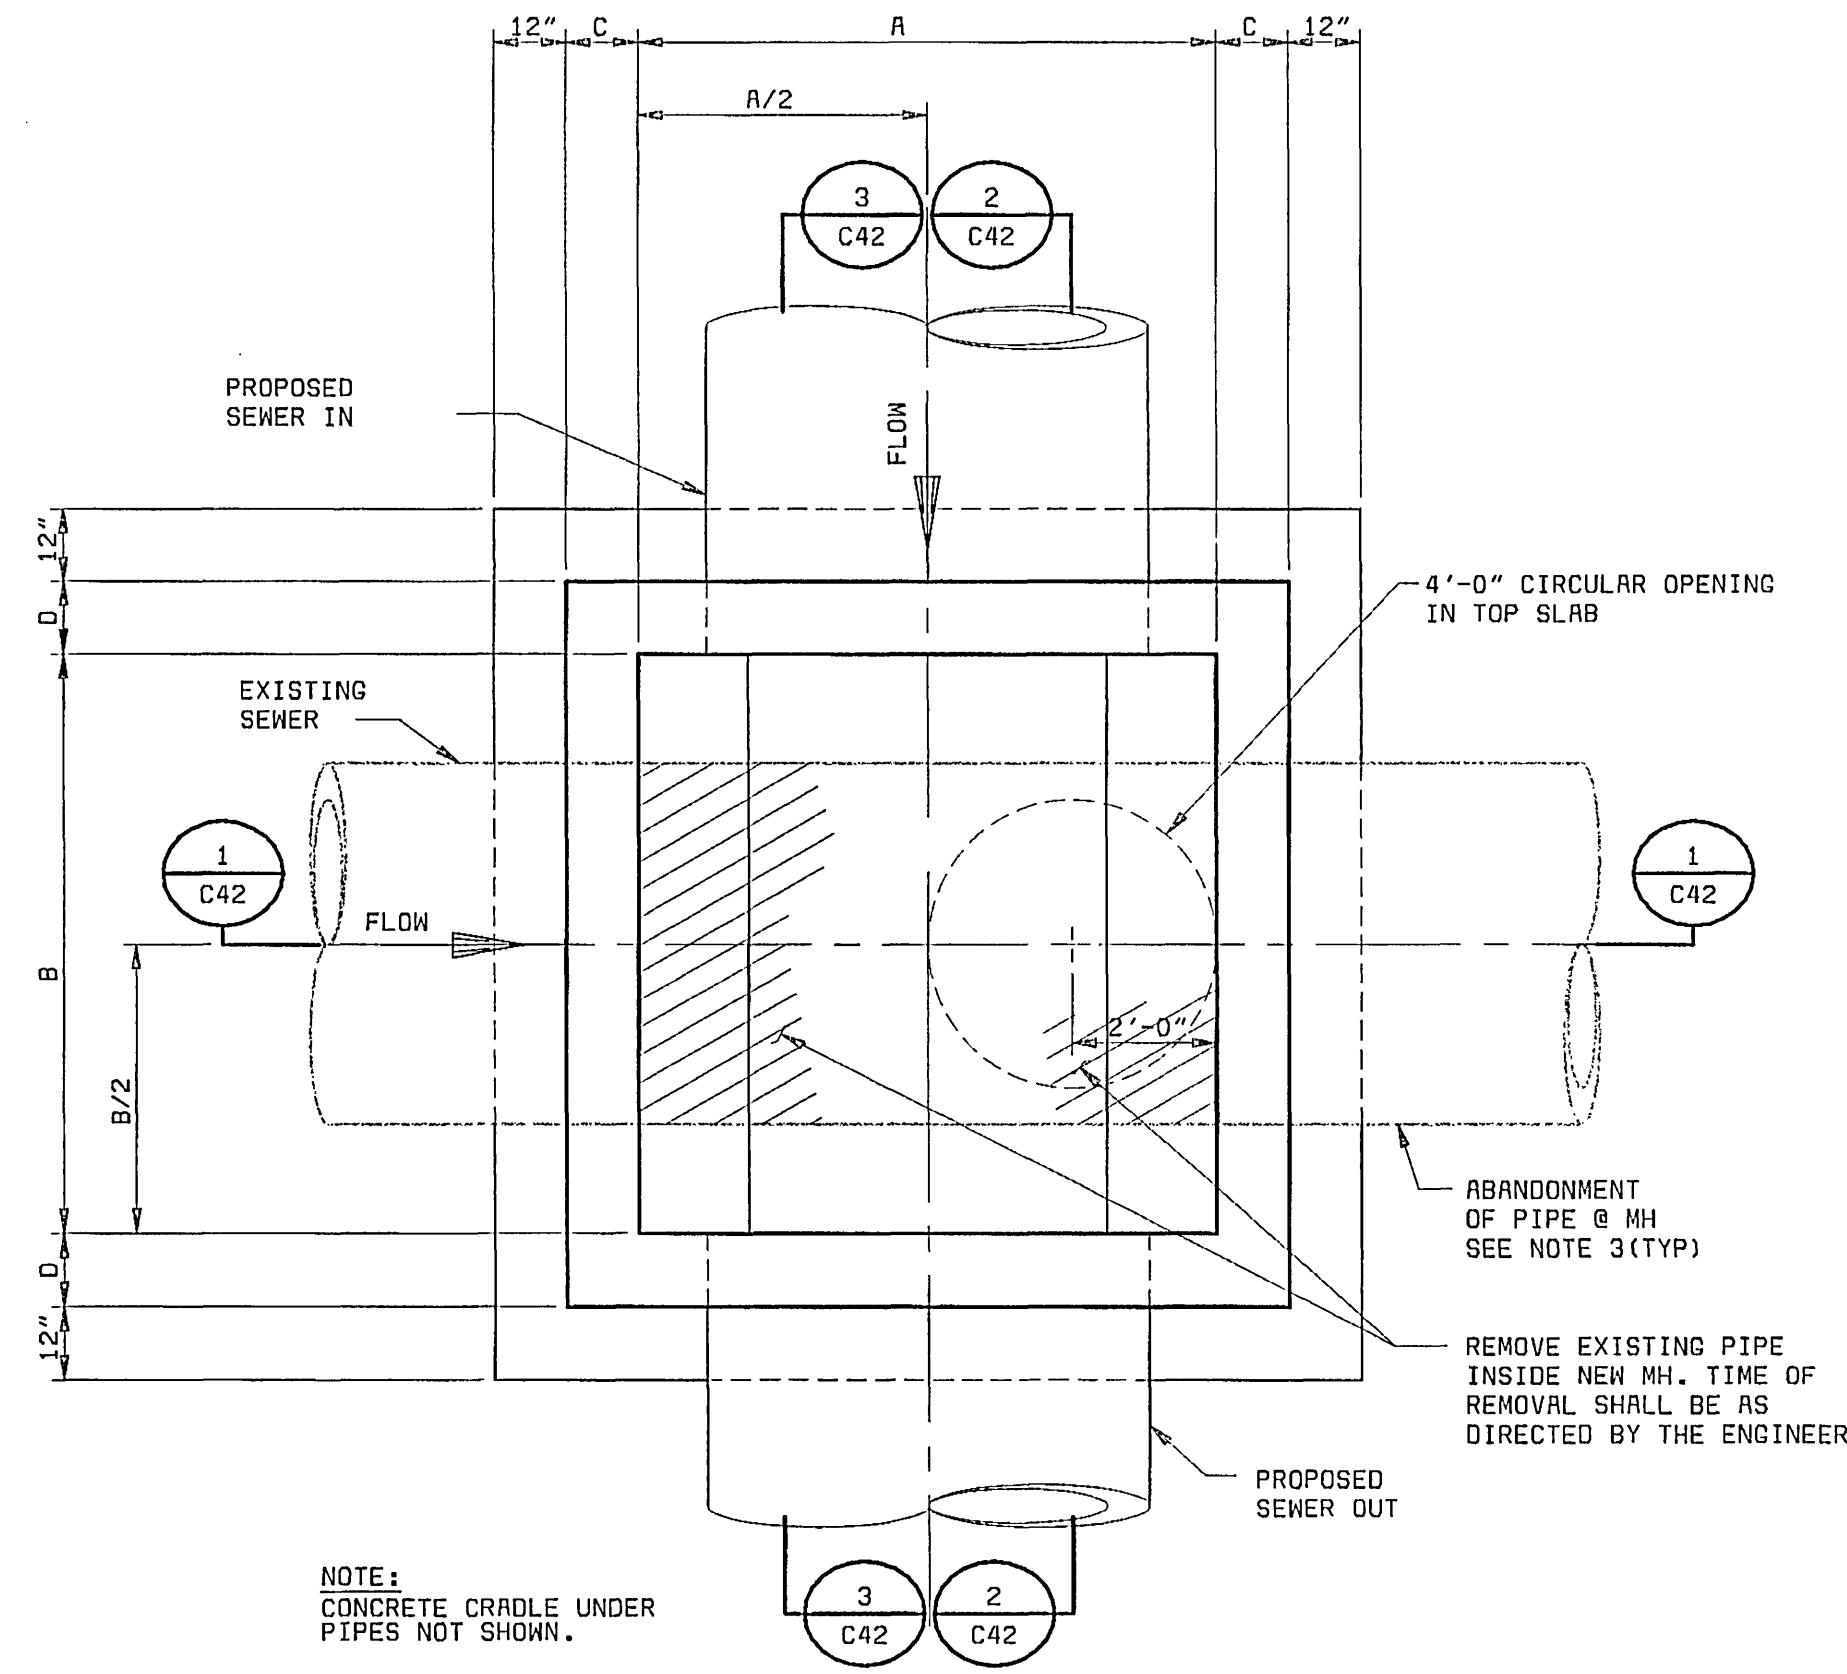


MH BUILT OVER
EXISTING SEWER
3/8" = 1'-0"

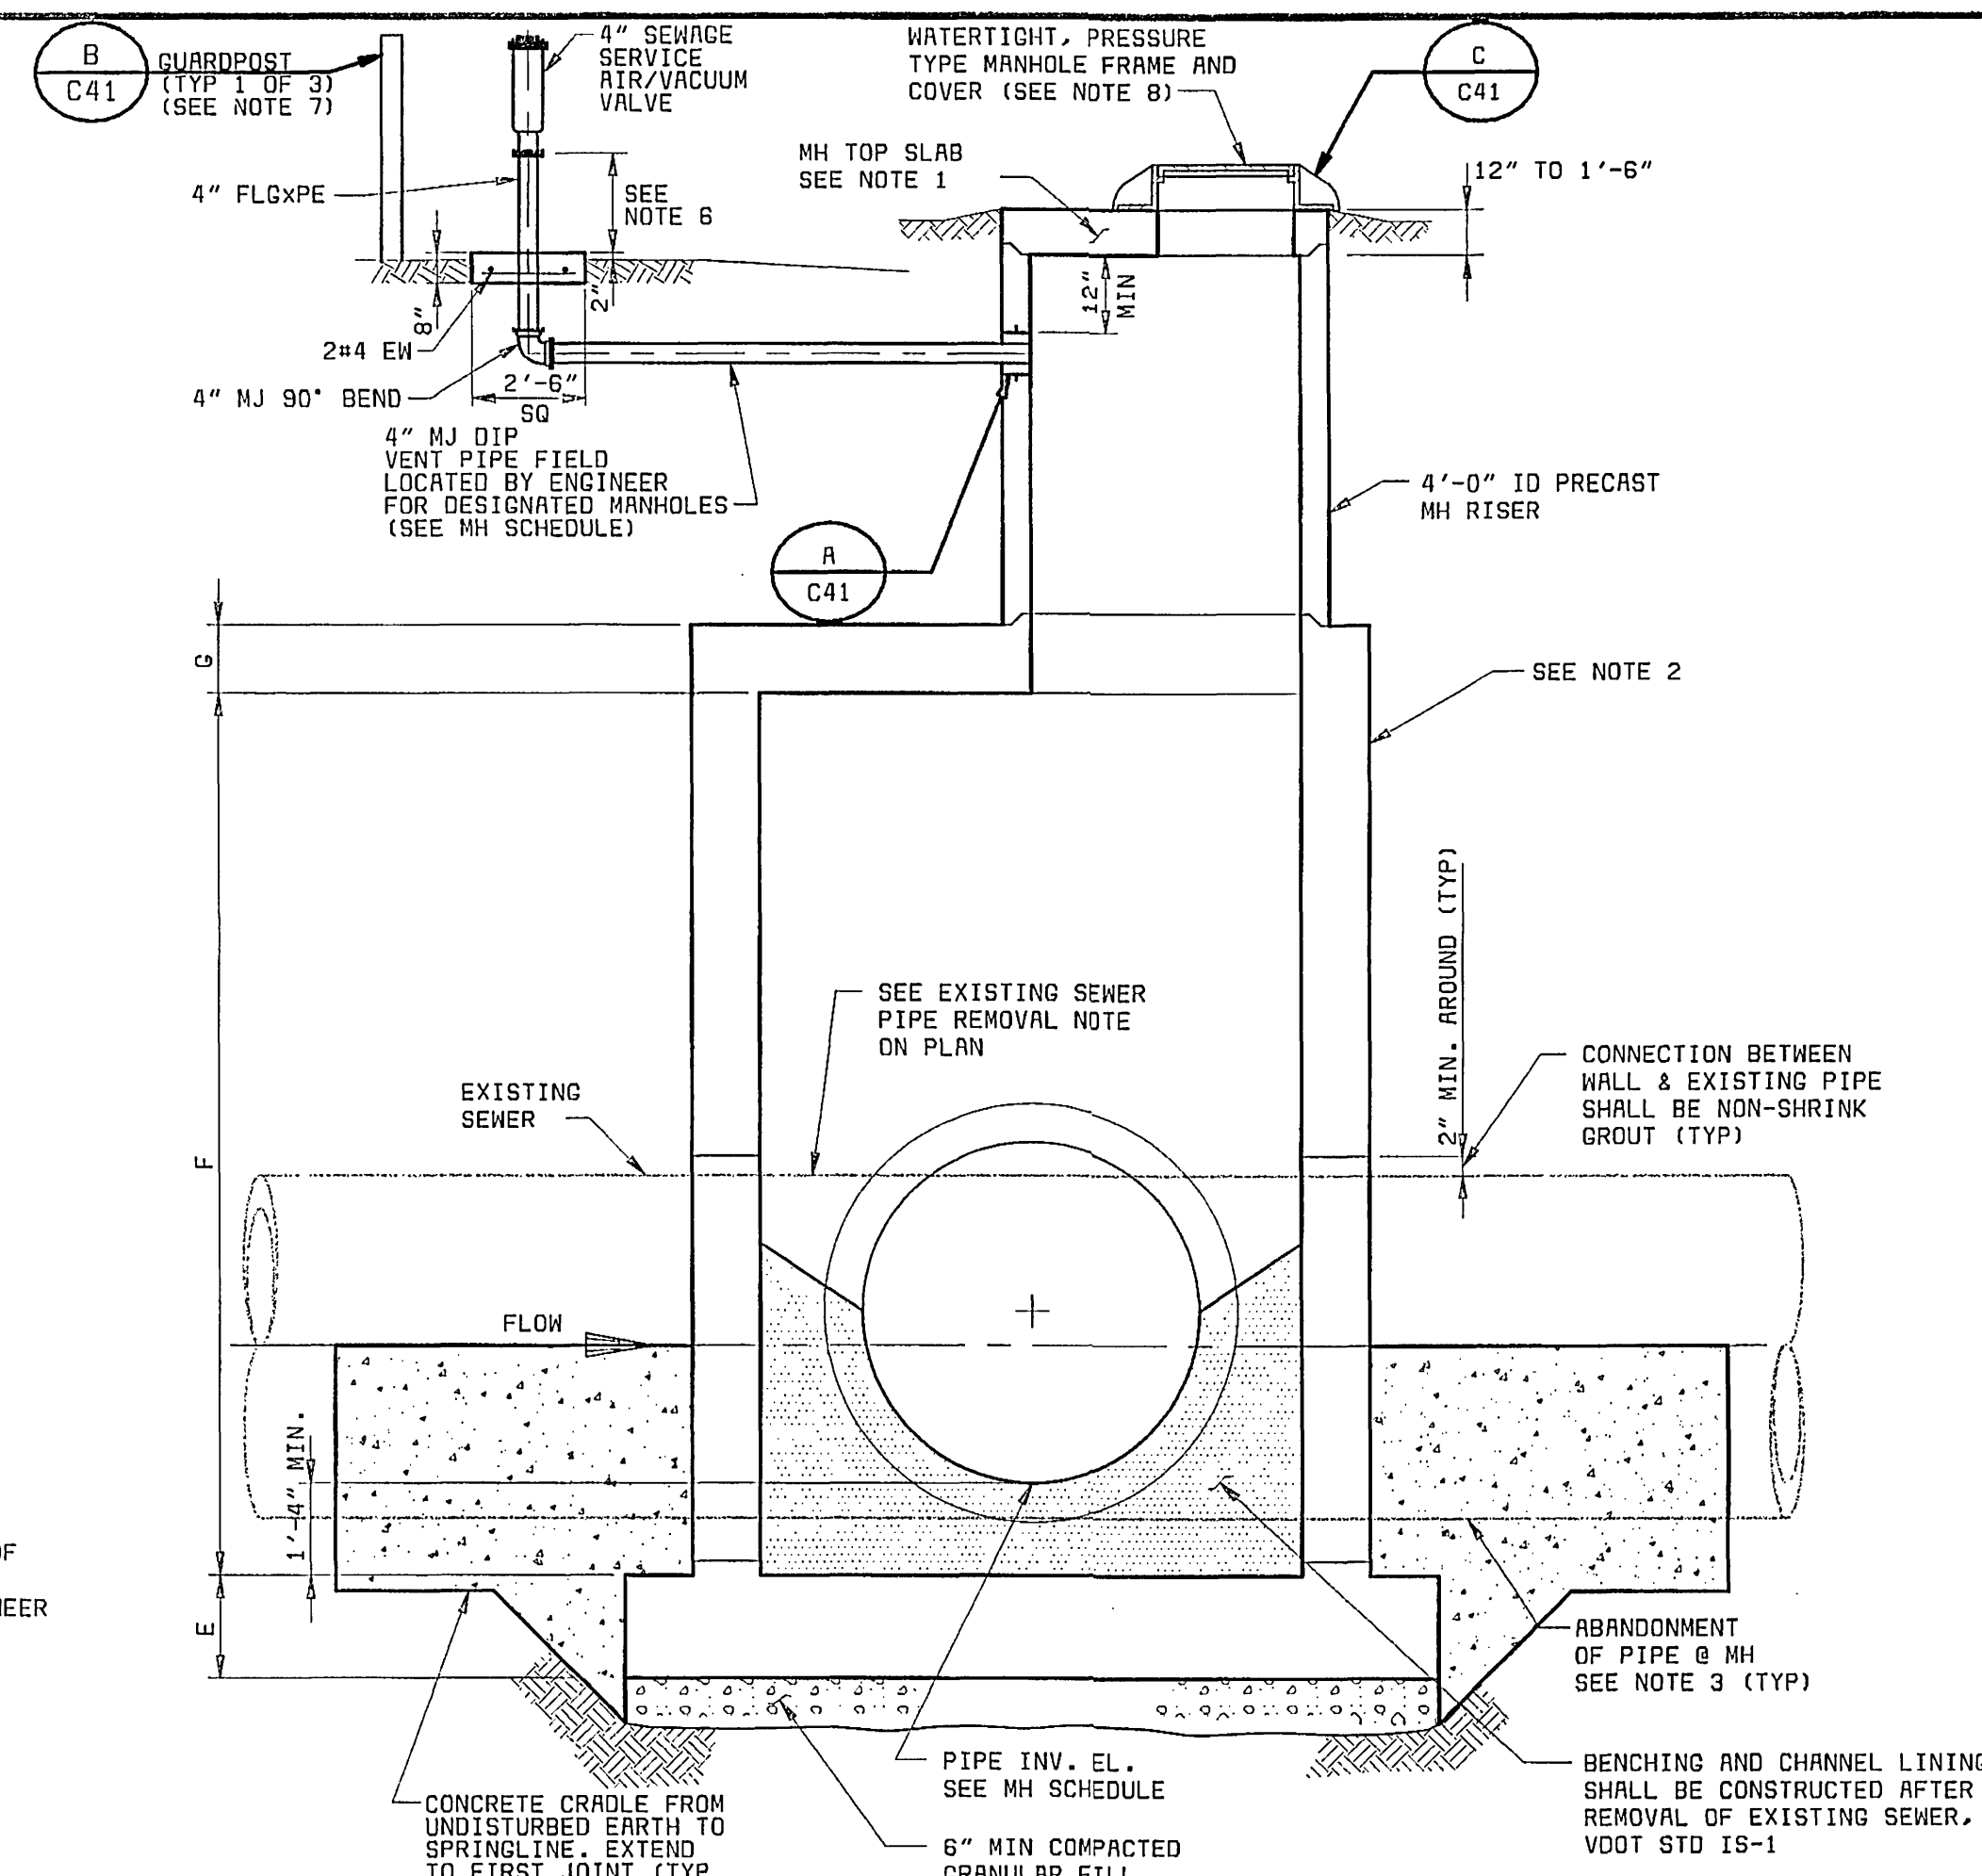

SECTION 1
3/8" = 1'-0"

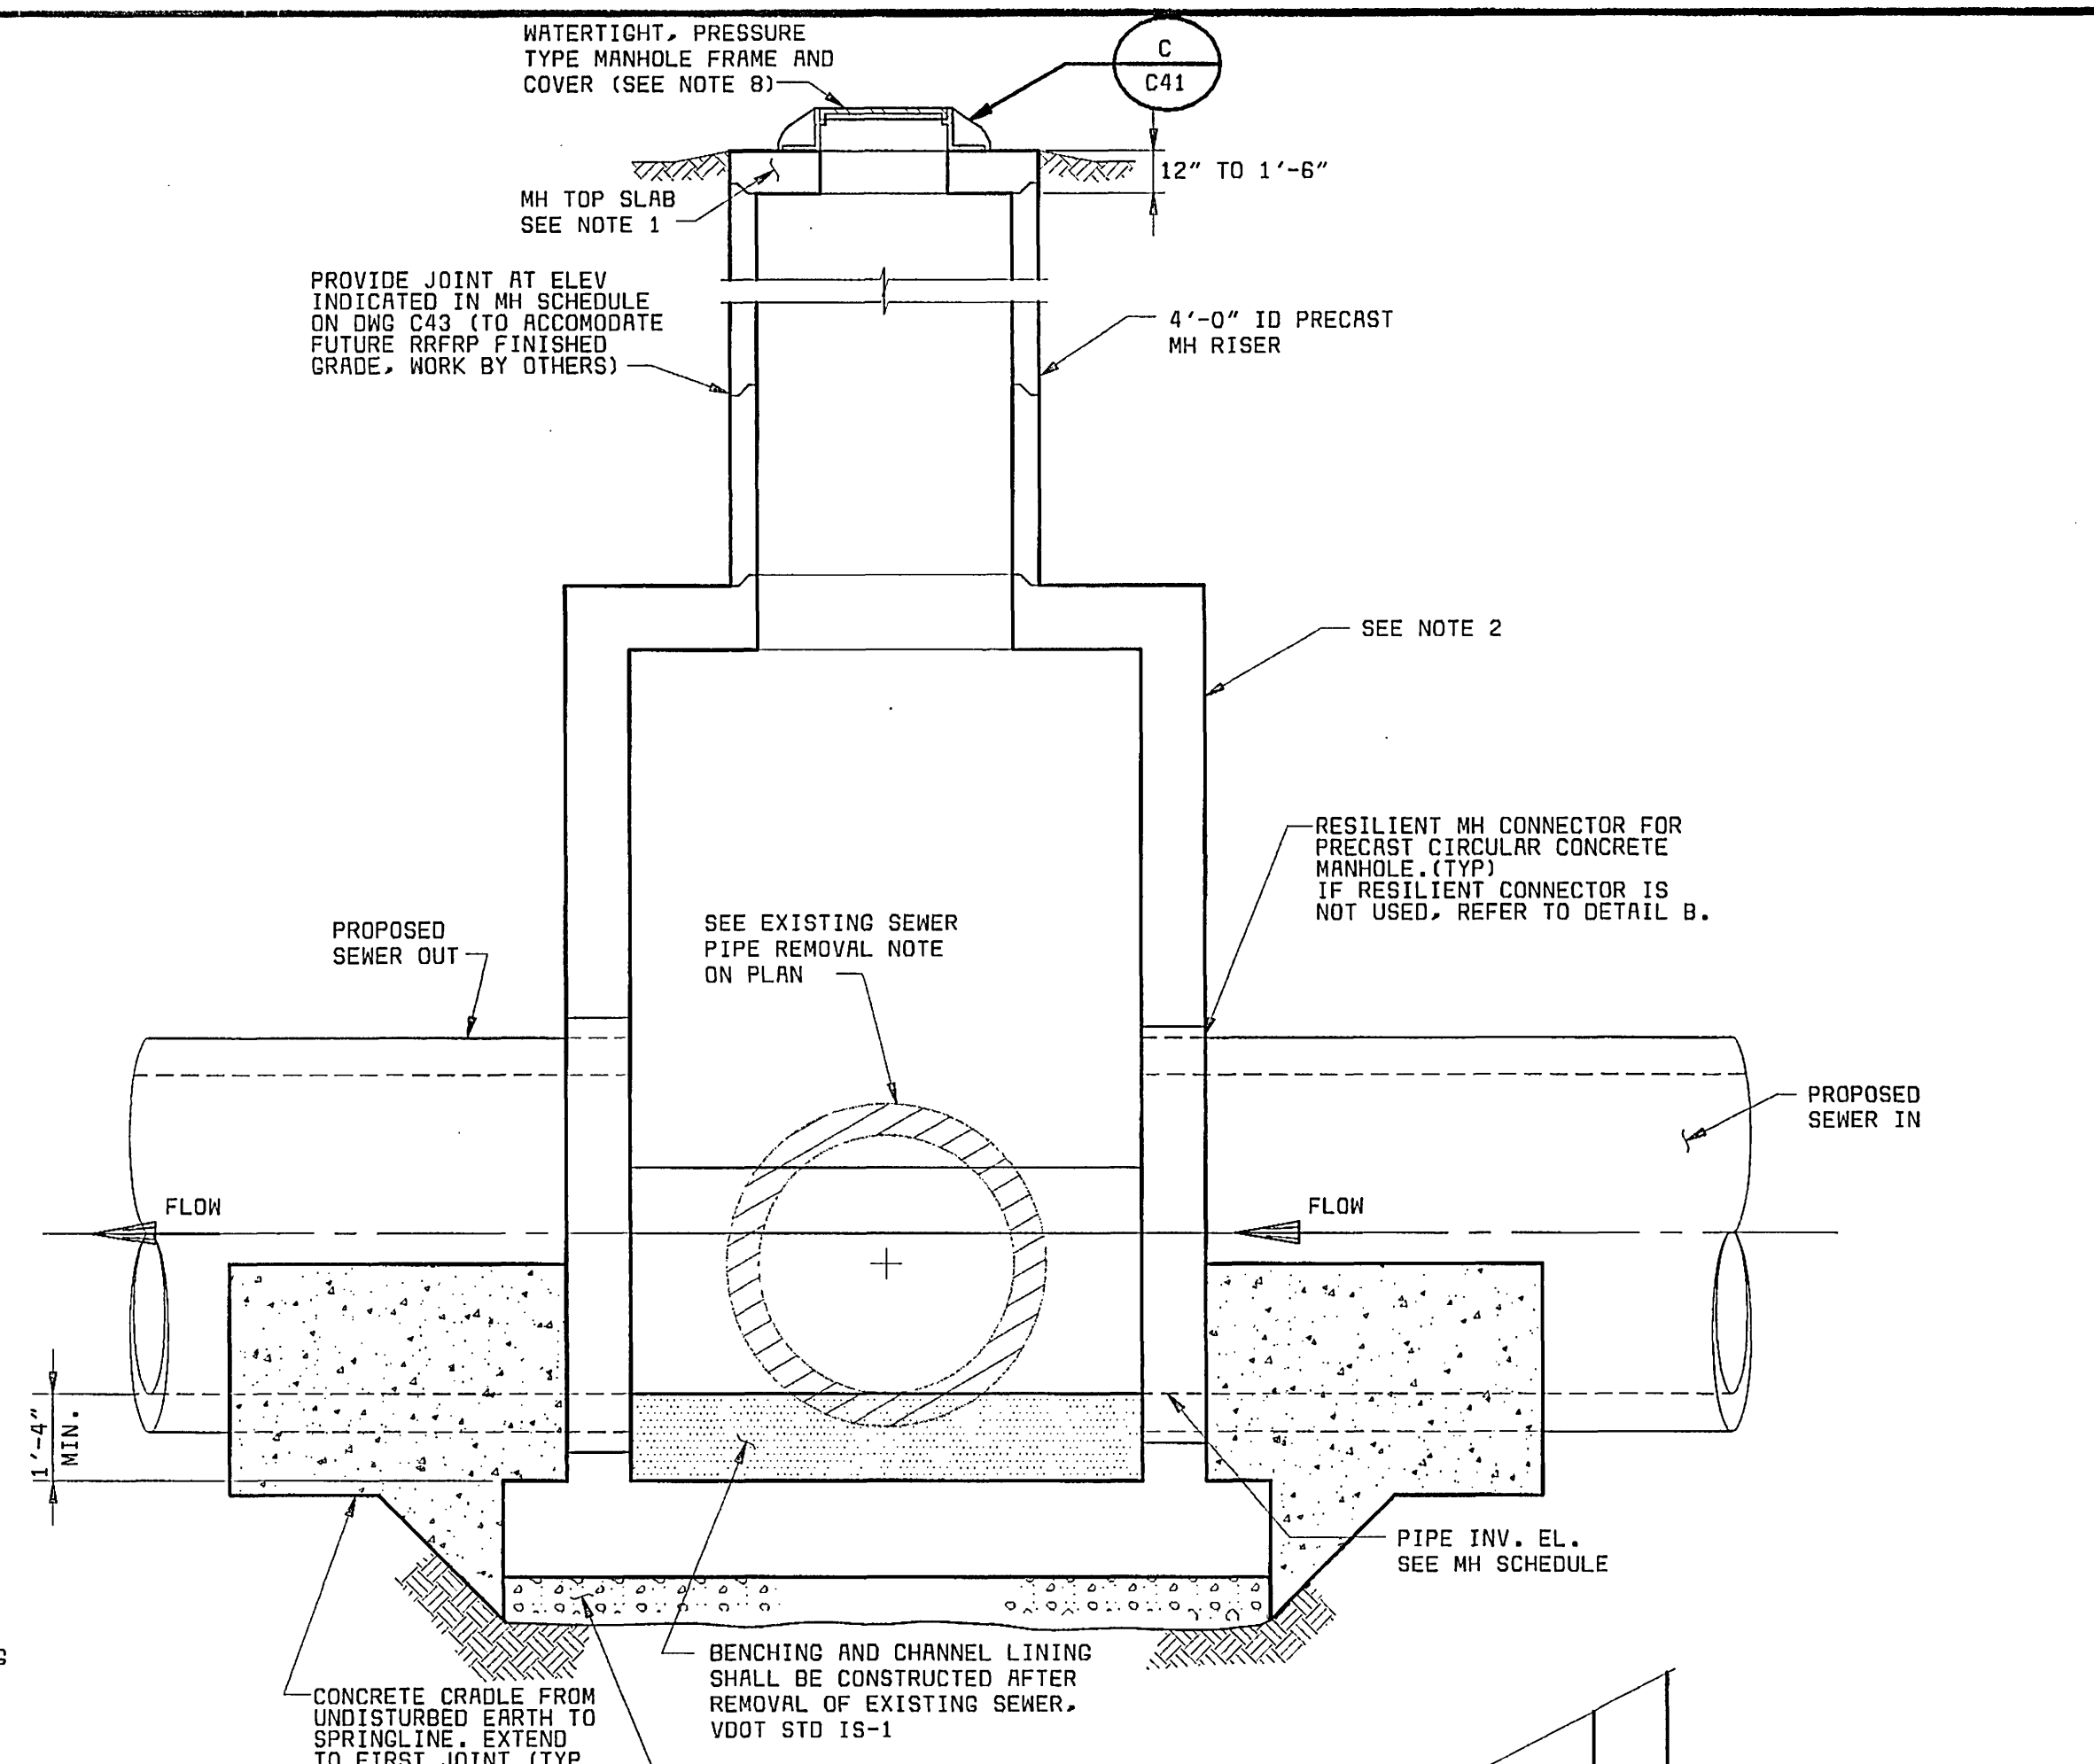

SECTION 2
3/8" = 1'-0"

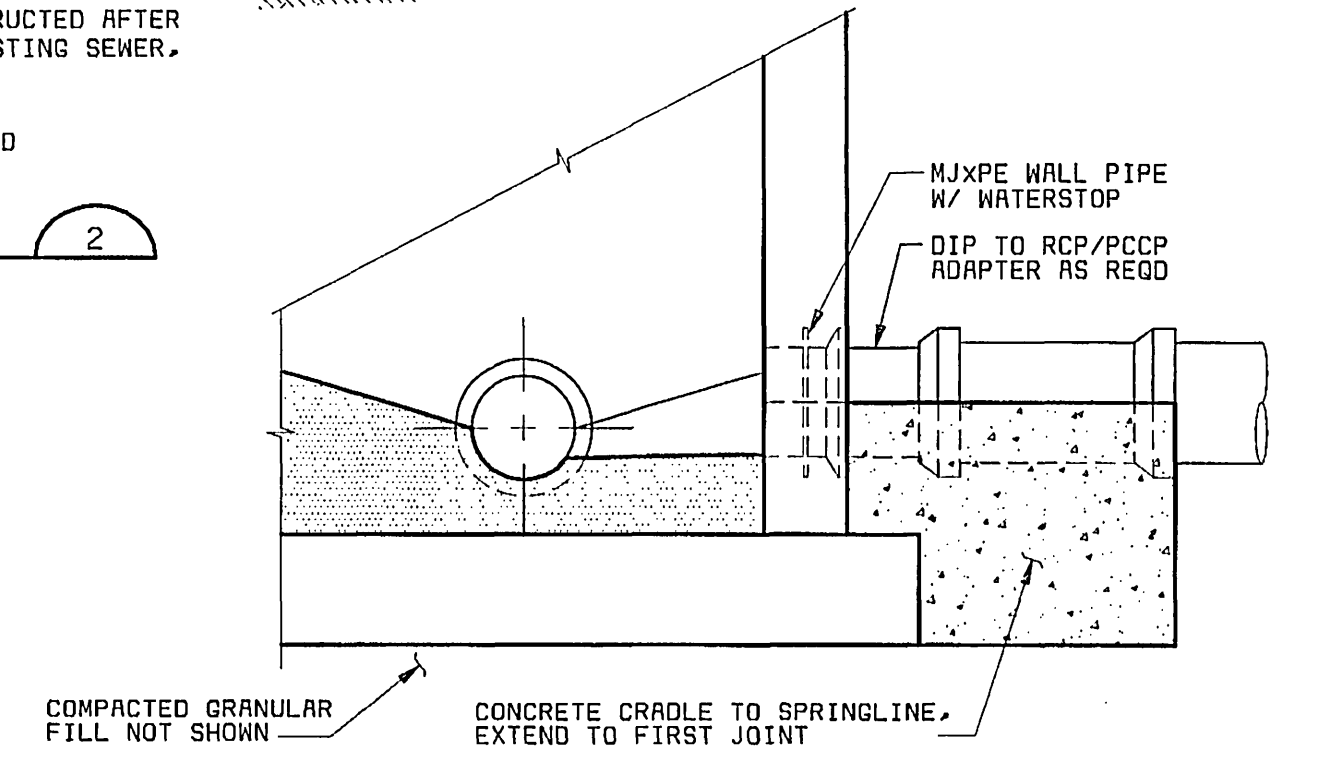

DETAIL B
NO SCALE

- NOTES:
- MANHOLE FABRICATOR SHALL DESIGN AND PROVIDE TYPE III MANHOLES DESIGNED TO RESIST AN INTERNAL HYDROSTATIC HEAD OF 30 FEET OF WATER AND SIMULTANEOUS H-20 EXTERNAL LOADING. CONNECTIONS BETWEEN RISER SECTIONS AND MANHOLE TOP SLAB SHALL BE STRAPPED AND BOLTED TOGETHER WITH EXTERNAL TYPE 316 STAINLESS STEEL JOINT HARNESS. A MINIMUM OF 3 JOINT HARNESSES, EQUALLY SPACED AROUND MANHOLE, SHALL BE USED AT EACH JOINT. BOLTS SHALL NOT EXTEND INTO INSIDE OF MANHOLE. MANHOLE FABRICATOR SHALL DESIGN TOP SLABS TO RESIST A MINIMUM EXTERNAL LOAD OF 20 FEET OF WATER COLUMN OR H-20 LOADING, AND FABRICATE AND PROVIDE SLAB BASED ON THE MORE CONSERVATIVE LOADING CONDITION. MANHOLE SHALL BE ANCHORED TO CAST IN PLACE CONCRETE BASE BY EXTENDING EXPOSED BAR CAGE REINFORCING FROM BOTTOM SECTION OF RISER SECTION A MINIMUM OF 18 INCHES INTO MANHOLE BASE AND SHALL BE BASE REINFORCING. MANHOLE FABRICATOR SHALL ENGAGE A PROFESSIONAL ENGINEER REGISTERED IN THE COMMONWEALTH OF VIRGINIA TO DESIGN THE PRESSURE MANHOLE COMPLETE WITH JOINT RESTRAINT AND BASE ANCHORAGE SYSTEM. CONSTRUCTION DRAWINGS BEARING THE SEAL OF THE REGISTERED ENGINEER SHALL BE SUBMITTED TO THE ENGINEER PRIOR TO BEGINNING MANHOLE FABRICATION.
 - PRECAST CONCRETE MANHOLE DESIGNED PER DIMENSIONS IN MANHOLE SCHEDULE AND LOADINGS IN NOTE 1, OR PRECAST CIRCULAR CONCRETE MANHOLE DESIGNED PER LOADS IN NOTE 1, MINIMUM INSIDE DIMENSION A IN MANHOLE SCHEDULE. MANHOLE SHALL HAVE "DOORHOUSE" BASE TO FIT OVER EXISTING SEWER.
 - AT TIME DIRECTED BY ENGINEER, SEWER TO BE ABANDONED SHALL BE COMPLETELY DISCONNECTED FROM MANHOLE BY CUTTING PIPE INSIDE MANHOLE AND PLUGGING ABANDONED SEWER AND MANHOLE WALL WITH WATERTIGHT MASONRY.
 - IF A DROP CONNECTION IS REQUIRED FOR USE WITH TYPE III MH, REFER TO TYPE II MANHOLE "STANDARD DROP MANHOLE" DETAIL ON DRAWING C41.
 - AT CONTRACTOR'S OPTION, TYPE I OR TYPE III MANHOLES MAY BE USED WITH 48" RCP, RCP, OR DIP. MANHOLE TYPES FOR 60" AND 60" PCCP AND RCP SHALL BE AS SPECIFIED IN MH SCHEDULE ON DRAWING C43.
 - TERMINATE AIR/VACUUM VALVE AT ELEVATION AS INDICATED IN MH SCHEDULE, DMC C43.
 - PLACE 3 GUARDPOSTS 2'-6" UPSTREAM OF CENTERLINE OF VALVE ASSEMBLY, SPACED 2'-0" ON CENTERS.
 - WHERE MANHOLES ARE INSTALLED IN PAVED AREAS, COVER SHALL BE FLUSH WITH FINISHED GRADE.

RECORD DRAWING

THIS DRAWING HAS BEEN MODIFIED TO REFLECT CHANGES MADE DURING CONSTRUCTION BASED UPON INFORMATION AS MAY BE PROVIDED BY THE CONTRACTOR AND CONSTRUCTION OBSERVATION BY THE ENGINEER'S AUTHORIZED REPRESENTATIVE

BY: *[Signature]* 9/10/00
ENGINEER DATE

TYPE III MANHOLE

MANHOLE SCHEDULE - TYPE III FOR PCCP													
MATERIAL	MH NO.	SEWER IN ² SIZE	SEWER OUT ² SIZE	CONNECTIONS EXIST ² NEW ³	FUTURE OUTLETS ⁴	A	B	C	D	E	F1	G	COMMENTS ¹
PCCP	RR-202	66"	66"	16"	-	9'-0"	5'-0"	←	PER HYDROSTATIC HEAD AND H-20 LOADING AS REQUIRED	→			FIELD LOCATE OVER EXISTING SEWER
PCCP	RR-214	66"	66"	SIPHONS	18"	9'-0"	5'-0"	←	PER HYDROSTATIC HEAD AND H-20 LOADING AS REQUIRED	→			FIELD LOCATE OVER EXISTING SEWER
PCCP	RR-218	66"	66"	-	24"	9'-0"	5'-0"	←	PER HYDROSTATIC HEAD AND H-20 LOADING AS REQUIRED	→			FIELD LOCATE OVER EXISTING SEWER
PCCP	RR-224	66"	66"	10"	10"	9'-0"	5'-0"	←	PER HYDROSTATIC HEAD AND H-20 LOADING AS REQUIRED	→			FIELD LOCATE OVER EXISTING SEWER
PCCP	RR-237	66"	66"	SIPHONS	-	9'-0"	9'-0"	←	PER HYDROSTATIC HEAD AND H-20 LOADING AS REQUIRED	→			FIELD LOCATE OVER EXISTING SEWER
PCCP	RR-242	66"	66"	16"	36"	9'-0"	5'-0"	←	PER HYDROSTATIC HEAD AND H-20 LOADING AS REQUIRED	→			FIELD LOCATE OVER EXISTING SEWER
PCCP	RR-245	66"	66"	-	18"	9'-0"	5'-0"	←	PER HYDROSTATIC HEAD AND H-20 LOADING AS REQUIRED	→			FIELD LOCATE OVER EXISTING SEWER
PCCP	RR-251	66"	66"	SIPHONS	24"	18"	9'-0"	9'-0"	←	PER HYDROSTATIC HEAD AND H-20 LOADING AS REQUIRED	→		FIELD LOCATE OVER EXISTING SEWER
PCCP	RR-252A	66"	66"	SIPHONS	-	9'-0"	5'-0"	←	PER HYDROSTATIC HEAD AND H-20 LOADING AS REQUIRED	→			FIELD LOCATE OVER EXISTING SEWER
PCCP	RR-253A	48"	48"	-	36"	8'-0"	5'-0"	←	PER HYDROSTATIC HEAD AND H-20 LOADING AS REQUIRED	→			FIELD LOCATE OVER EXISTING SEWER
PCCP	RR-254	66"	66"	8"	-	9'-0"	5'-0"	←	PER HYDROSTATIC HEAD AND H-20 LOADING AS REQUIRED	→			FIELD LOCATE OVER EXISTING SEWER
PCCP	RR-258	66"	66"	-	8"	9'-0"	5'-0"	←	PER HYDROSTATIC HEAD AND H-20 LOADING AS REQUIRED	→			FIELD LOCATE OVER EXISTING SEWER
- MANHOLE SCHEDULE NOTES:
- MINIMUM F DIMENSION IS 8'-0"
 - INVERT ELEVATION FOR NEW SEWER IN AND NEW SEWER OUT SHALL BE AS INDICATED ON DMC C1-C19.
 - INVERT ELEVATION FOR NEW MANHOLE CONNECTIONS SHALL BE AS INDICATED IN THE MANHOLE PROFILES ON DMC C34.
 - OUTLETS FOR FUTURE CONNECTIONS CAST INTO TYPE III MANHOLES SHALL BE 2" MIN. DIAMETER CAST IRON WALL PIPES WITH RESTRAINED NJ PLUGS ON THE EXTERIOR SIDE. ELEVATION AND SIZE OF THE OUTLET SHALL BE AS INDICATED IN THE MANHOLE SCHEDULE ON DMC C43. OUTLETS SHALL FACE THE ROANOKE RIVER SIDE OF THE INTERCEPTOR UNLESS SPECIFIED OTHERWISE ON DMC C1-C19.
 - TYPE III MANHOLES PROPOSED FOR LOCATION OVER EXISTING SEWERS SHALL BE FIELD LOCATED OVER THE SEWER, COORDINATES PROVIDED ON DMC C1-C19 ARE APPROXIMATE FOR THESE MANHOLES. THE EXISTING PIPE SHALL BE SUPPORTED AS NECESSARY AND FLOW MAINTAINED THROUGH THE NEW MANHOLE UNTIL SUCH TIME AS DIRECTED BY ENGINEER. THE EXISTING PIPE INSIDE THE NEW MANHOLES SHALL THEN BE REMOVED, THE DOWNSTREAM CONNECTION PLUGGED, AND BENCHING/CHANNEL LINING CONSTRUCTED AS INDICATED ON DMC C42 FOR MANHOLES RR-202, RR-214, RR-224, RR-242, RR-253A, RR-254, RR-262, RR-267, AND RR-277. EXISTING SEWERS IN MANHOLES RR-237 AND RR-252A ARE PROPOSED TO BE ABANDONED AND SHALL BE PLUGGED ON BOTH SIDES OF THE NEW MANHOLE AS INDICATED ON DMC C42 AT TIME DIRECTED BY ENGINEER.

DESIGNED JBB.SLF
DETAILED ABW
CHECKED RAF
APPROVED
DATE



PROJECT NO.
26444

CITY OF ROANOKE, VIRGINIA
ROANOKE RIVER INTERCEPTOR

MANHOLE DETAILS

THIS DOCUMENT
ORIGINALLY ISSUED
AND SEALED BY
BRENT M. REUSS
PROFESSIONAL ENGINEER,
COMMONWEALTH OF VIRGINIA
REGISTRATION NO. 026345
ON
5-30-97

C42
SHEET
28 OF 30