


PROJECT LOCATION MAP

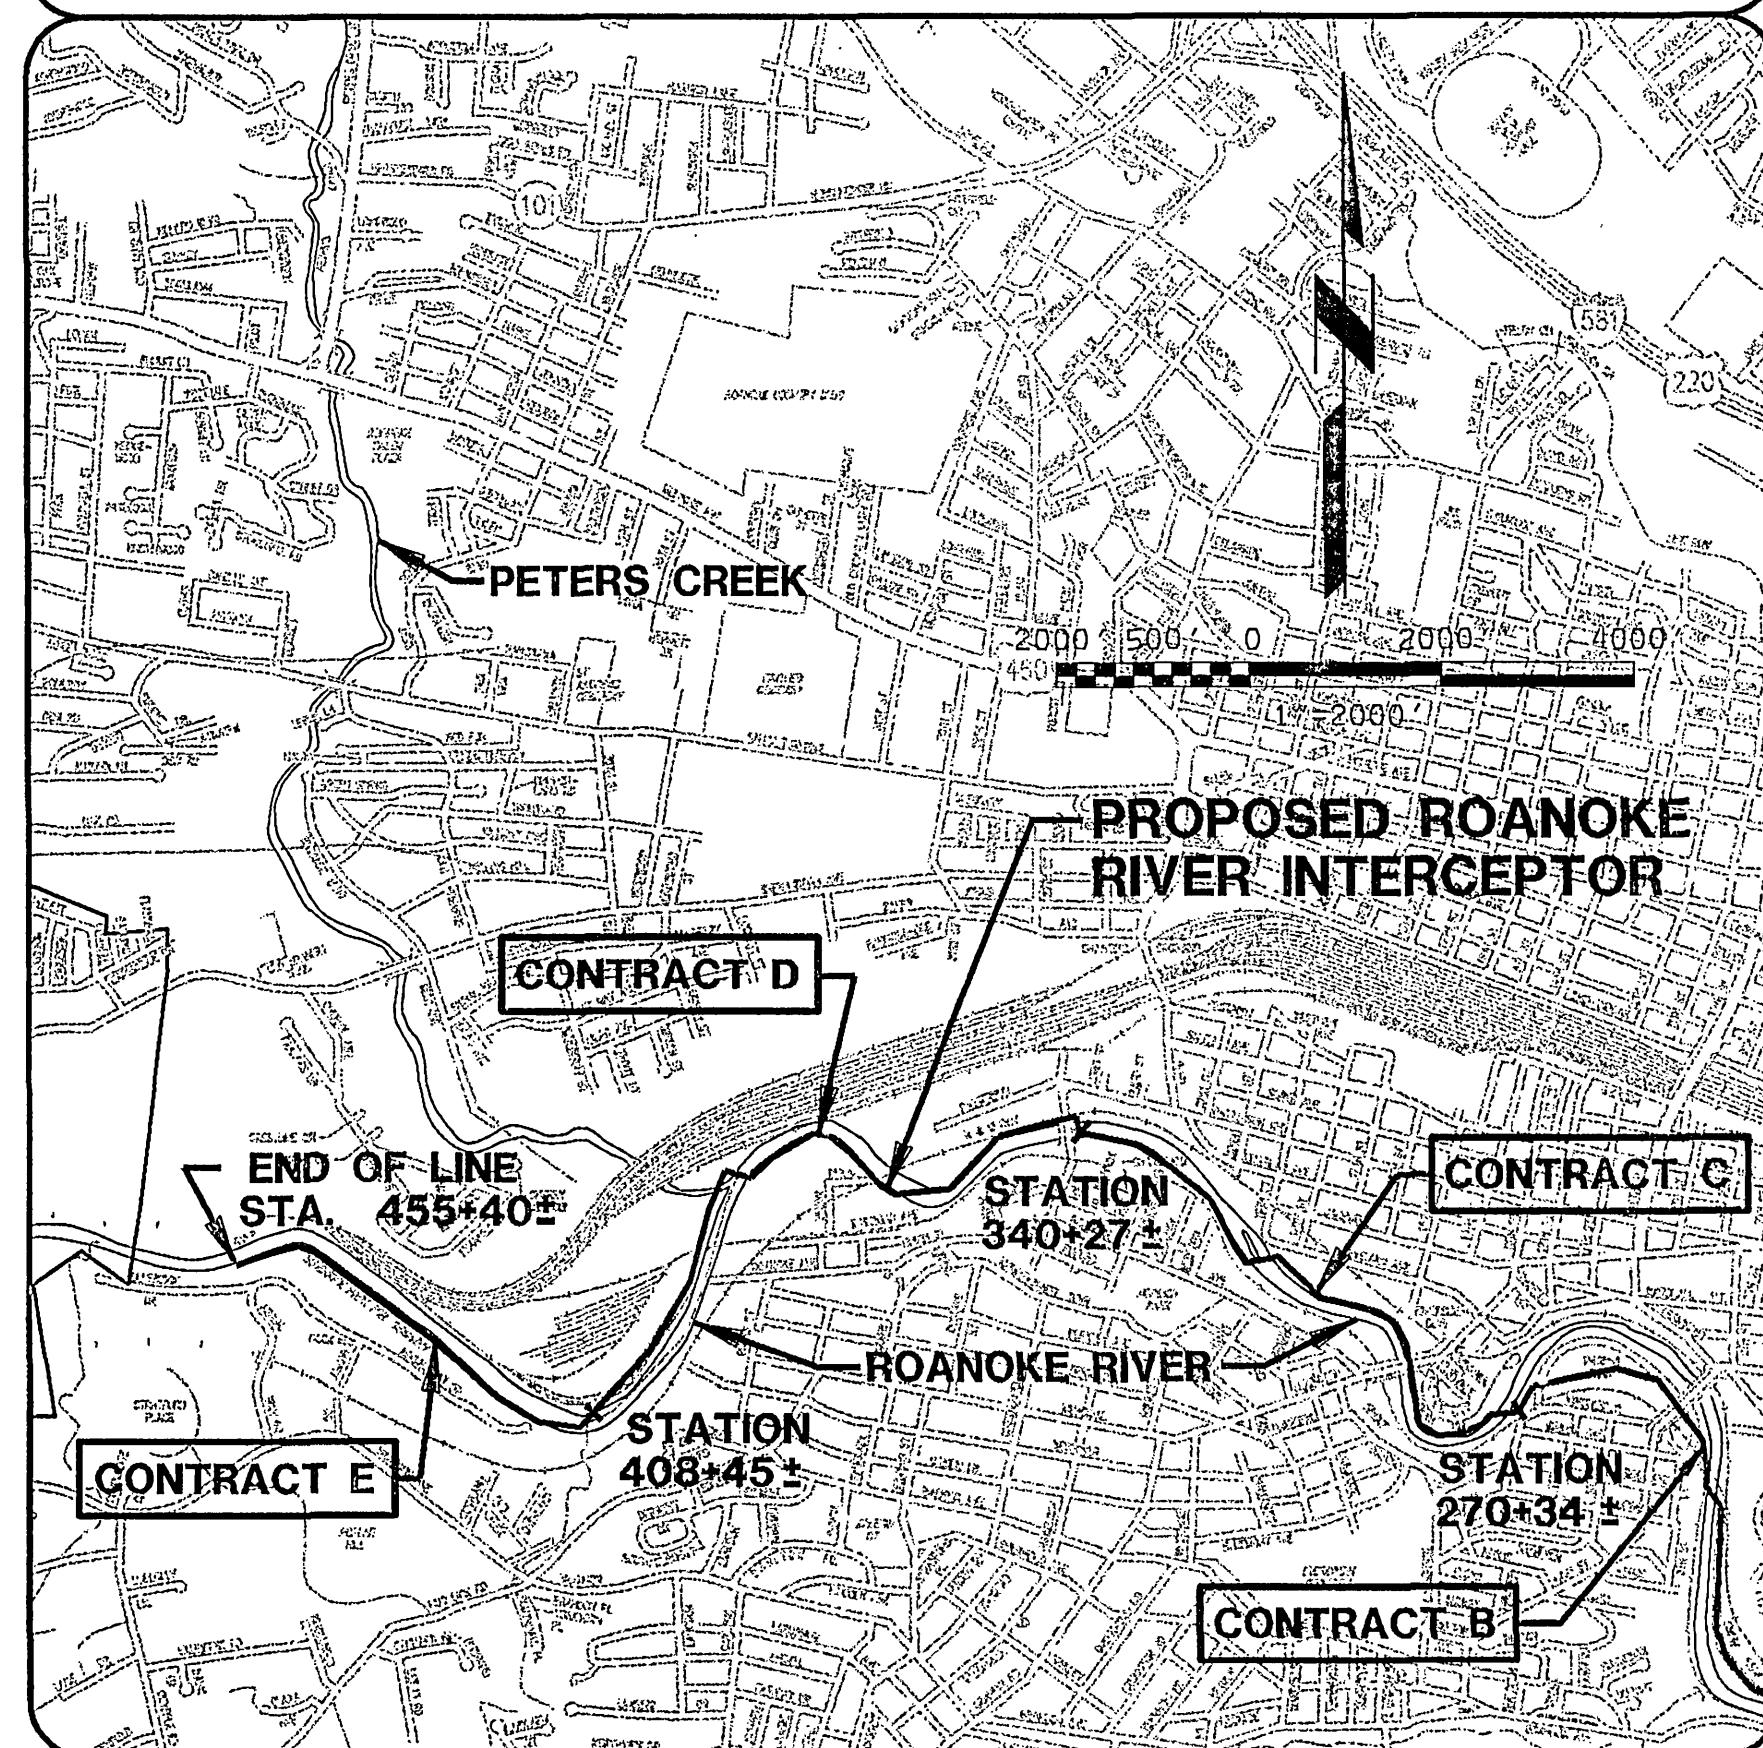

OFFICE OF CITY ENGINEER
ROOM 350
MUNICIPAL BUILDING
215 CHURCH AVENUE, S.W.
ROANOKE, VIRGINIA 24011

INDEX OF SHEETS

SHEET NO	DWG REF NO	TITLE
1	-	COVER SHEET
2	G2	LEGEND, ABBREVIATIONS, AND GENERAL NOTES
3	G3	INDEX MAP
4	C19	PLAN AND PROFILE-STA 270+00 TO STA 285+00
5	C20	PLAN AND PROFILE-STA 285+00 TO STA 300+00
6	C21	PLAN AND PROFILE-STA 300+00 TO STA 315+00
7	C22	PLAN AND PROFILE-STA 315+00 TO STA 330+00
8	C23	PLAN AND PROFILE-STA 330+00 TO STA 345+00
9	C24	PLAN AND PROFILE-STA 345+00 TO STA 360+00
10	C25	PLAN AND PROFILE-STA 360+00 TO STA 375+00
11	C26	PLAN AND PROFILE-STA 375+00 TO STA 390+00
12	C27	PLAN AND PROFILE-STA 390+00 TO STA 405+00
13	C28	PLAN AND PROFILE-STA 405+00 TO STA 420+00
14	C29	PLAN AND PROFILE-STA 420+00 TO STA 435+00
15	C30	PLAN AND PROFILE-STA 435+00 TO STA 450+00
16	C31	PLAN AND PROFILE-STA 450+00 TO STA 465+00
17	C32	PLAN AND PROFILE-STA 465+00 TO STA END OF LINE
18	C34	PROFILES
19	C40	RAILROAD CROSSING DETAILS
20	C41	MANHOLE DETAILS
21	C42	MANHOLE DETAILS
22	C43	MANHOLE SCHEDULE
23	C44	MISCELLANEOUS DETAILS

RECORD DRAWING

THIS DRAWING HAS BEEN MODIFIED TO REFLECT
CHANGES MADE DURING CONSTRUCTION BASED
UPON INFORMATION AS MAY BE PROVIDED BY THE
CONTRACTOR AND CONSTRUCTION OBSERVATION
BY THE ENGINEER'S AUTHORIZED REPRESENTATIVE
BY 7/5/01 DATE
ENGINEER

CONSULTING ENGINEERS



B & V PROJECT NUMBER 26444

COMMISSION NUMBER: N/A

THIS DOCUMENT
ORIGINALLY ISSUED
AND SEALED BY
BRENT M. REUSS
PROFESSIONAL ENGINEER,
COMMONWEALTH OF VIRGINIA
REGISTRATION NO. 026945
ON
12/28/97

PROJECT NAME

ROANOKE RIVER INTERCEPTOR
ROANOKE, VIRGINIA
CONTRACTS C, D, AND E

PROJECT NUMBER: 6312

REVISION BY	DESCRIPTION:	DATE
REVISION BY	DESCRIPTION:	DATE
REVISION BY	DESCRIPTION:	DATE
REVISION BY	DESCRIPTION:	DATE

APPROVED FOR CONSTRUCTION

ORIGINAL DOCUMENT SIGNED BY CHARLES M. HUFFINE ROANOKE CITY ENGINEER	12-17-97 DATE
ORIGINAL DOCUMENT SIGNED BY WILLIAM F. CLARK DIRECTOR OF PUBLIC WORKS	12-17-97 DATE
ORIGINAL DOCUMENT SIGNED BY KIT B. KISER DIRECTOR OF UTILITIES AND OPERATIONS	12-17-97 DATE
	DATE
	DATE

ADVERTISED DATE: JANUARY 4, 1998

SET NUMBER: N/A

SHEET NUMBER: 1 OF 23