


12/12/2000 14:51:50 RCD


A

B

C

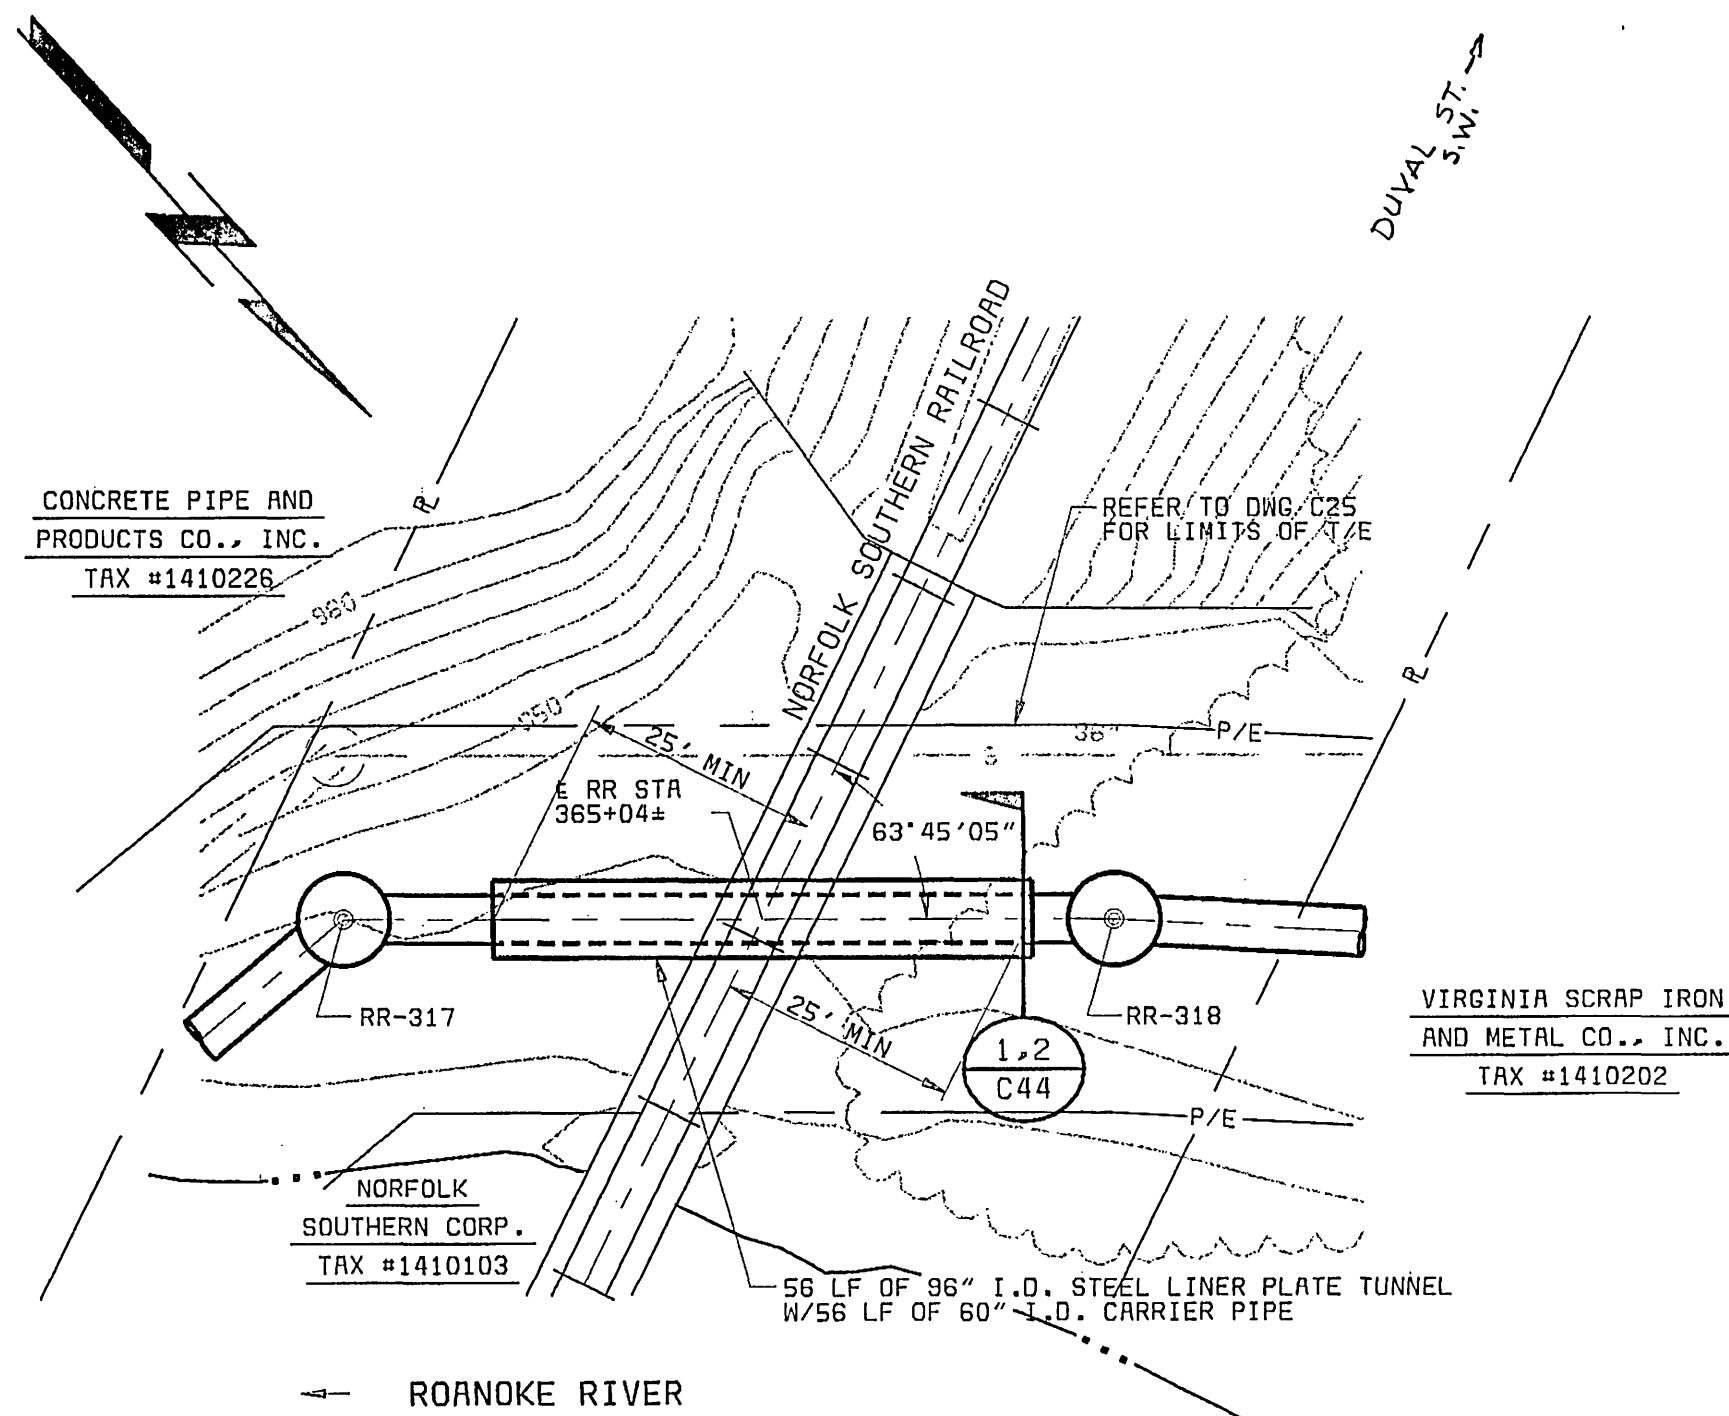

RRX-1 PLAN (C25)

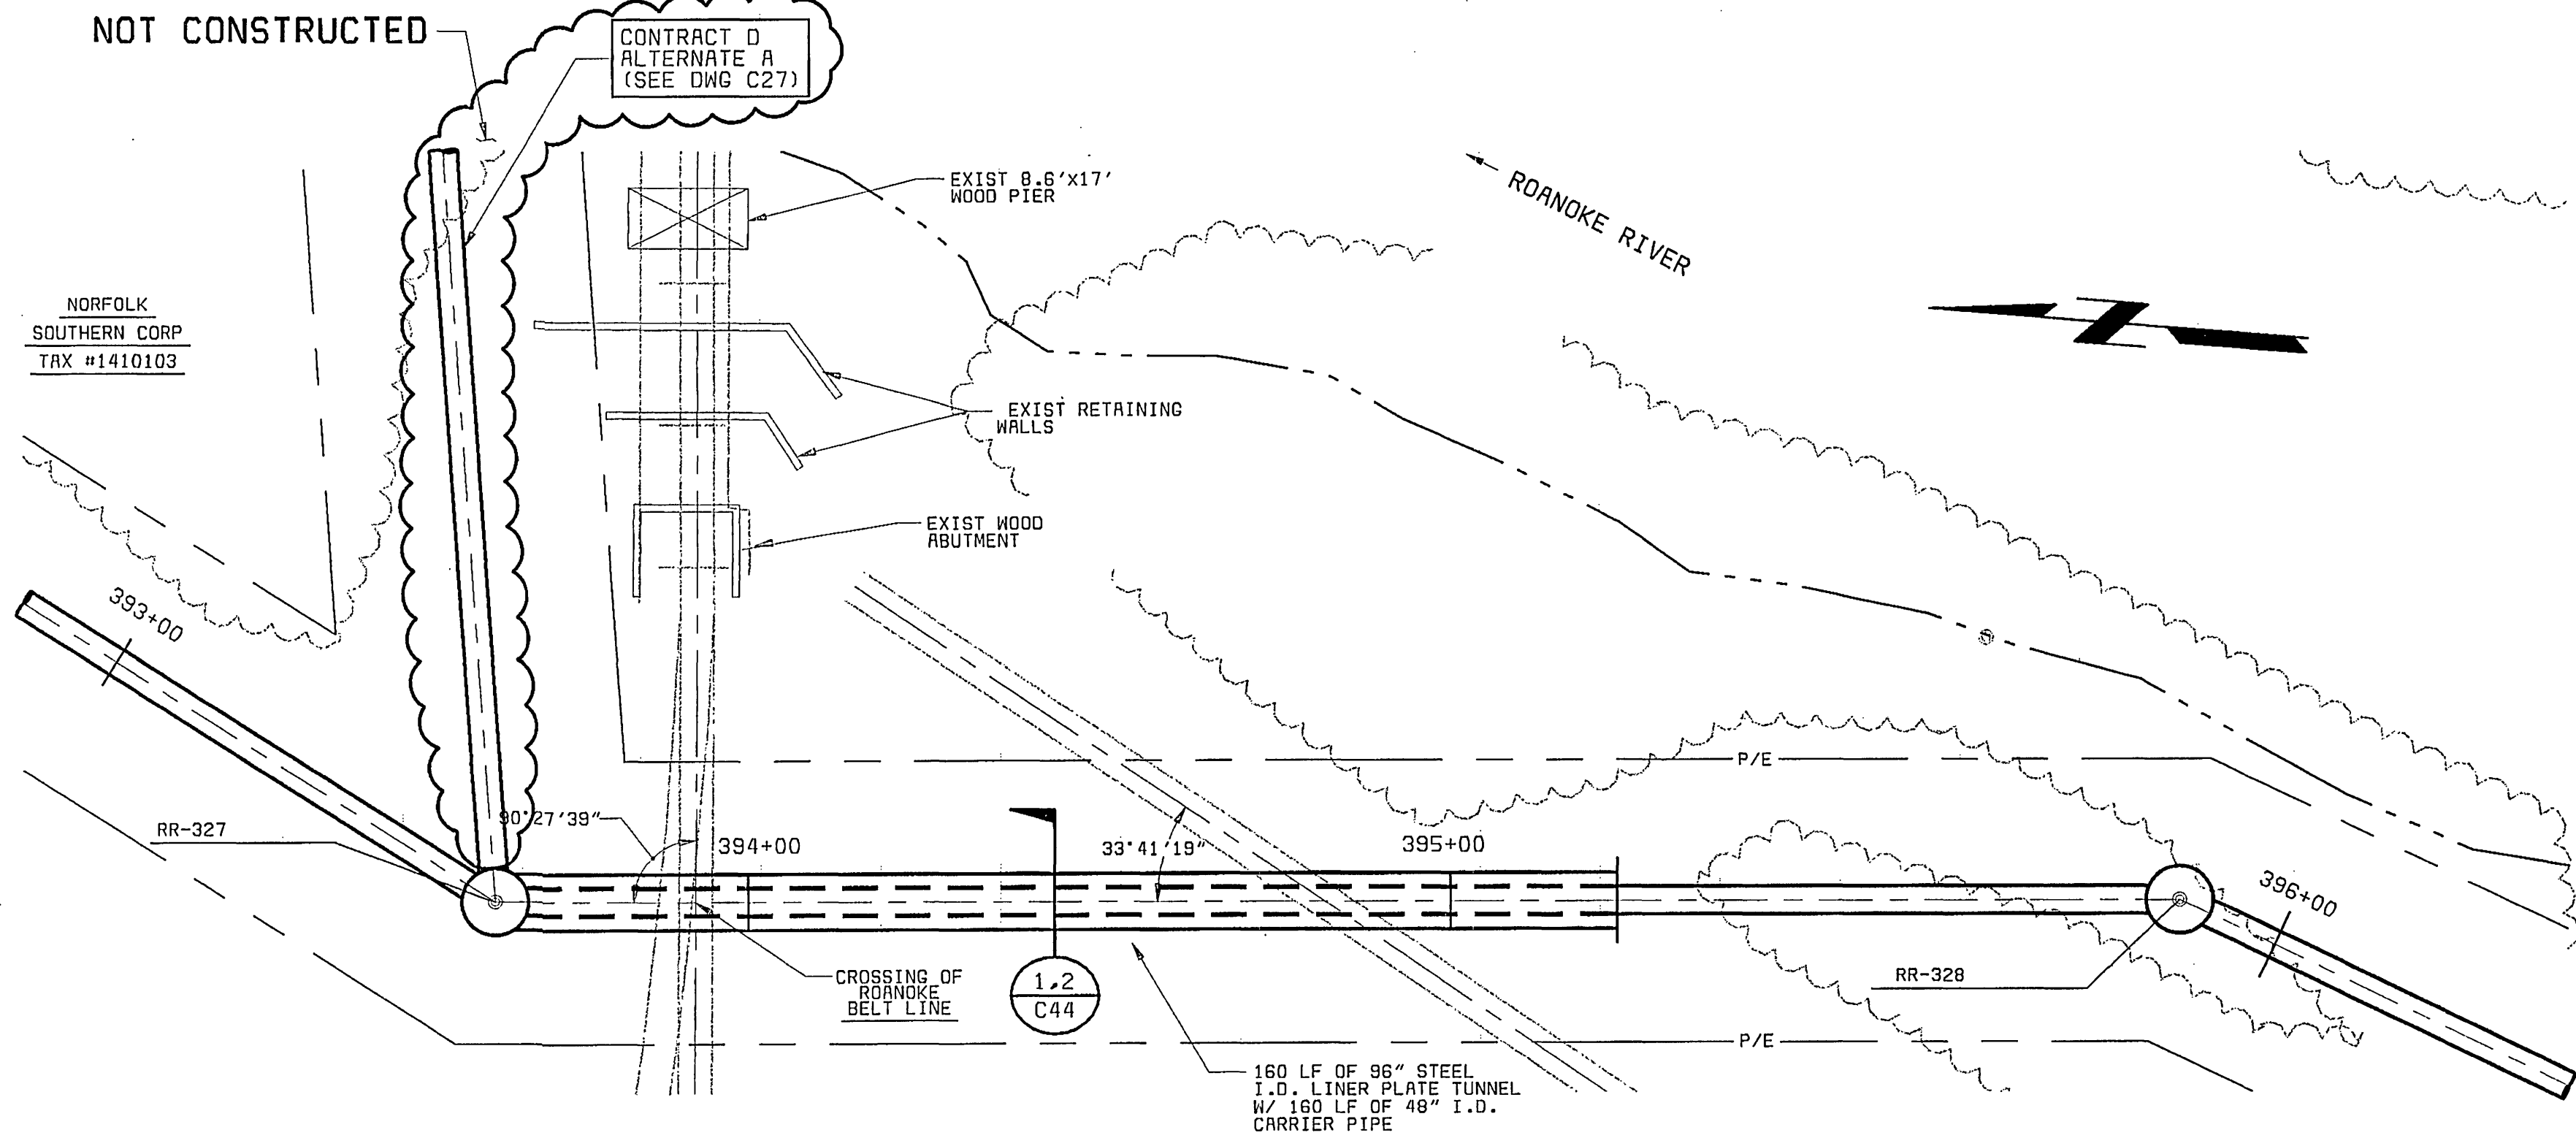

RRX-2 PLAN (C27)

RECORD DRAWING

THIS DRAWING HAS BEEN MODIFIED TO REFLECT CHANGES MADE DURING CONSTRUCTION BASED UPON INFORMATION AS MAY BE PROVIDED BY THE CONTRACTOR AND CONSTRUCTION OBSERVATION BY THE ENGINEER'S AUTHORIZED REPRESENTATIVE


BY: *[Signature]* 3/5/99
ENGINEER DATE

NOTES:
1. STEEL LINER PLATE TUNNEL DIAMETER INDICATED IS MINIMUM REQUIRED.


D

E

F

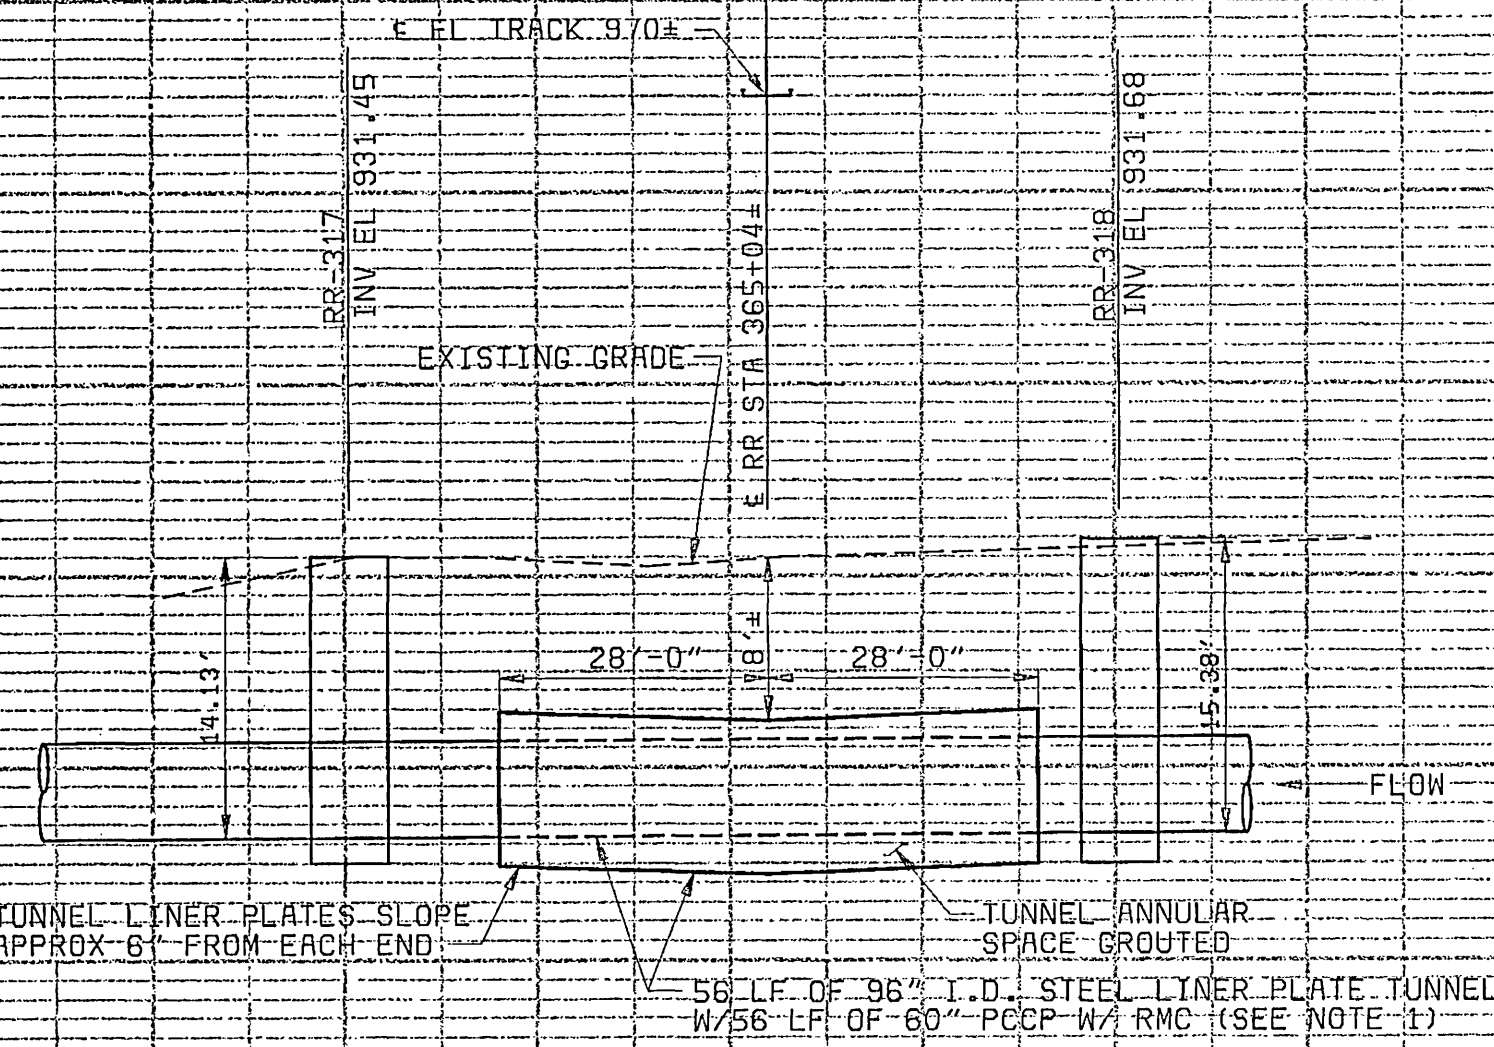

CONTRACT D

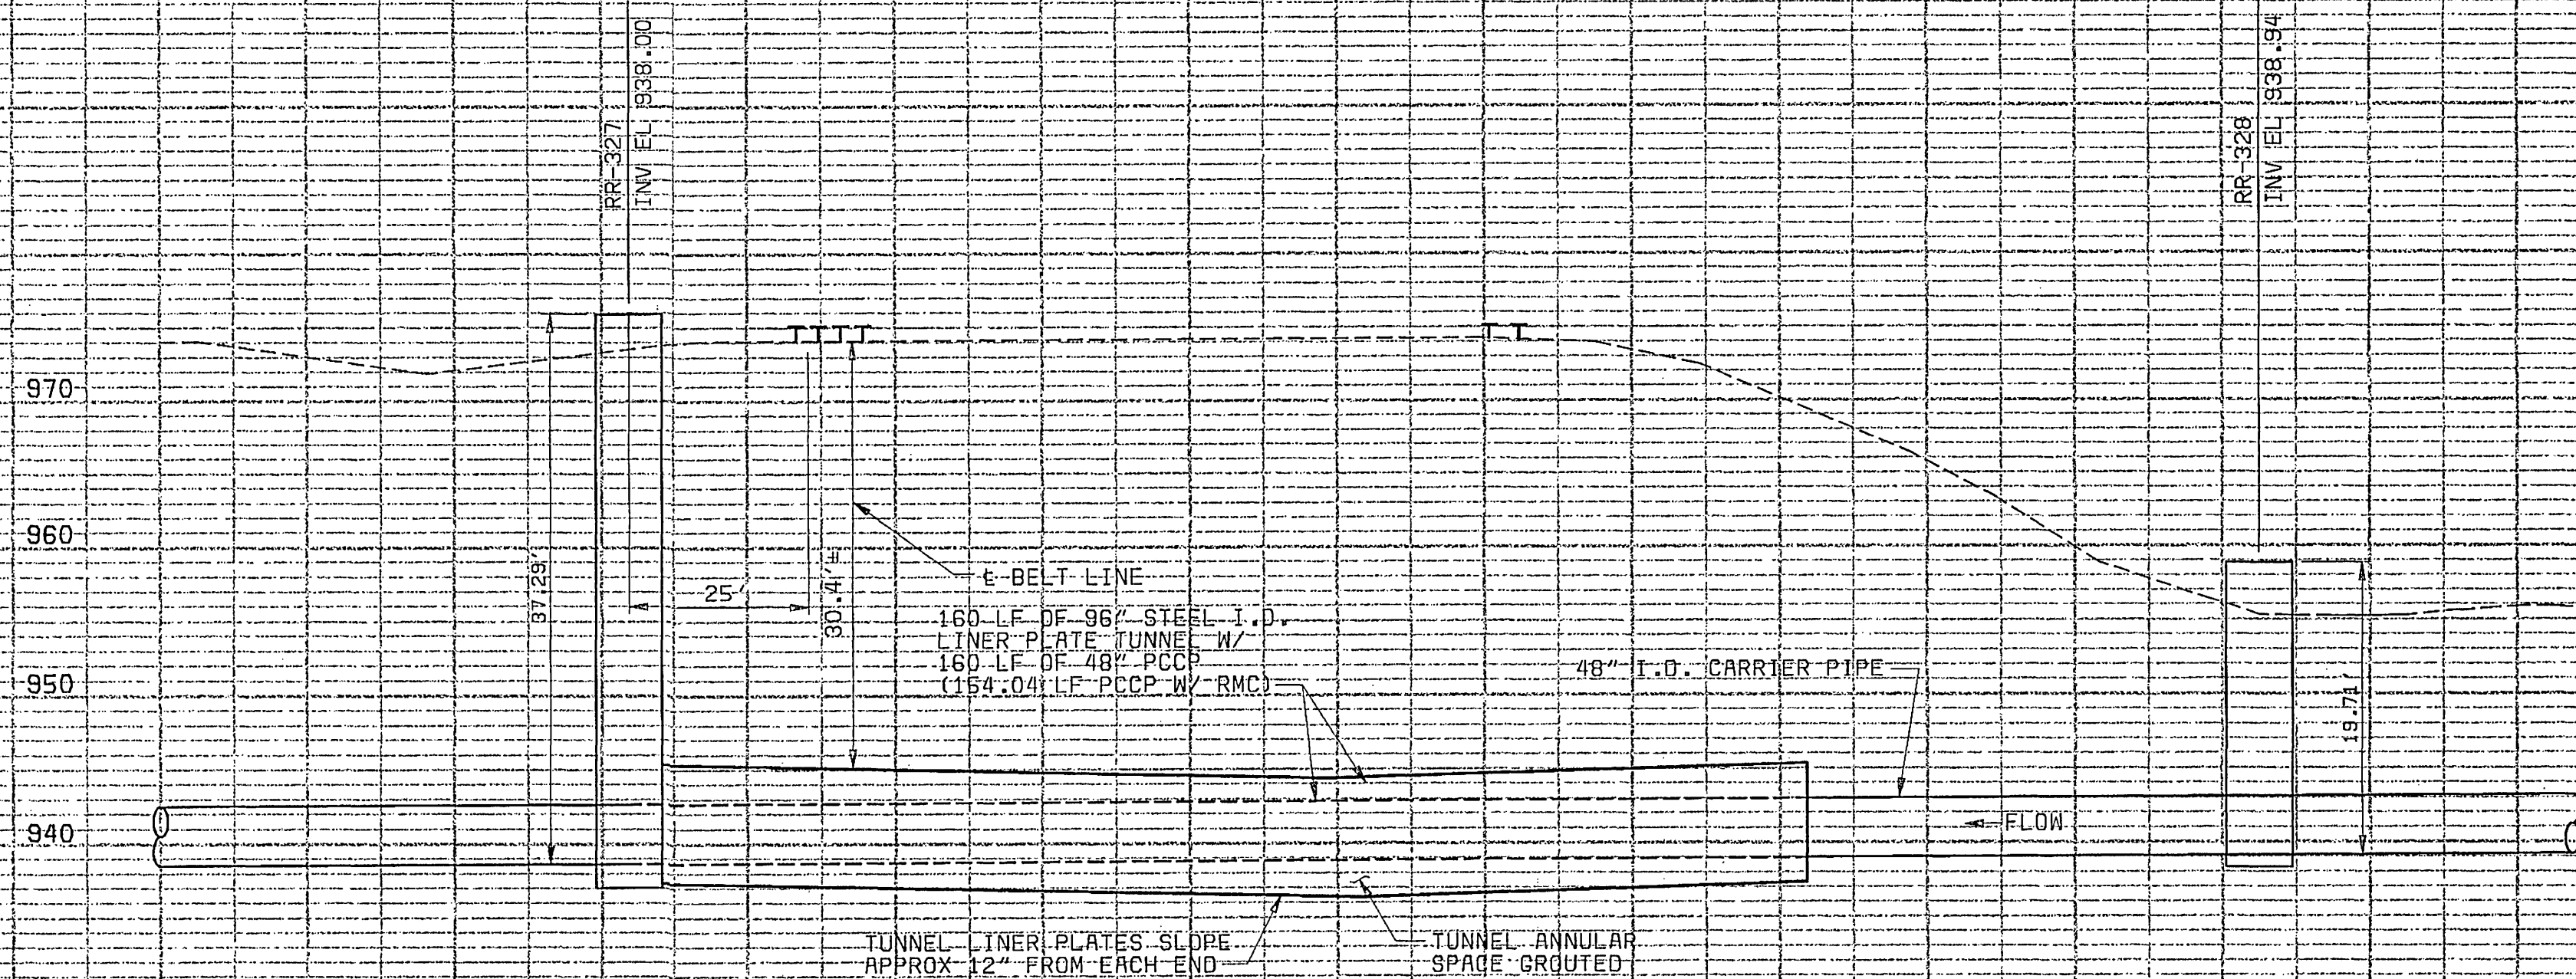

CONTRACT D

SCALE: 1" = 20' HORIZ
1" = 10' VERT

CITY OF ROANOKE, VIRGINIA
ROANOKE RIVER INTERCEPTOR

RAILROAD CROSSING DETAILS

PROJECT NO.
26444



DESIGNED SLF/JBB
DETAILED ABW/CGL
CHECKED RAF
APPROVED
DATE

DATE REVISIONS AND RECORD OF ISSUE NO. BY CK APP

THIS DOCUMENT
ORIGINALLY ISSUED
AND SEALED BY
BRENT M. REUSS
PROFESSIONAL ENGINEER,
COMMONWEALTH OF VIRGINIA
REGISTRATION NO. 026345
ON
12/29/97

C40
SHEET
19 OF 23