


ACCELERATION LANE AT ROCKYDALE QUARRIES

*SITUATED AT
ROUTE 220 & QUARRY ENTRANCE
THE CITY OF ROANOKE, VIRGINIA*

DATE: September 19, 2008

PREPARED FOR

ROCKYDALE QUARRIES CORP.

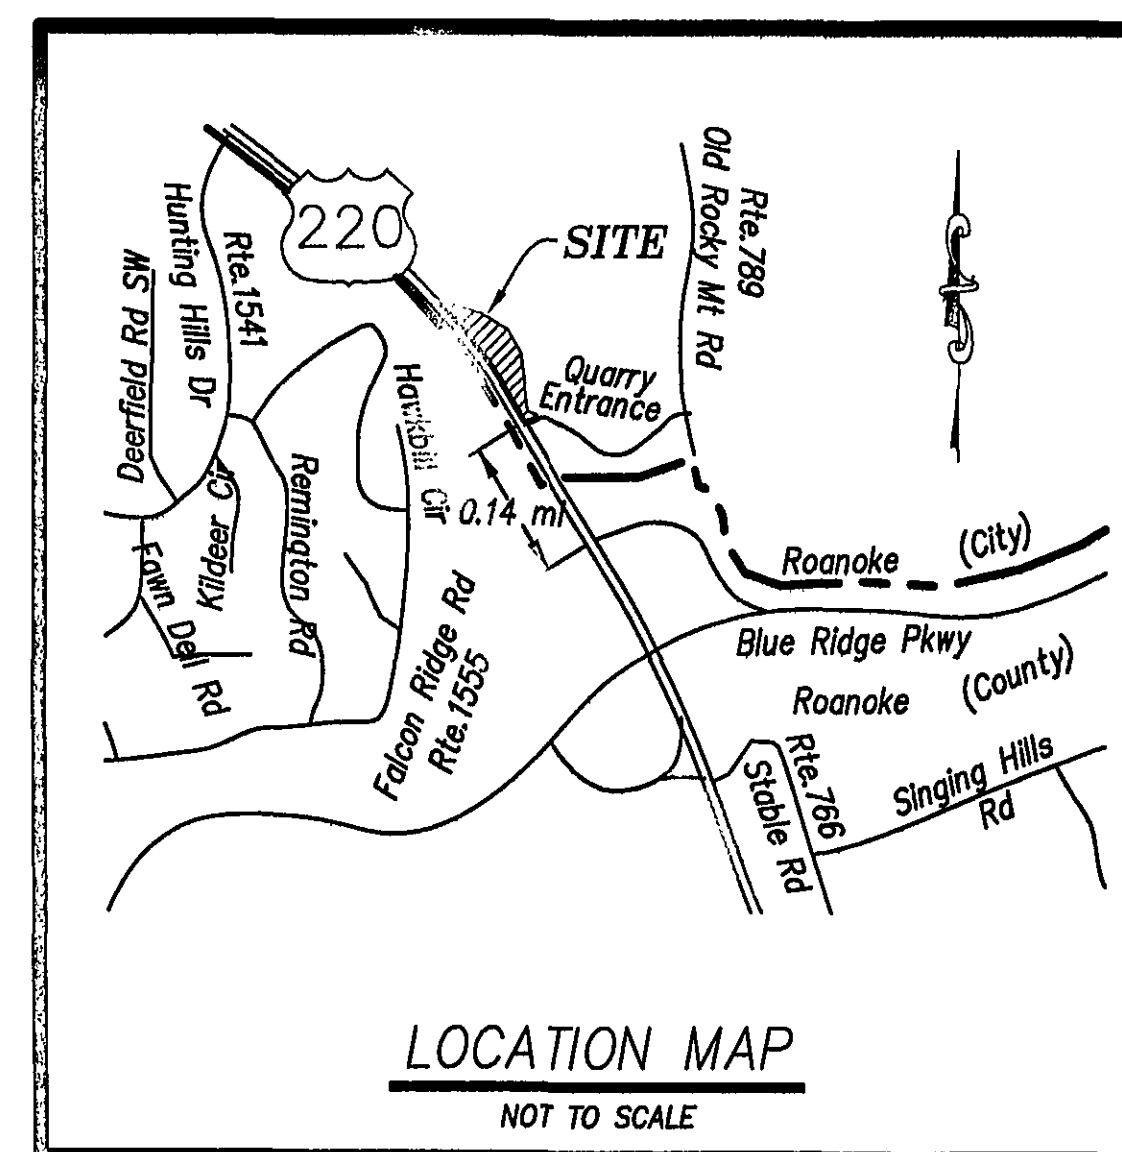

--INDEX OF DRAWINGS--

SHEET No.	DESCRIPTION
1	LUMSDEN ASSOCIATES COVER SHEET
2	NOTES & DETAILS
3	PLAN AND PROFILE
4	CROSS SECTIONS
5	EROSION AND SEDIMENT CONTROL PLAN
6	EROSION AND SEDIMENT CONTROL DETAILS

I AM CERTIFIED BY THE STATE OF VIRGINIA AS A "RESPONSIBLE LAND DISTURBER". I SHALL BE RESPONSIBLE FOR THE IMPLEMENTATION OF THE EROSION AND SEDIMENT CONTROL PLAN AS SHOWN.

SIGNATURE:

PRINTED NAME:

CERTIFICATE No.:

EXPIRATION DATE:

TELEPHONE No.:

ADDRESS:




LUMSDEN ASSOCIATES, P.C.
ENGINEERS-SURVEYORS-PLANNERS

4664 BRAMBLETON AVENUE, SW
P.O. BOX 20669
ROANOKE, VIRGINIA 24018

PHONE: (540) 774-4411
FAX: (540) 772-9445
E-MAIL: MAIL@LUMSDENPC.COM

Water As-Built
11/24/2009

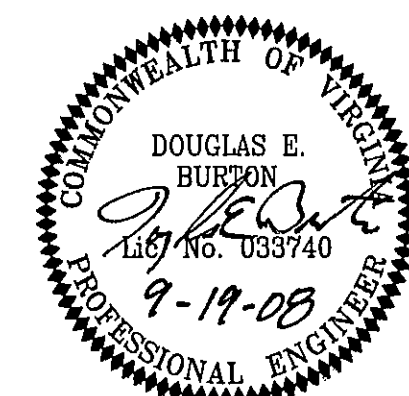

REVISIONS	
DATE	SHEETS

COMMISSION NO. 06-031

SHEET 1 OF 6