


DEVELOPMENT PLAN
FOR
ROSELAWN SANITARY
SEWER EXTENSION

*SITUATED IN
WINDSOR HILLS MAGISTERIAL DISTRICT
ROANOKE COUNTY, VIRGINIA*

DATE: 7 JULY 2003
 "AS-BUILT": 24 AUGUST 2004
 PREPARED FOR

THE COUNTY OF ROANOKE VIRGINIA

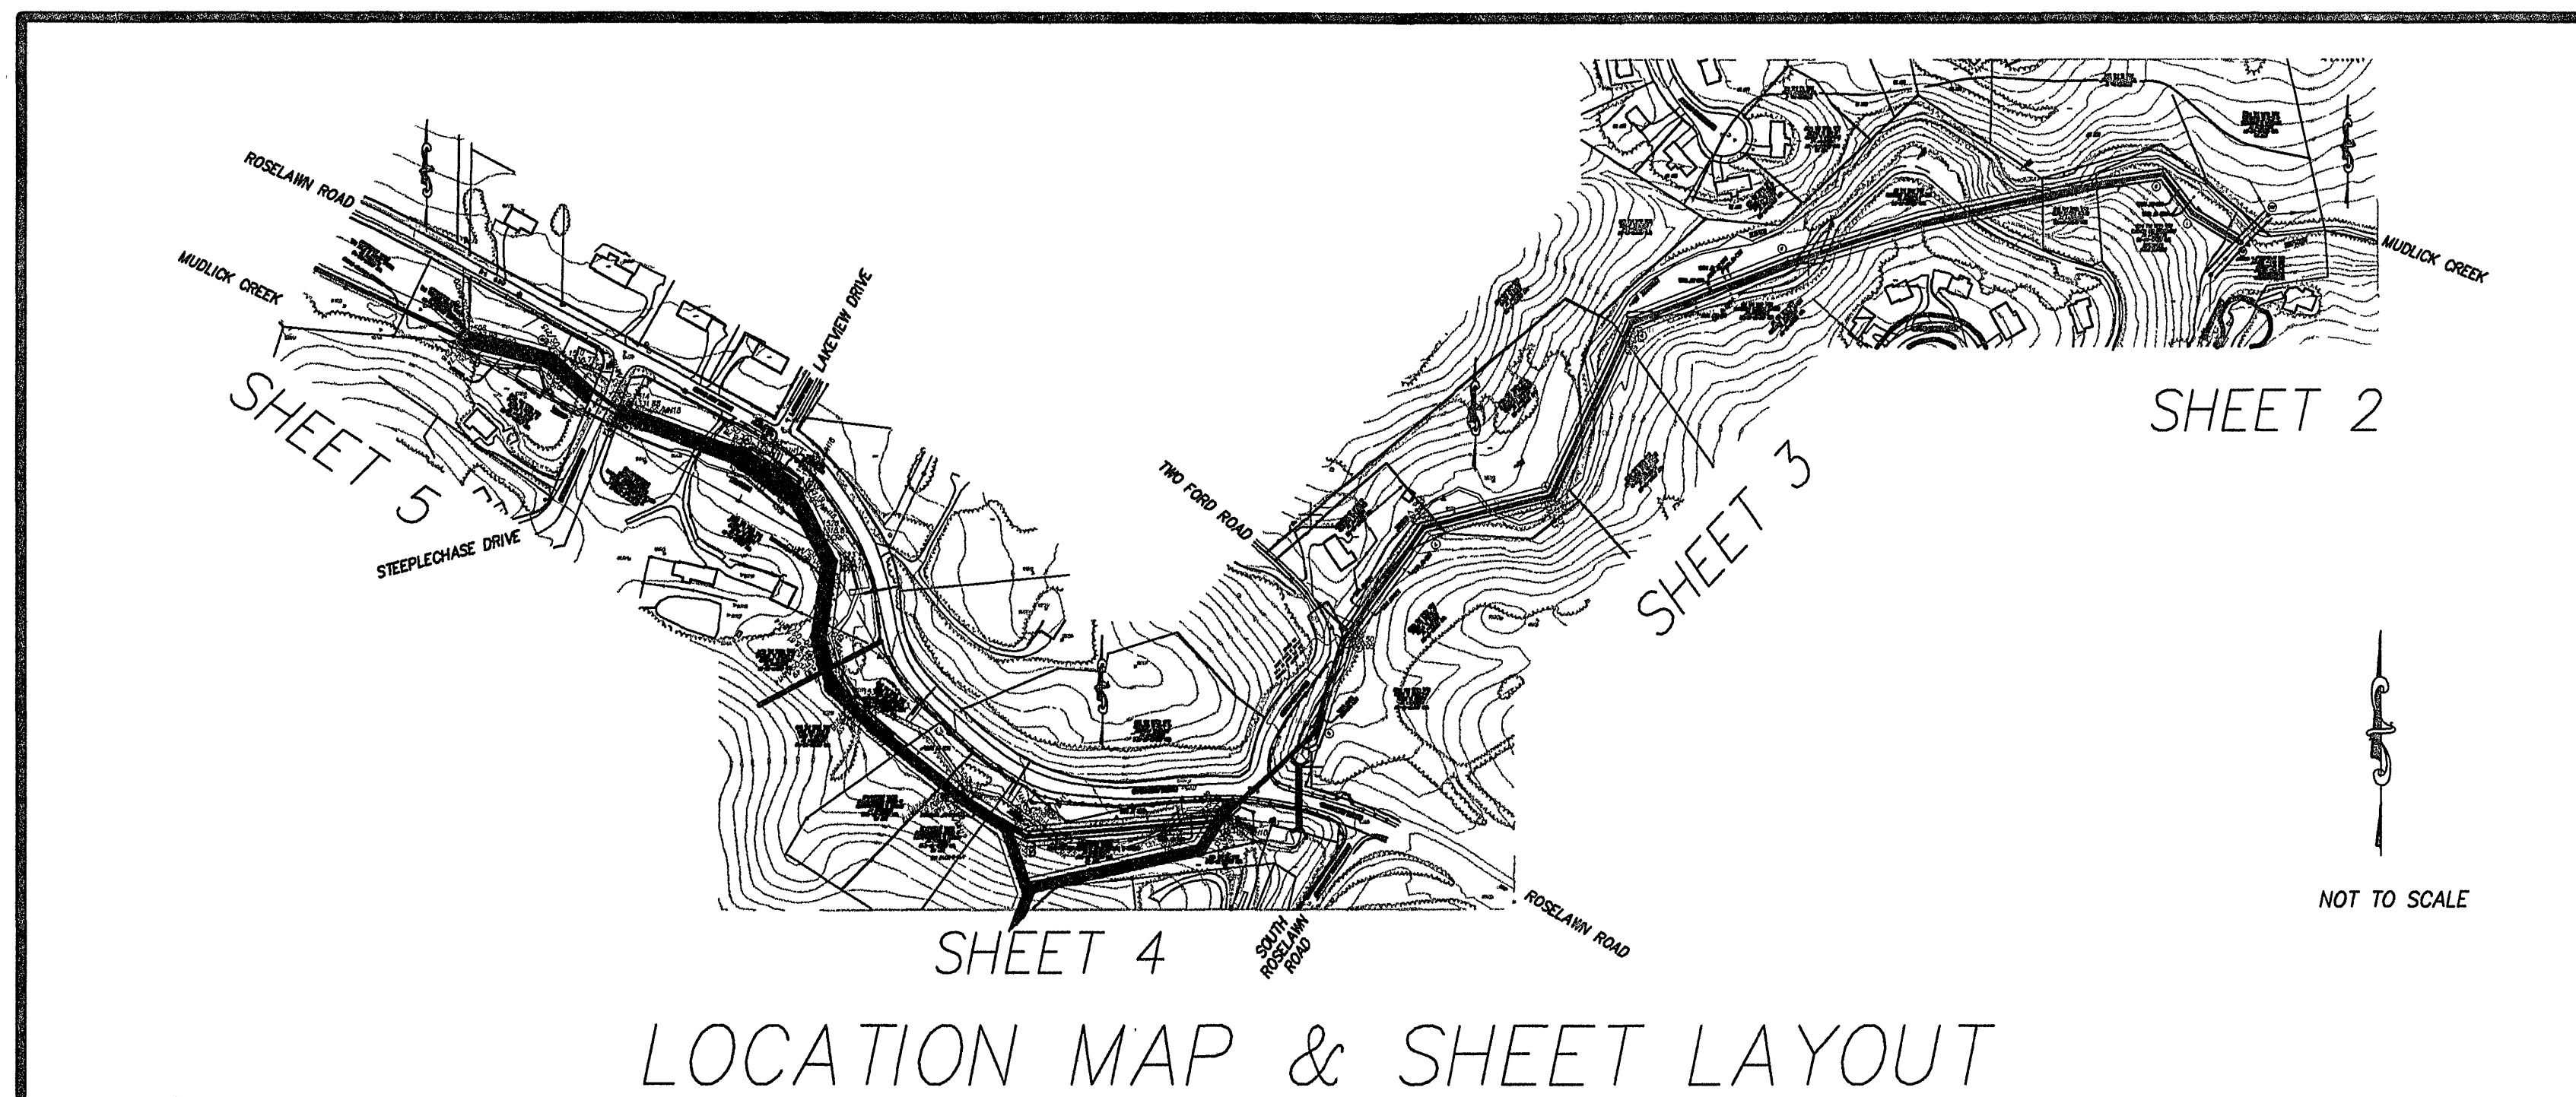

--INDEX OF DRAWINGS--


<i>SHEET No.</i>	<i>DESCRIPTION</i>
------------------	--------------------

1. LUMSDEN ASSOCIATES COVER SHEET
2. SANITARY SEWER PLAN & PROFILE
3. SANITARY SEWER PLAN & PROFILE
4. SANITARY SEWER PLAN & PROFILE
5. SANITARY SEWER PLAN & PROFILE

“AS-BUILT”

NOTE:

1. "AS-BUILT" INFORMATION TAKEN FROM PLAN FURNISHED BY WESTERN VIRGINIA WATER AUTHORITY.
2. "AS-BUILT" DIMENSIONS SHOWN IN BRACKETS.

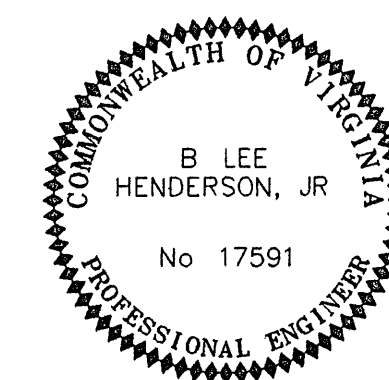

REVISIONS	
DATE	SHEETS
11/20/03	2 OF 5 MH'S 1 & 2
COMMISSION NO:	
02-390	
SHEET 1 OF 5	

WWWA ID# 6SJQGS



LUMSDEN ASSOCIATES, P.C.
ENGINEERS-SURVEYORS-PLANNERS

4664 BRAMBLETON AVENUE, SW
P.O. BOX 20669
ROANOKE, VIRGINIA 24018

PHONE: (540) 774-4411
FAX: (540) 772-9445
E-MAIL: MAIL@LUMSDENPC.COM