


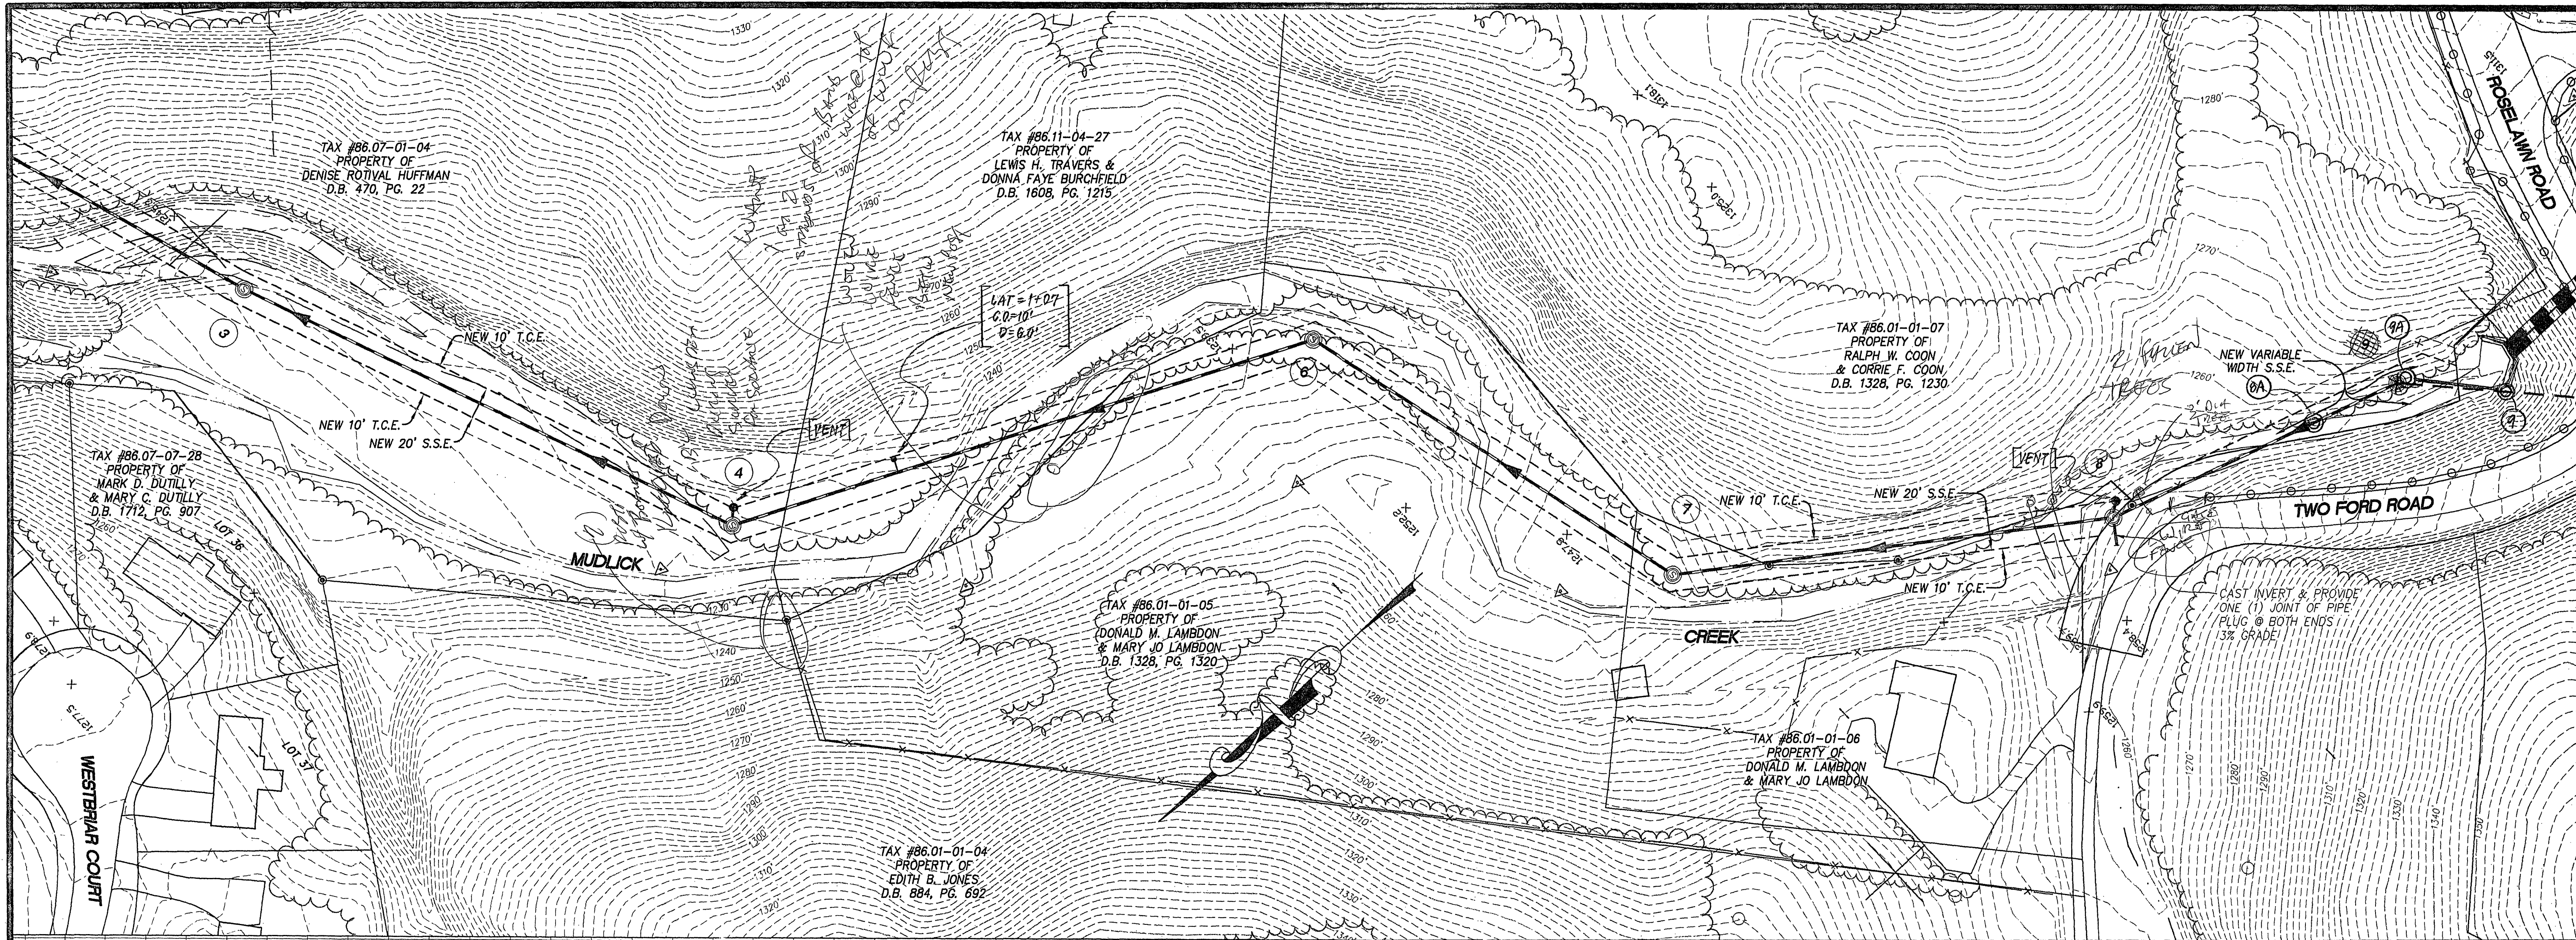

L

A

LUMSDEN ASSOCIATES, P.C.
ENGINEERS-SURVEYORS-PLANNERS
ROANOKE, VIRGINIA


COMMONWEALTH OF VIRGINIA
B LEE
HENDERSON, JR.
No 17591
PROFESSIONAL ENGINEER

SEWER
PLAN & PROFILE

ROSELAWN SANITARY
SEWER EXTENSION
PREPARED FOR
THE COUNTY OF ROANOKE, VIRGINIA
WINDSOR HILLS MAGISTERIAL DISTRICT
ROANOKE COUNTY, VIRGINIA

NO.	DATE	DESCRIPTION
1	8/24/14	"AS-BUILT" SANITARY SEWER
2		
3		
4		
5		

DATE: JULY 7, 2003
SCALE: H 1"= 50' V 1"= 10'
COMMISSION NO. 2002 390
SHEET 3 OF 5

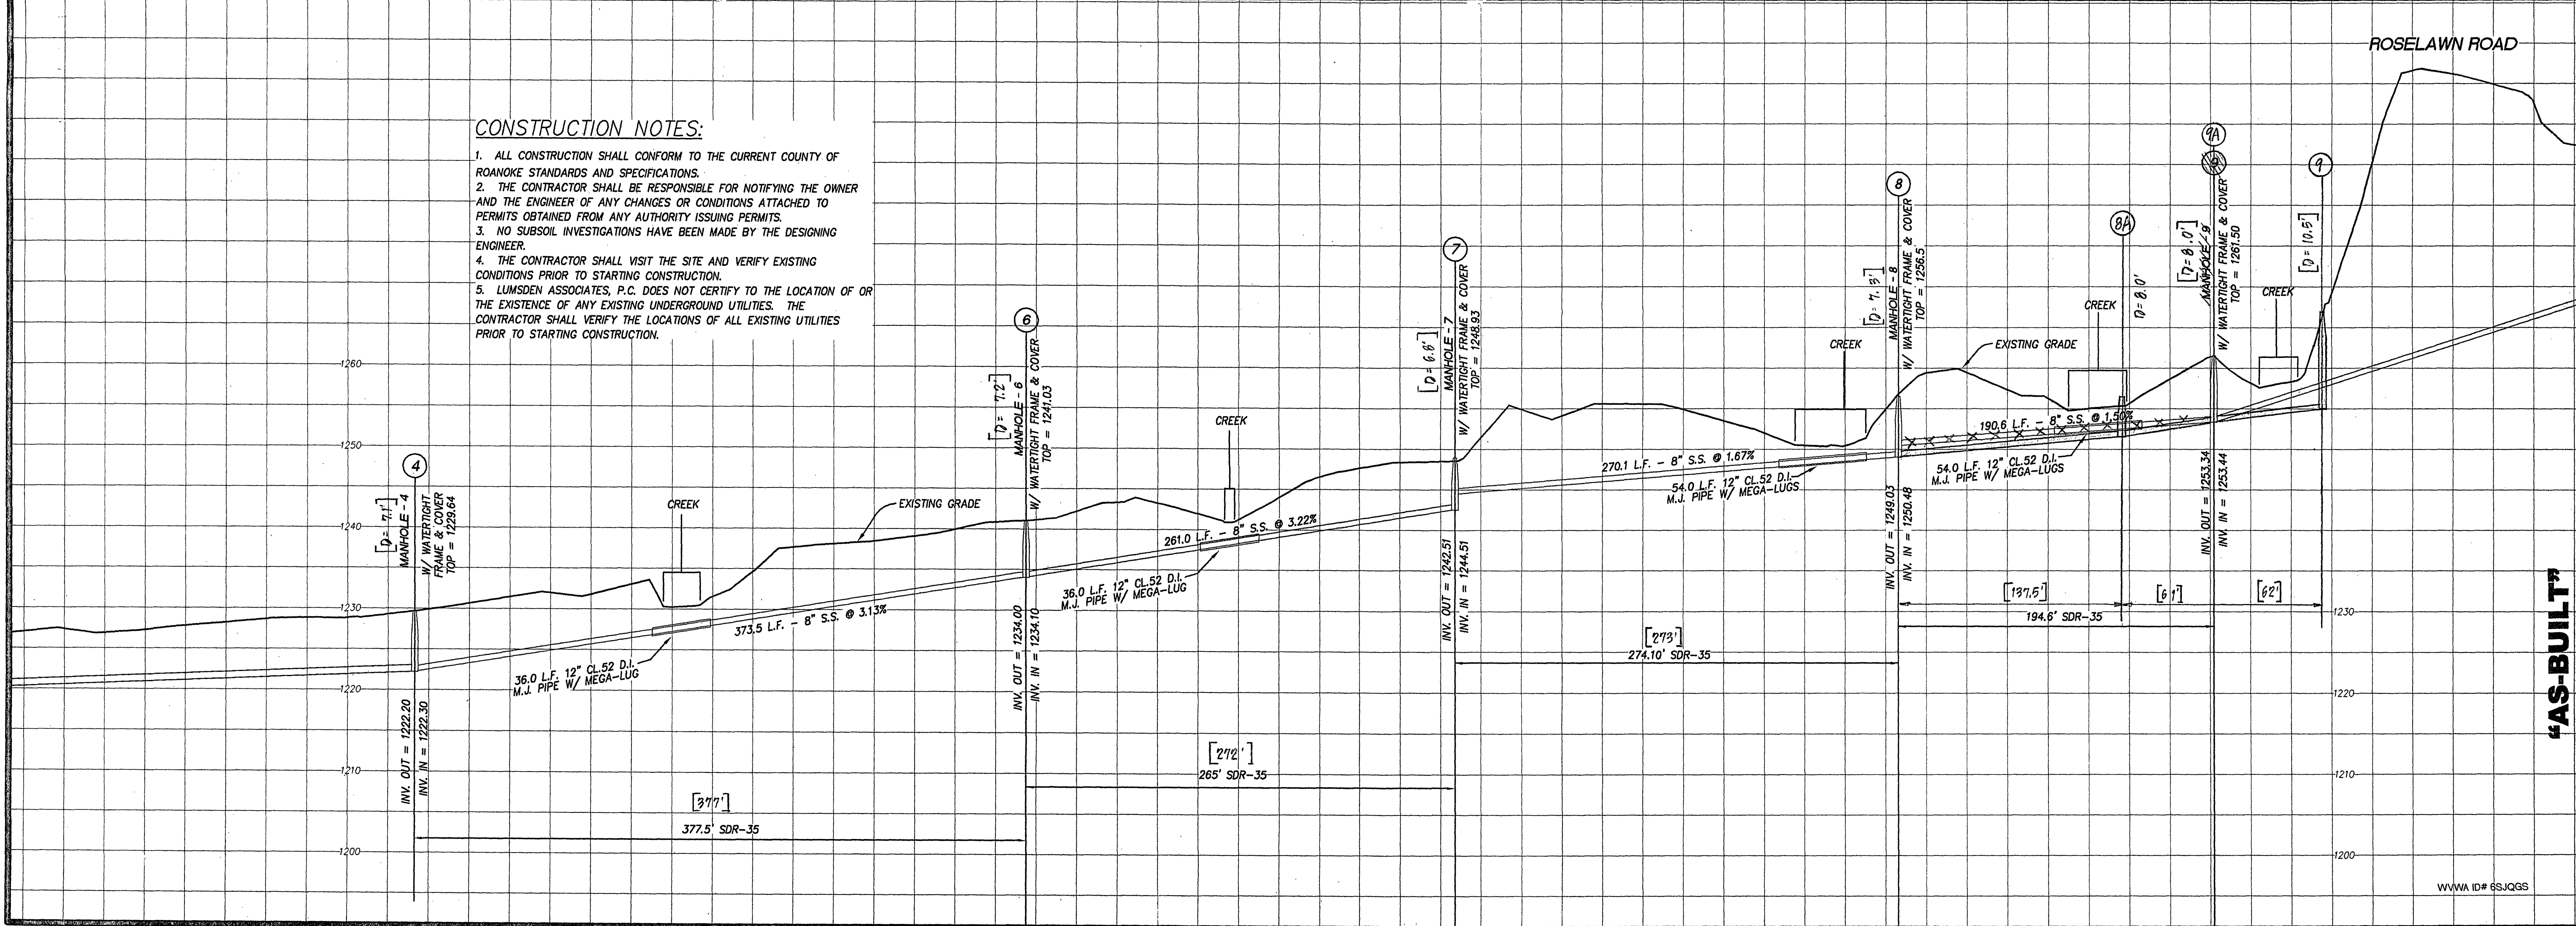

CONSTRUCTION NOTES:

- ALL CONSTRUCTION SHALL CONFORM TO THE CURRENT COUNTY OF ROANOKE STANDARDS AND SPECIFICATIONS.
- THE CONTRACTOR SHALL BE RESPONSIBLE FOR NOTIFYING THE OWNER AND THE ENGINEER OF ANY CHANGES OR CONDITIONS ATTACHED TO PERMITS OBTAINED FROM ANY AUTHORITY ISSUING PERMITS.
- NO SUBSOIL INVESTIGATIONS HAVE BEEN MADE BY THE DESIGNING ENGINEER.
- THE CONTRACTOR SHALL VISIT THE SITE AND VERIFY EXISTING CONDITIONS PRIOR TO STARTING CONSTRUCTION.
- LUMSDEN ASSOCIATES, P.C. DOES NOT CERTIFY TO THE LOCATION OF OR THE EXISTENCE OF ANY EXISTING UNDERGROUND UTILITIES. THE CONTRACTOR SHALL VERIFY THE LOCATIONS OF ALL EXISTING UTILITIES PRIOR TO STARTING CONSTRUCTION.

"AS-BUILT"

WWW ID# 6SJQGS