

DEVELOPMENT PLAN
FOR
SECTION # 4
" ROSES IN THE GARDENS "


SITUATED IN
CAVE SPRING MAGISTERIAL DISTRICT
ROANOKE COUNTY, VIRGINIA

DATE: JUNE 3, 1998

"AS-BUILT" - 15 SEPTEMBER 1998

PREPARED FOR

STRAUSS CONSTRUCTION CORPORATION

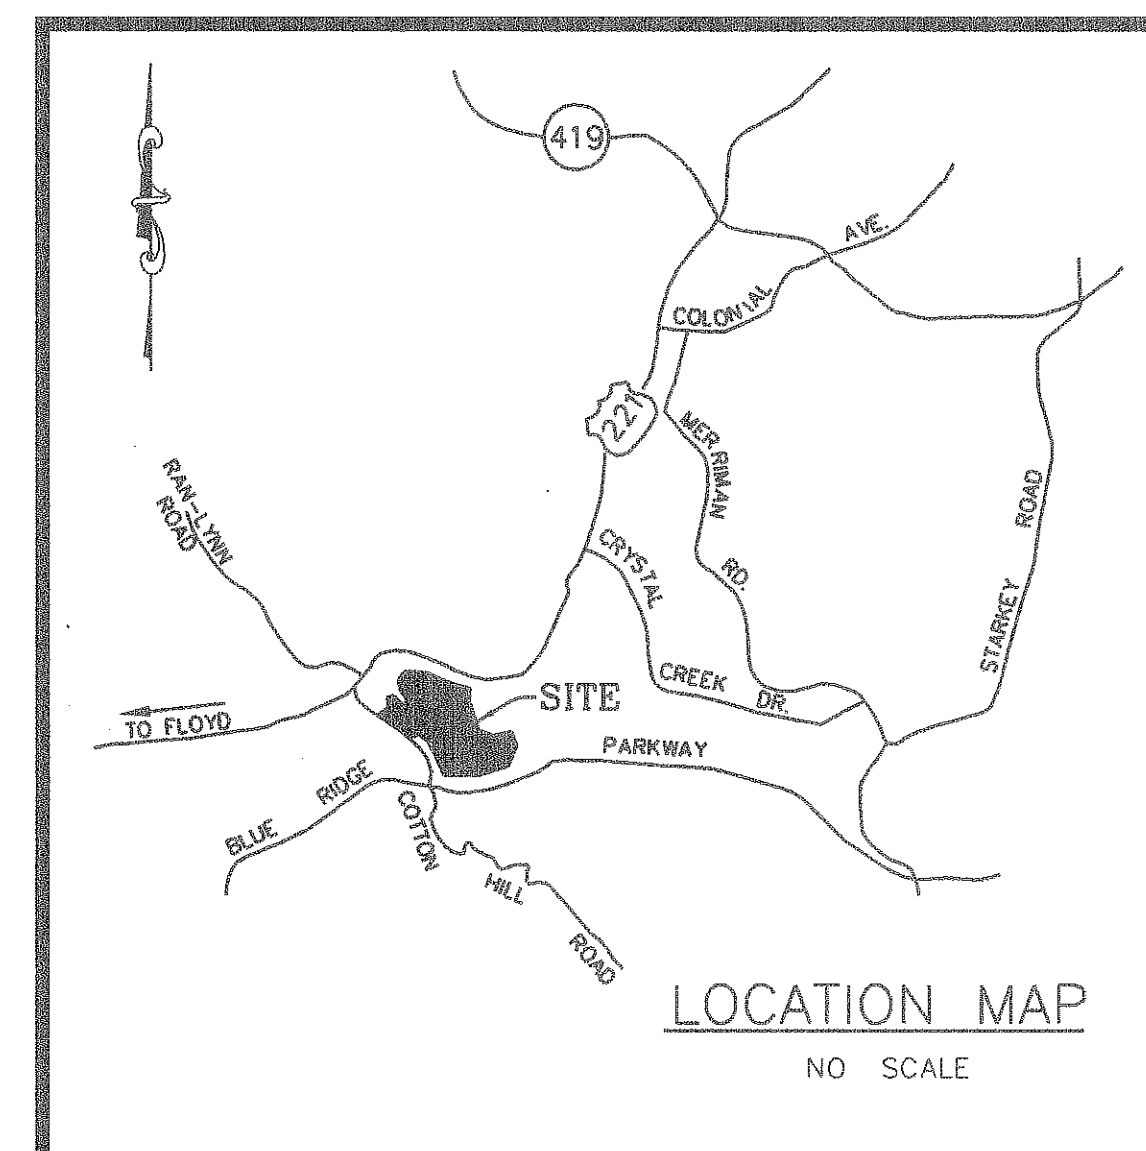

INDEX OF DRAWINGS

SHEET No.	DESCRIPTION
1.	LUMSDEN ASSOCIATES COVER SHEET
2.	ROANOKE COUNTY STD. COVER SHEET
3.	RECORD MAP
4.	NOTES & DETAILS
5.	DIMENSIONAL LAYOUT
6.	GRADING PLAN
7.	PROFILES
8.	EROSION AND SEDIMENT CONTROL PLAN
9.	ROANOKE COUNTY STANDARD EROSION AND SEDIMENT CONTROL DETAIL SHEET

LUMSDEN ASSOCIATES, P.C.
ENGINEERS-SURVEYORS-PLANNERS
ROANOKE, VIRGINIA

REVISIONS			
DATE	SHEETS	DATE	SHEETS
6-11-98	5 & 7		
6-25-98	3		