




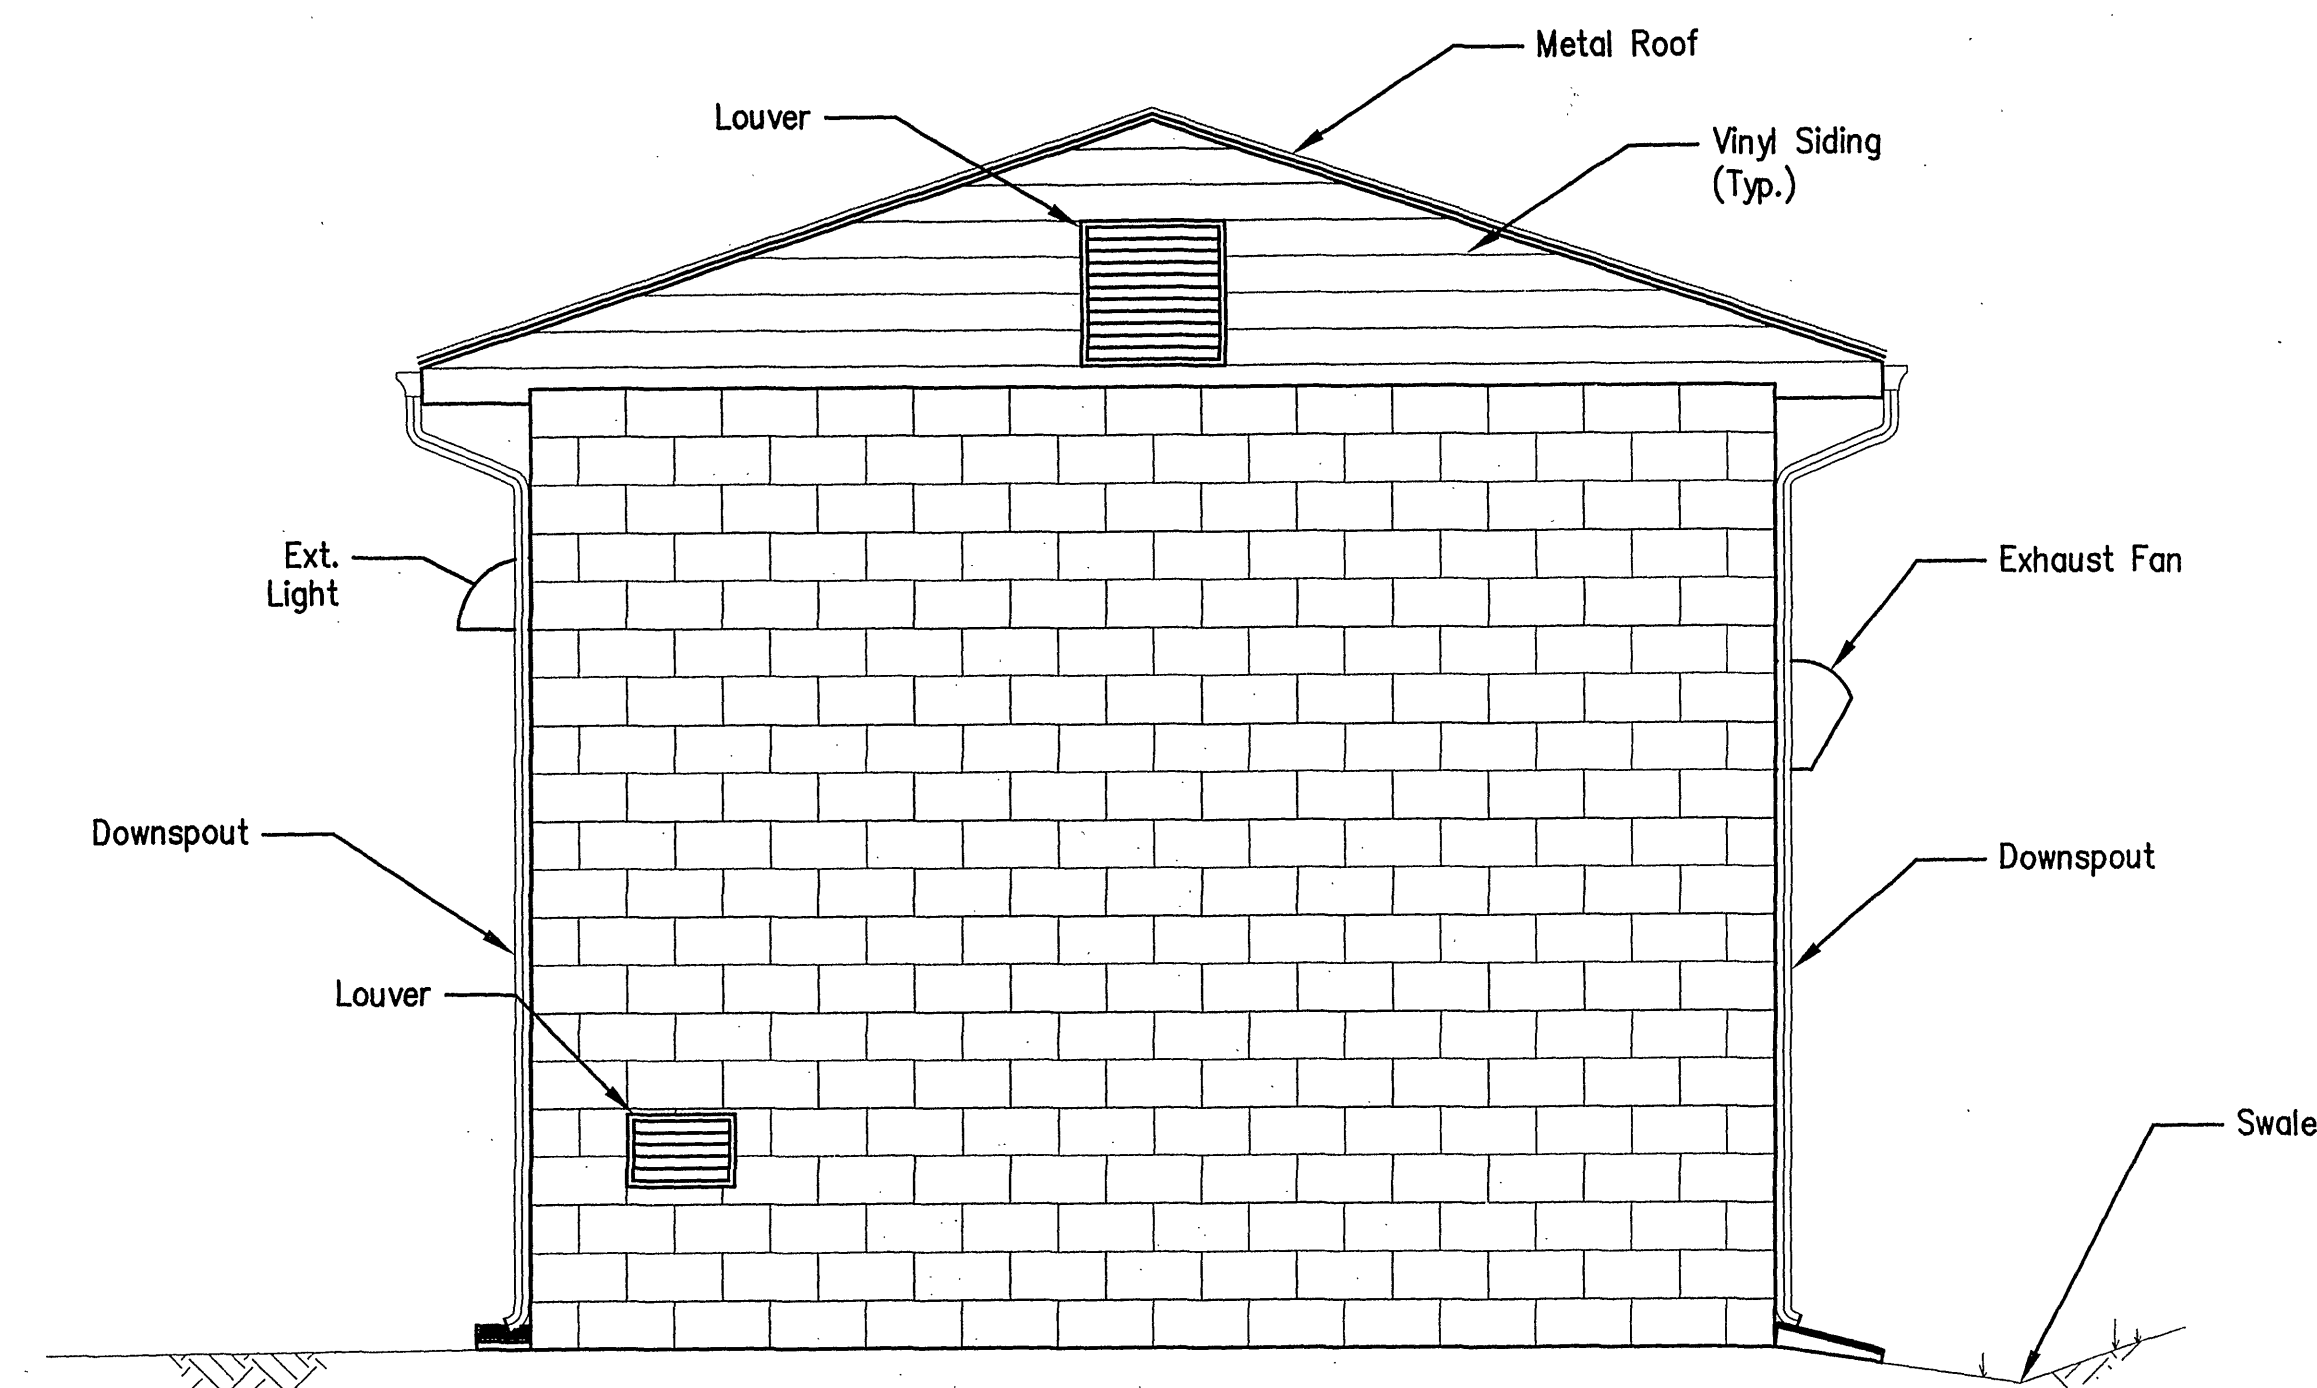


SOUTH VIEW

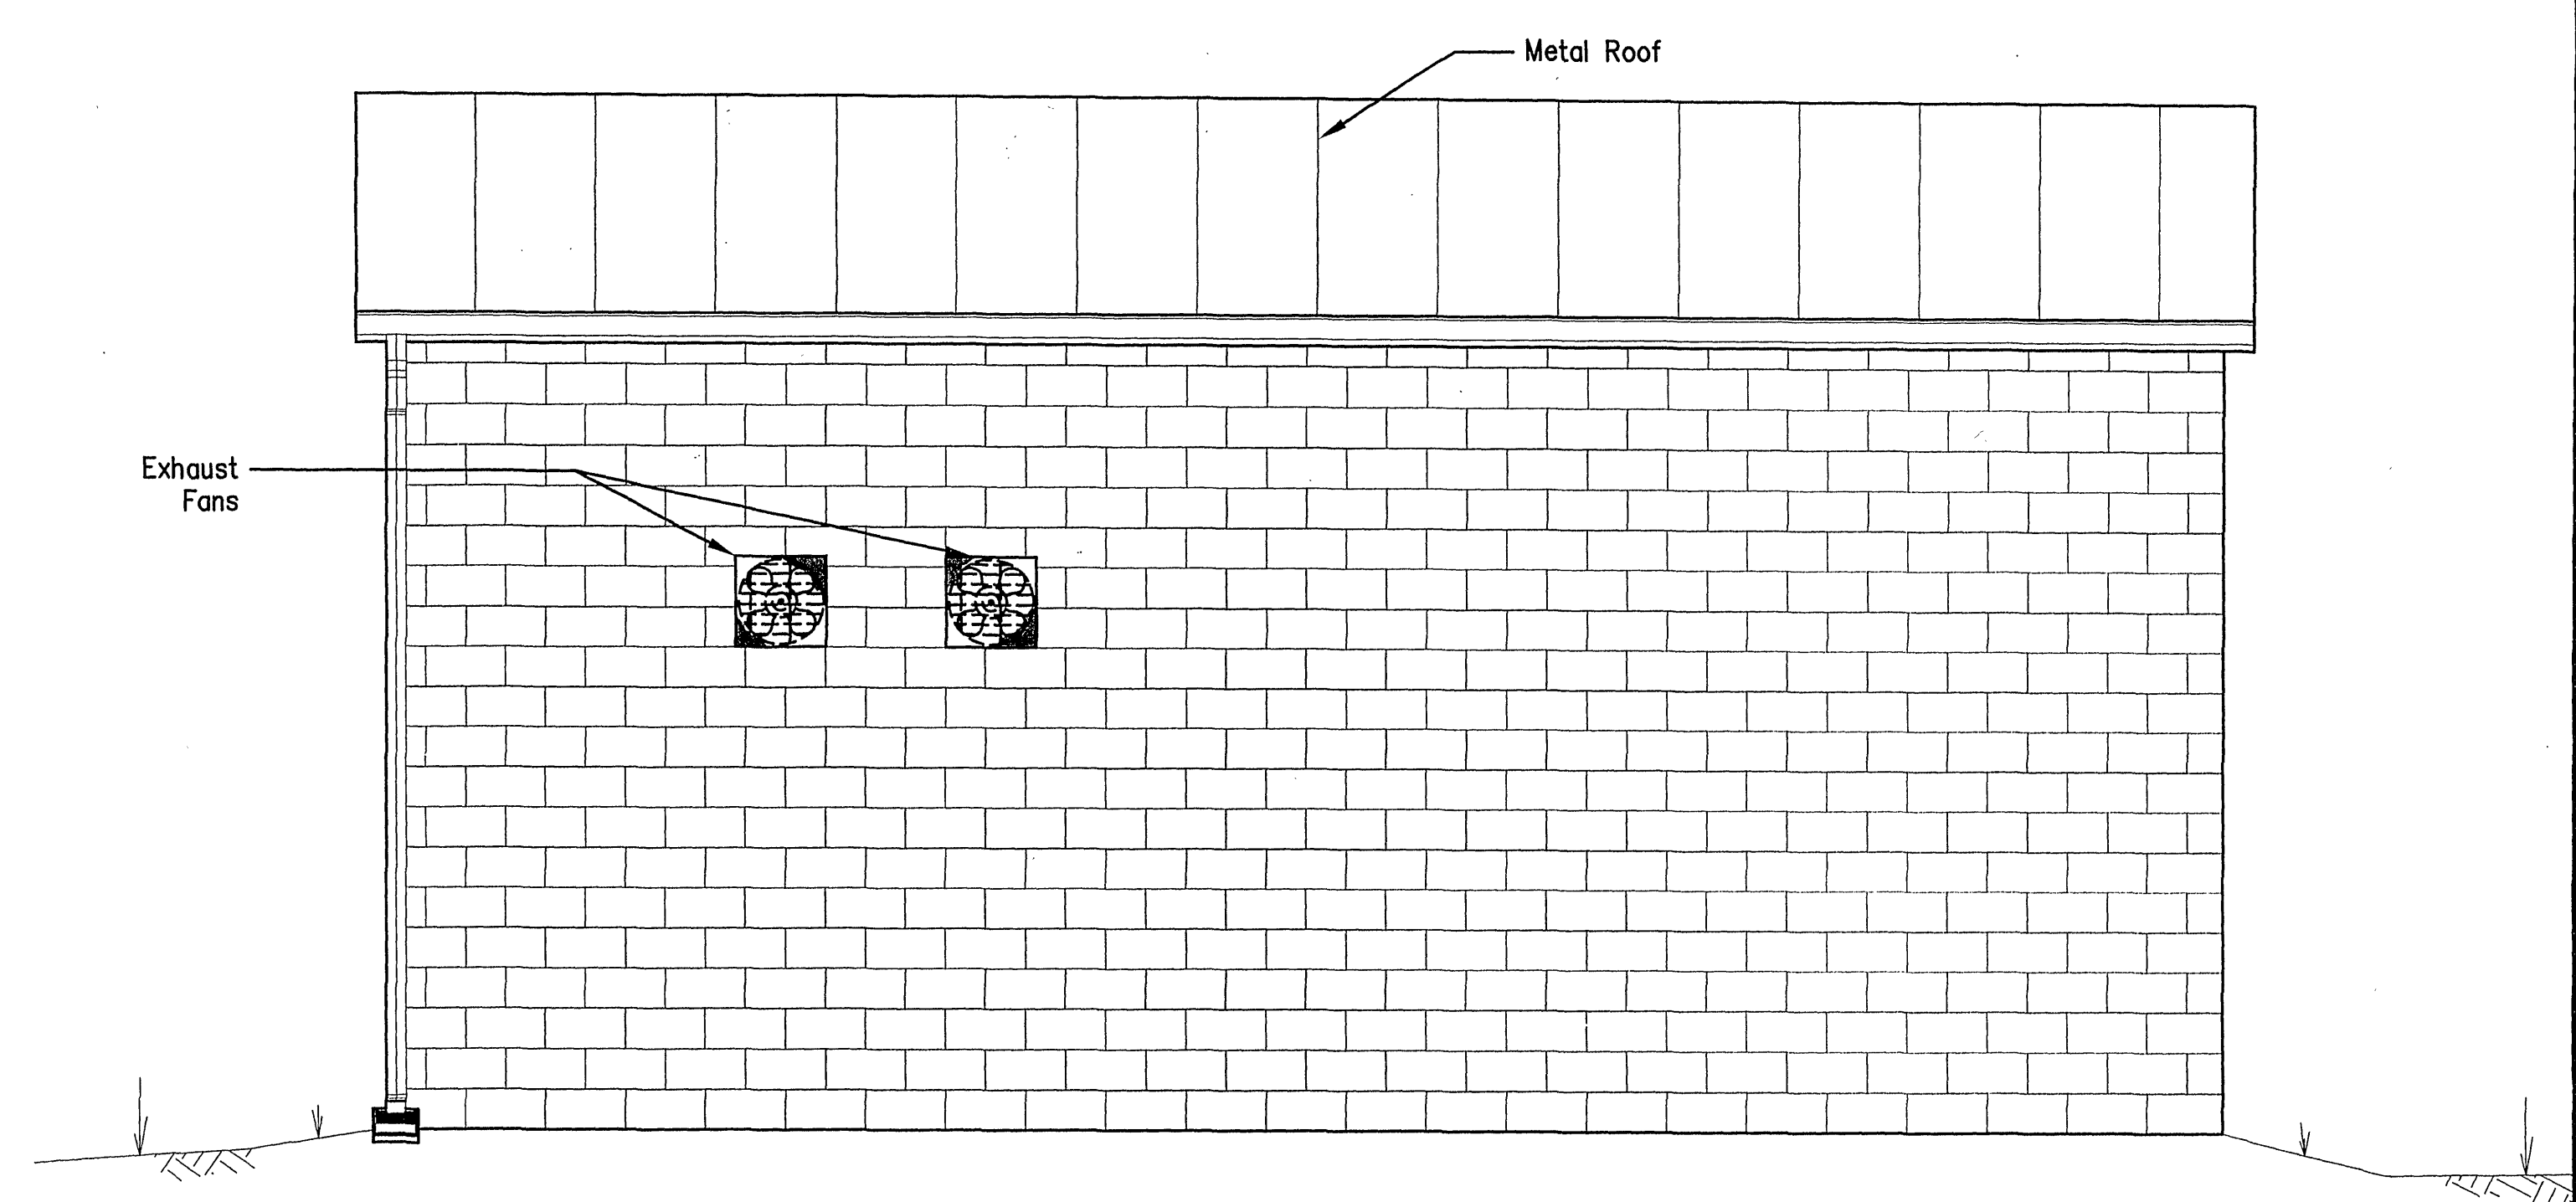

EAST VIEW

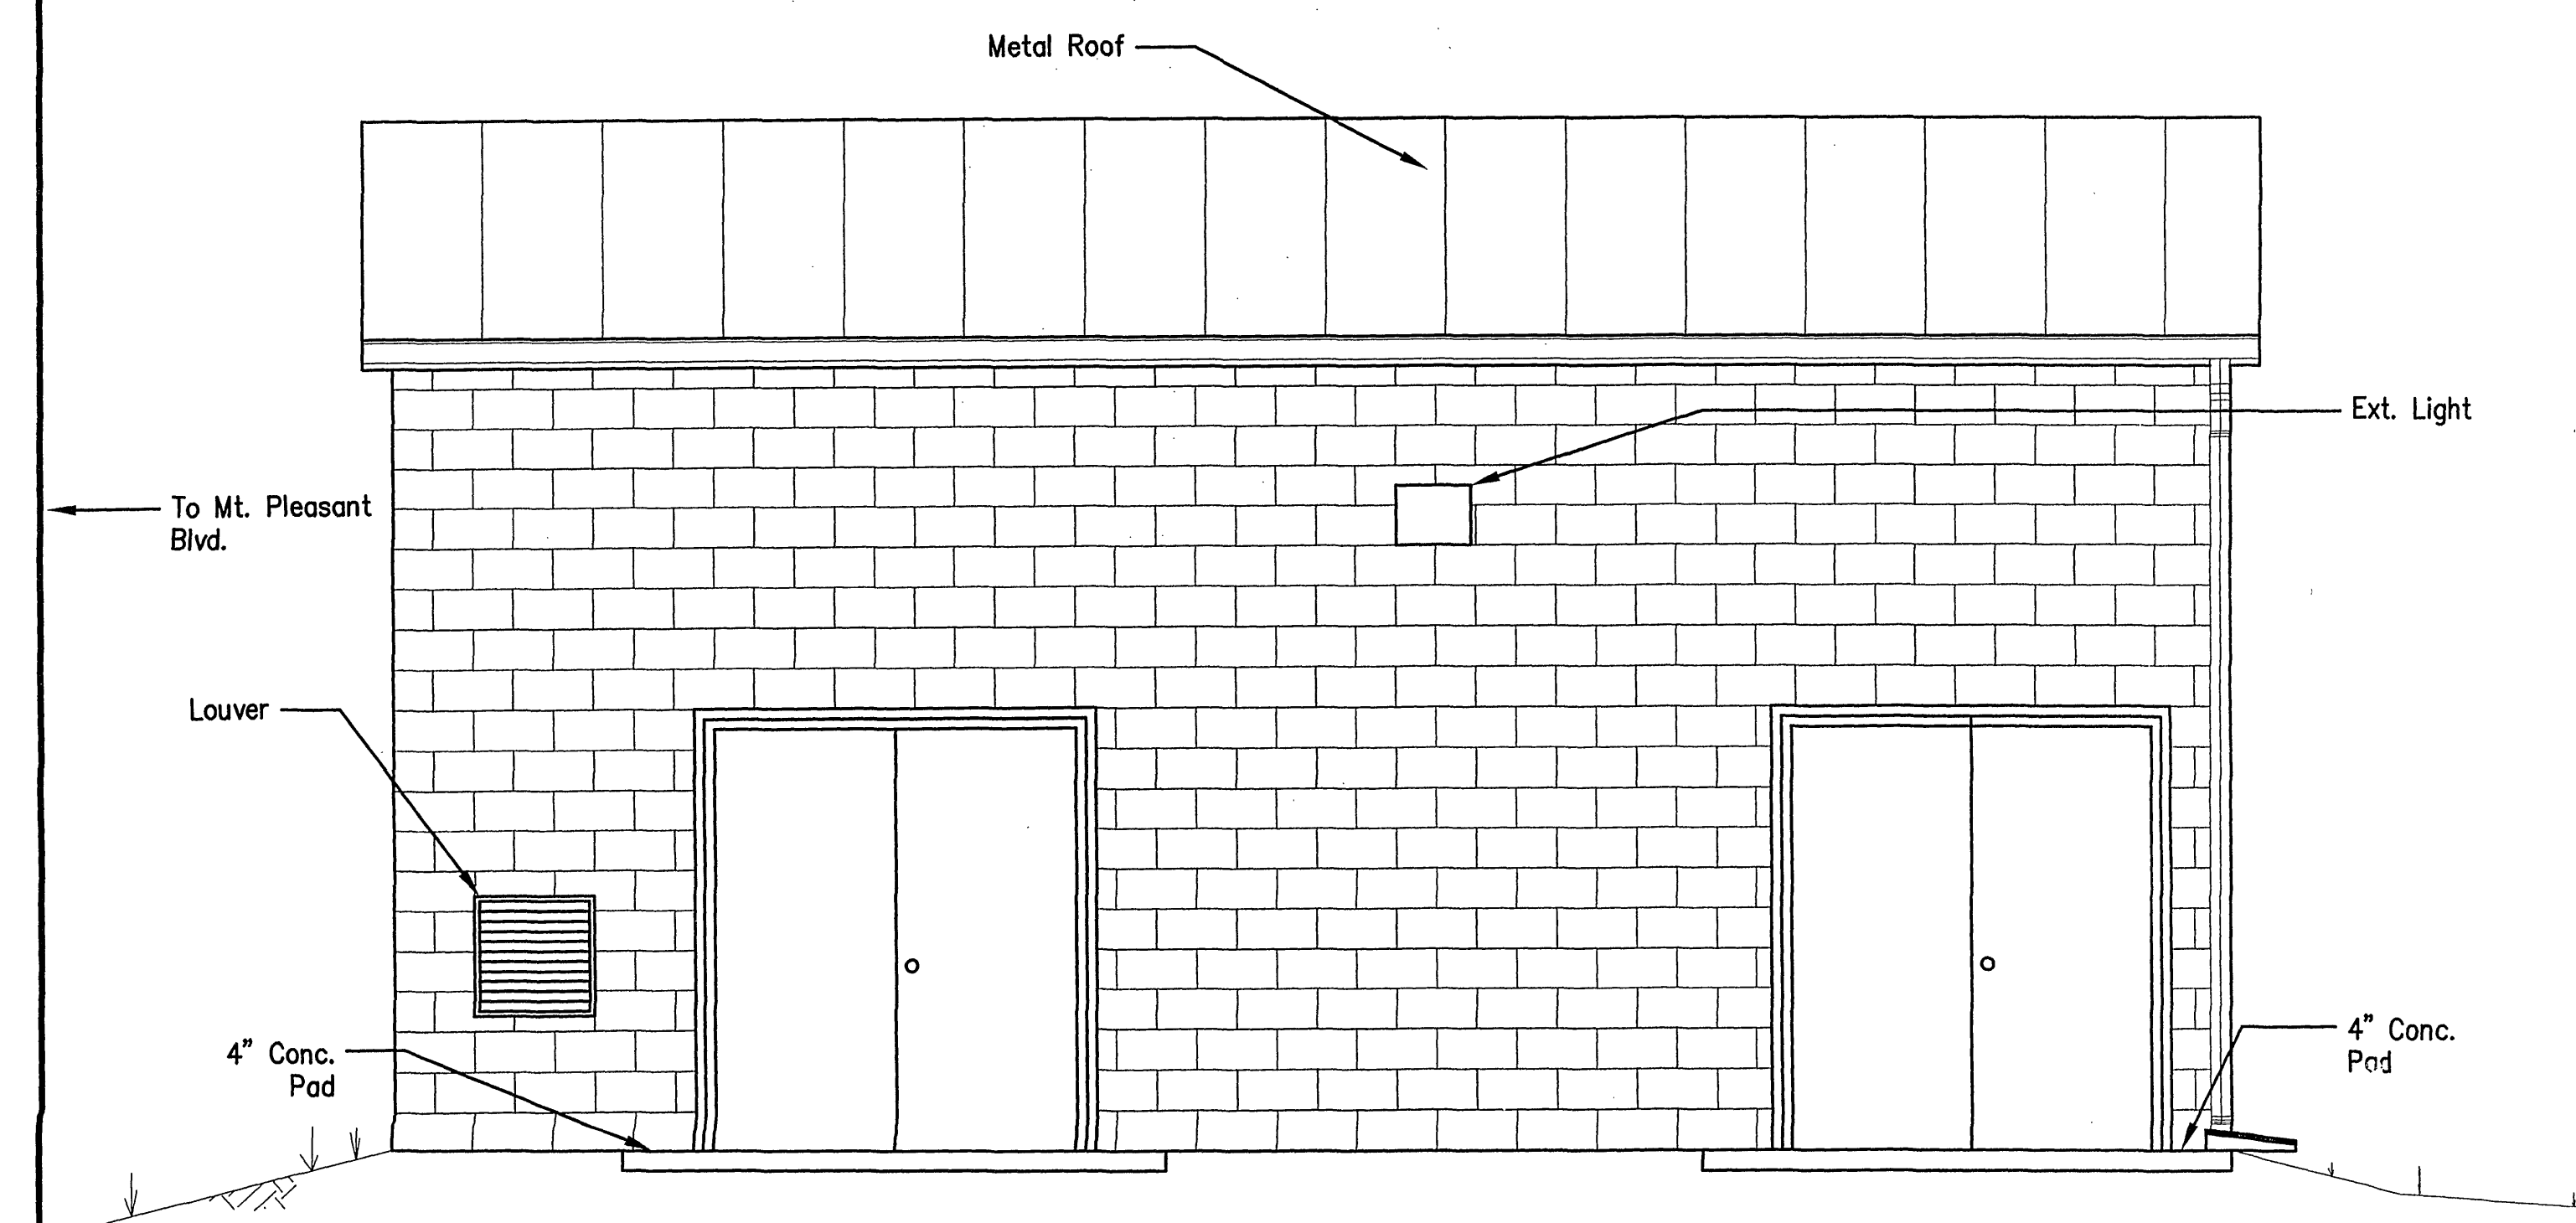


WEST VIEW

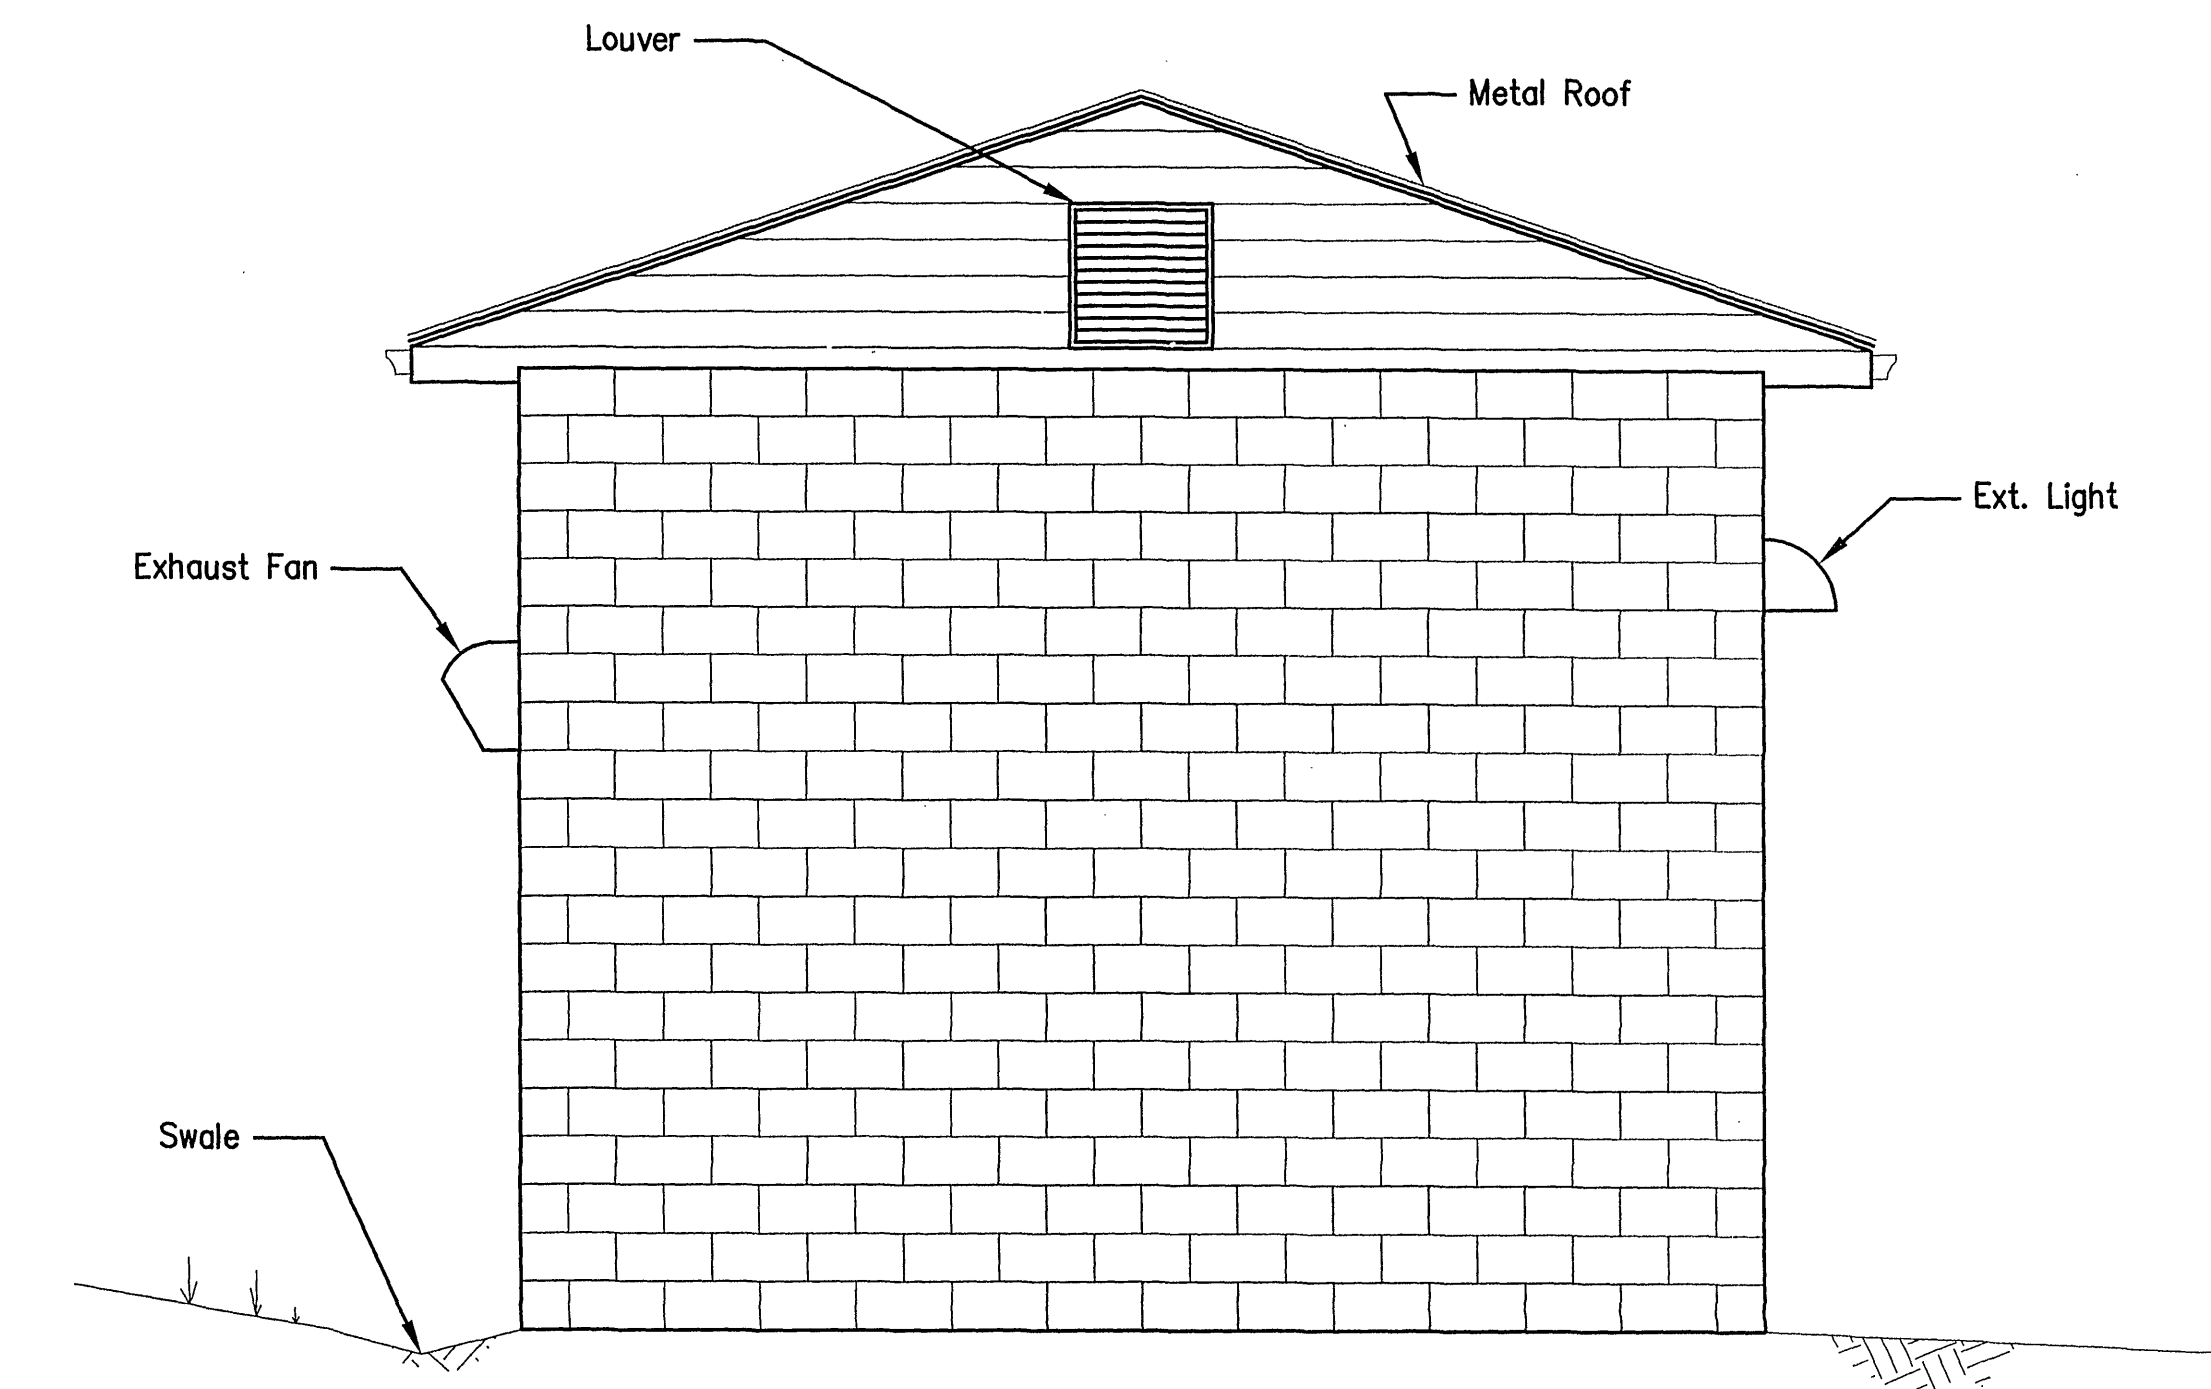

NORTH VIEW

as Built
2-9-12

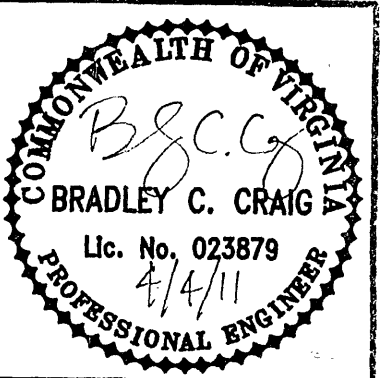

Date	
Revisions	

Issue Date:	Mar. 9, 2011
Drawn By:	RPK
Designed By:	RPK
Checked By:	BCC
Date:	Mar. 9, 2011

Mattern & Craig
CONSULTING ENGINEERS • SURVEYORS
701 FIRST STREET, S.W.
ROANOKE, VA 24004
PHONE (540) 345-7842
FAX (540) 345-7881

MOUNT PLEASANT PUMP STATION
& UTILITY RELOCATION
PUMP STATION - ELEVATION VIEW
ROANOKE, VIRGINIA

Vertical Scale:	
Horizontal Scale:	3/8" = 1'
Commission Number:	2900K