

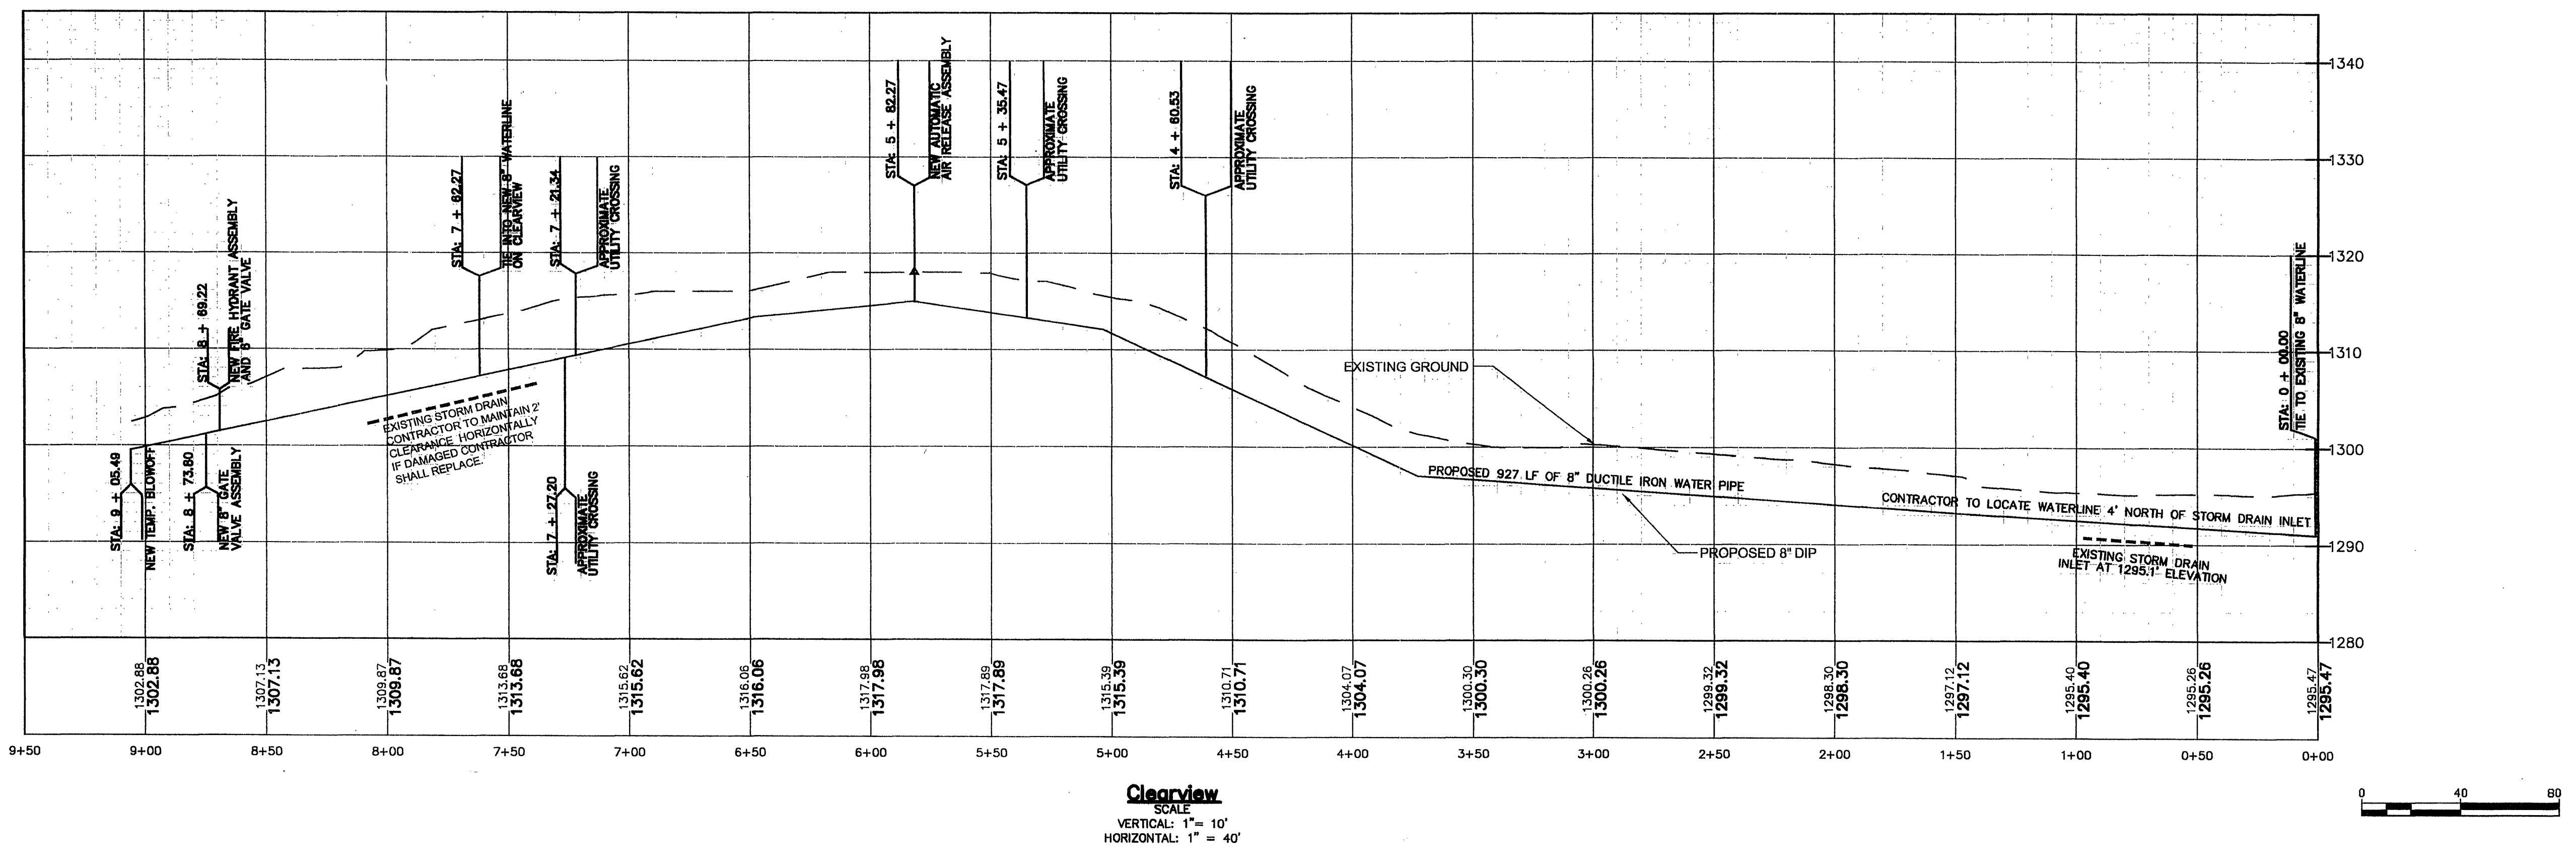


AS-BUILT
10/28/2010

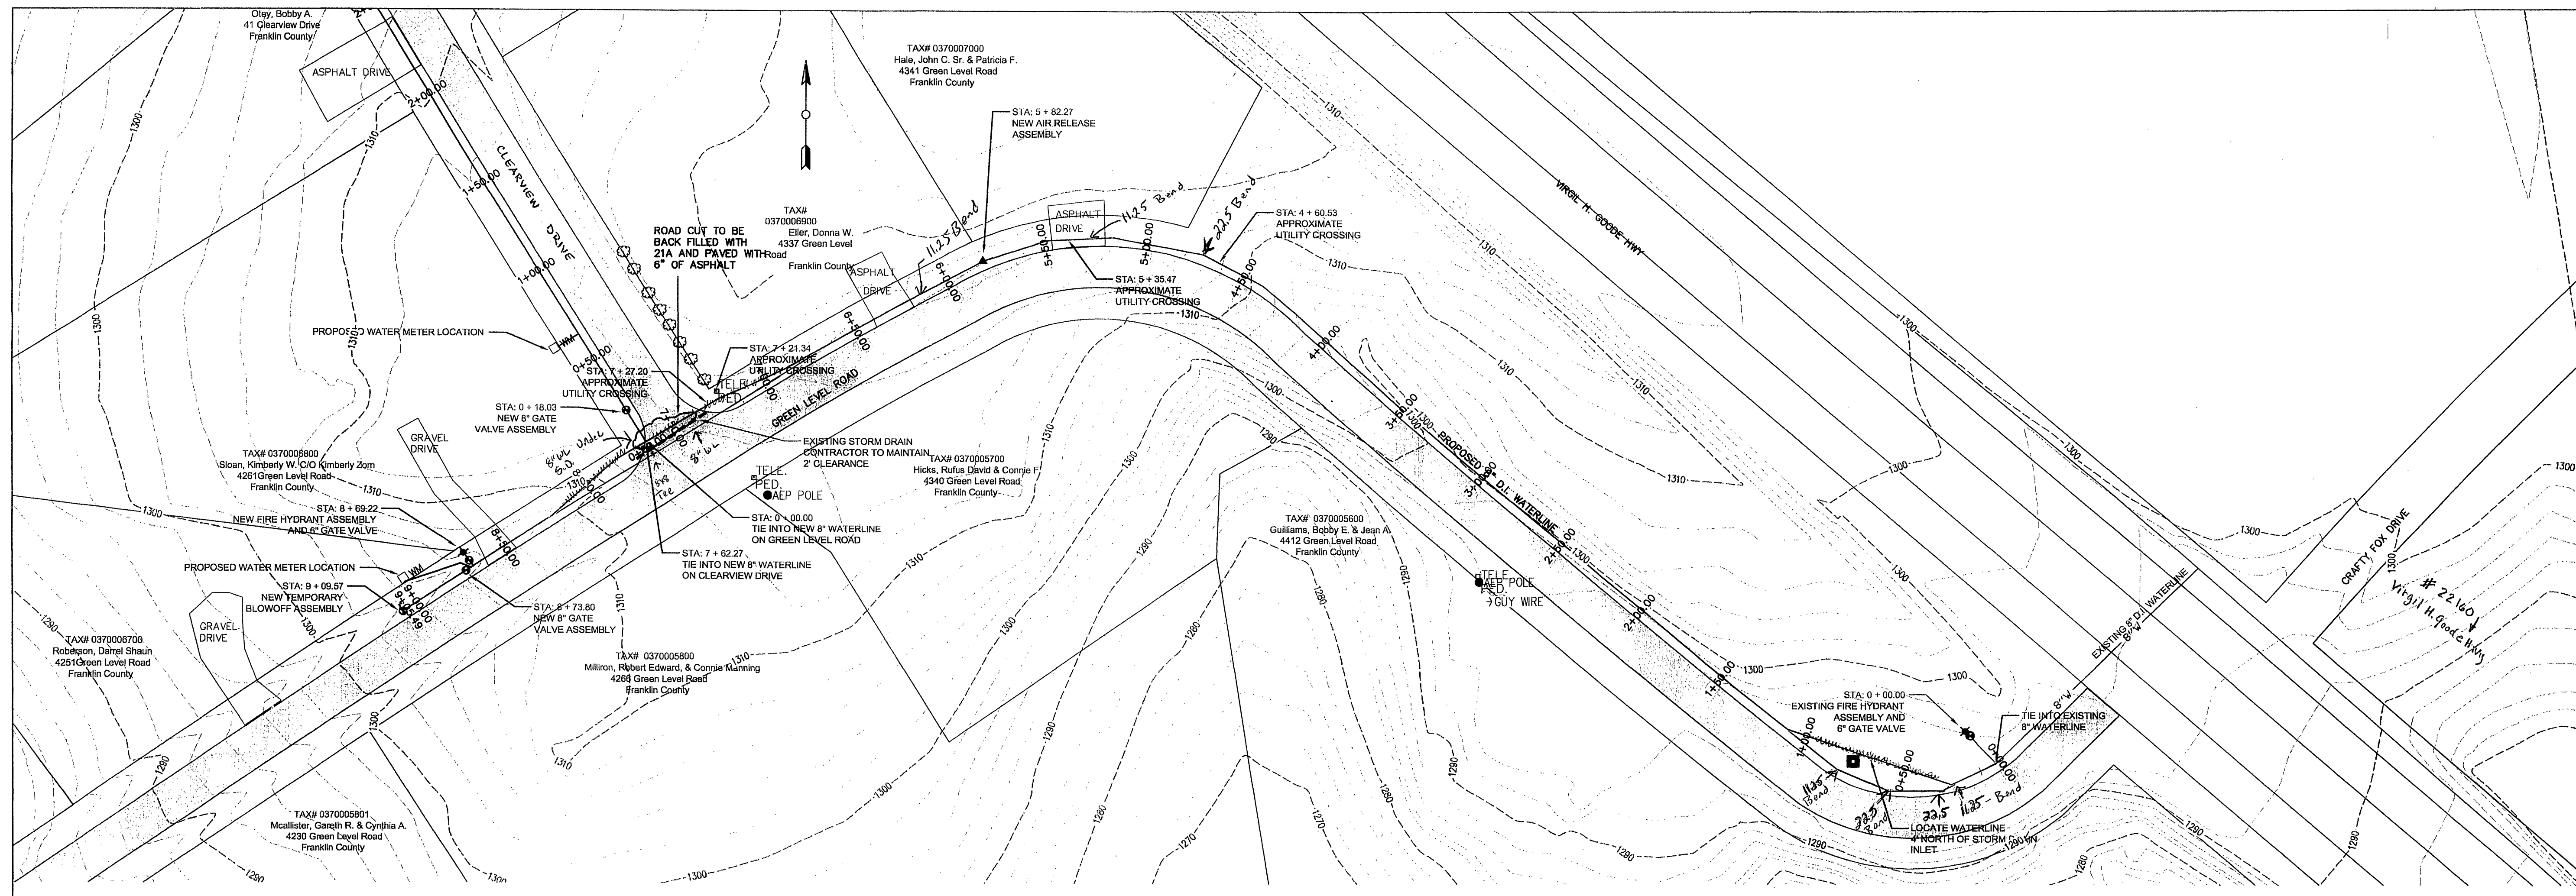

WESTERN VIRGINIA
WATER AUTHORITY
ENGINEERING SERVICES
601 S JEFFERSON ST, SUITE 300
ROANOKE, VA 24011
540-853-5641 or 540-853-5770

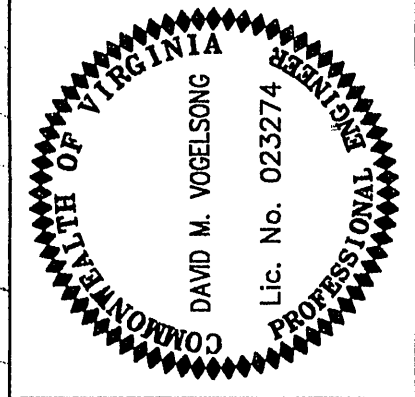

220 PROJECT CHANGE ORDER
GREEN LEVEL WATERLINE EXT.
PLAN/PROFILE

Rev	Description	Date	By

Designed: DMV
Drawn: LBR
Checked: DMV
Approved:
Date: 6/7/2010
Project:
C1
Sheet 1 of 2

Green Level rd 900'
Mense rd 898'