
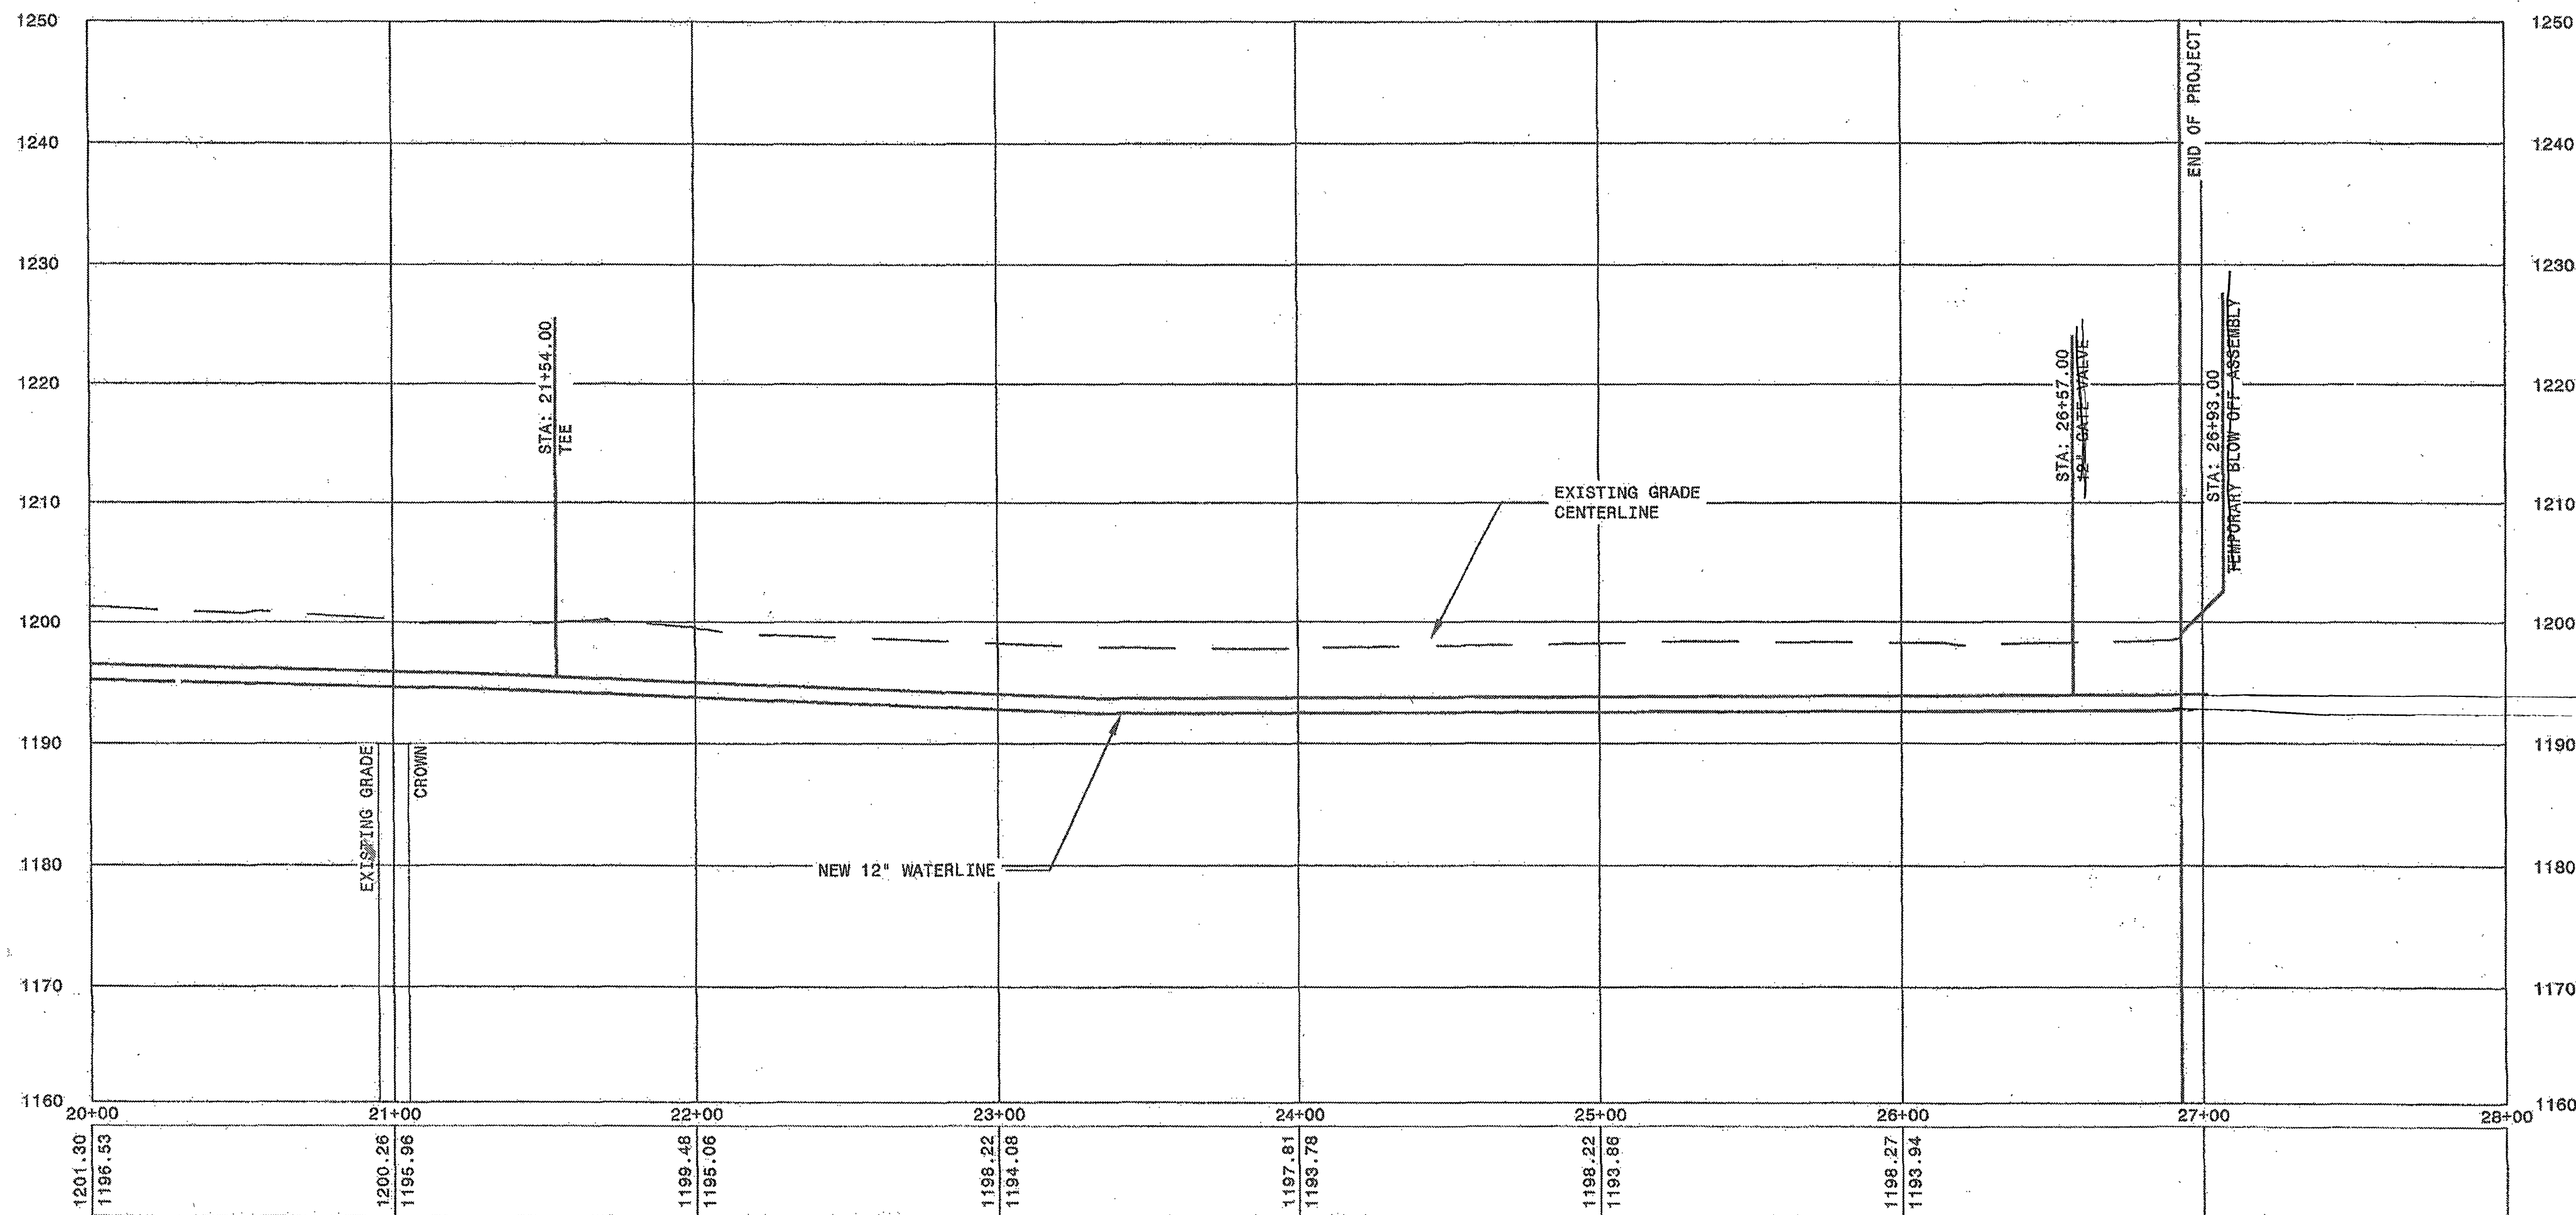


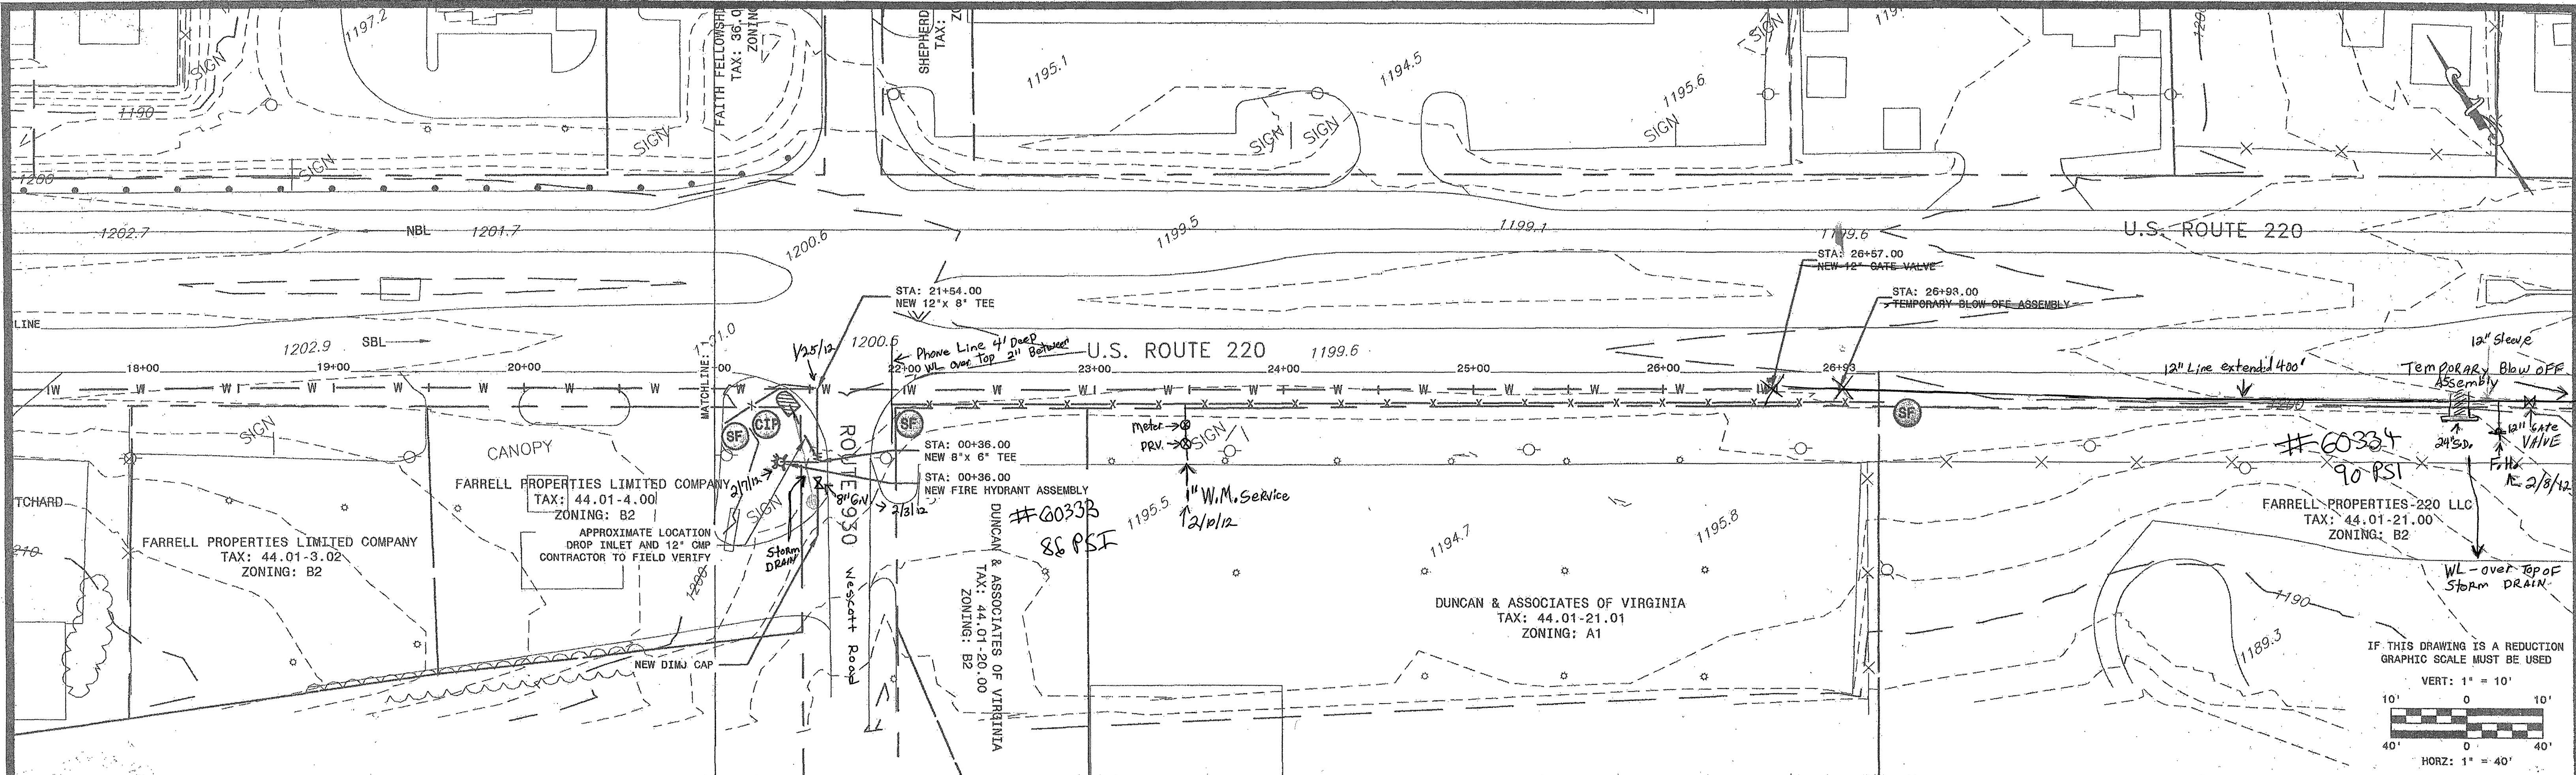


No.	Revisions:	Date:

earth
environmental and civil

ADDRESS:
235 CLAIBORNE AVE.
ROCKY MOUNT, VA 24151

PHONE NUMBERS:
PHONE: (540) 483-5975
FAX: (540) 483-2221

WEBSITE:
WWW.EARTHENV.COM

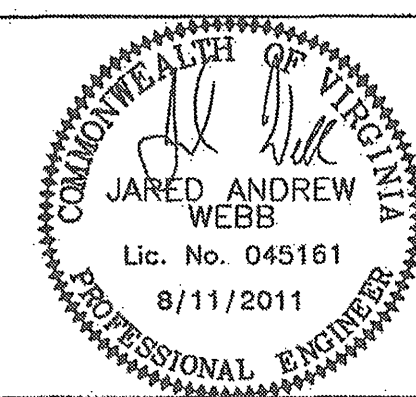

as built
3-30-12

DESIGN BY: BKS	PROJECT: ROUTE 220 WATERLINE EXTENSION	DATE: 8/11/2011
DRAWN BY: BKS	TITLE: US 220 WATERLINE EXTENSION PLAN AND PROFILE - STA: 21+00.00 TO 27+02.00	DRAWING NUMBER: C2
REVIEWED BY: JAW	DRAWING NAME: 11-0061.dwg	SHEET NUMBER: 3 of 5
PROJECT NUMBER: 11-0061	SCALE: H: 1" = 40' V: 1" = 10'	