

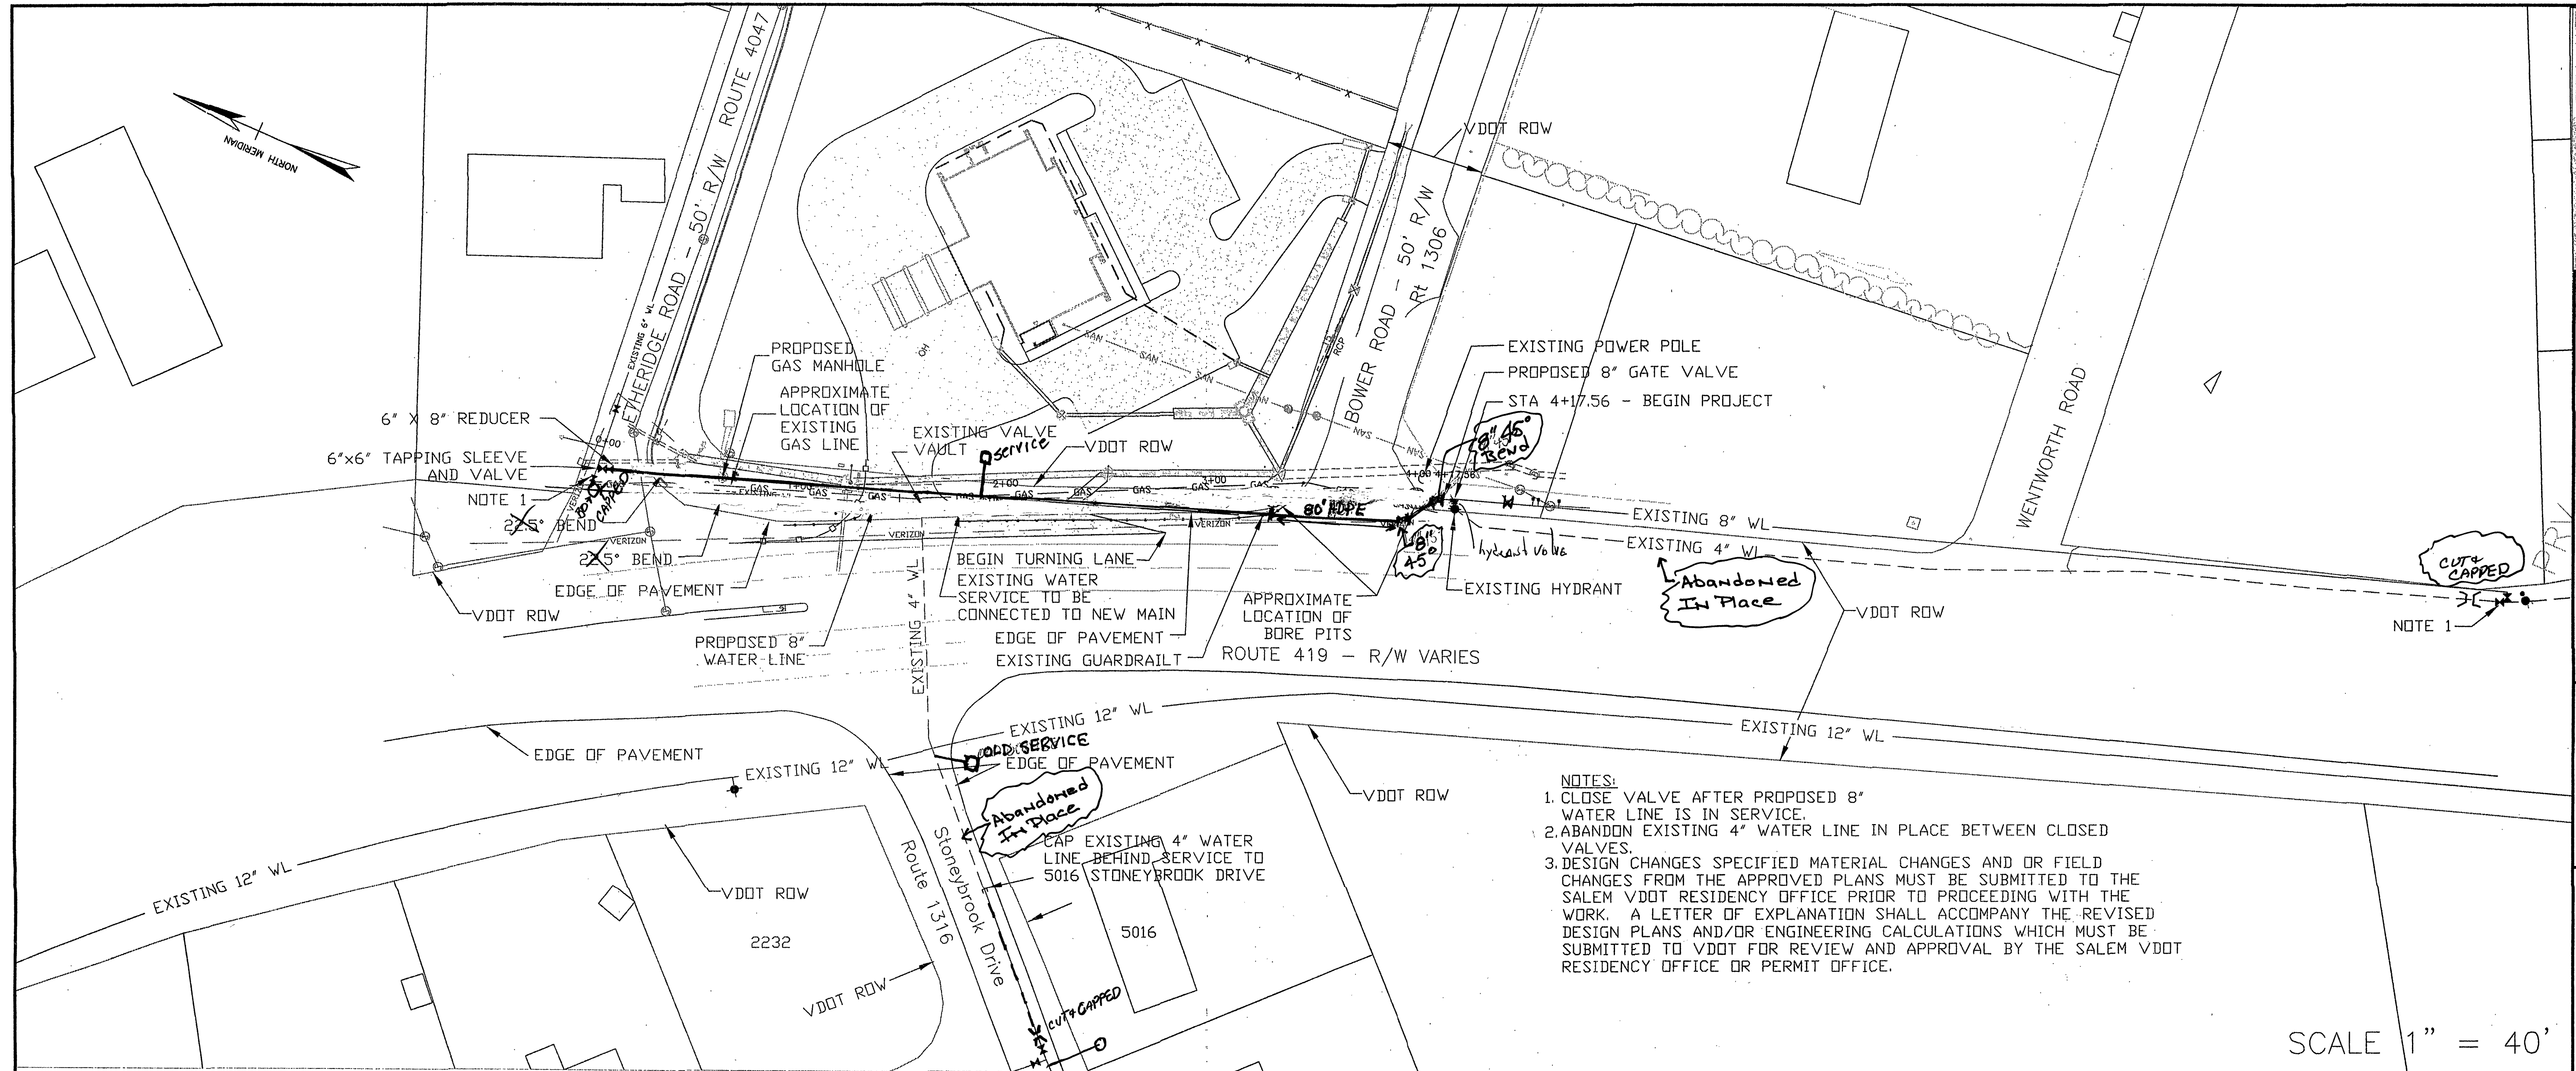


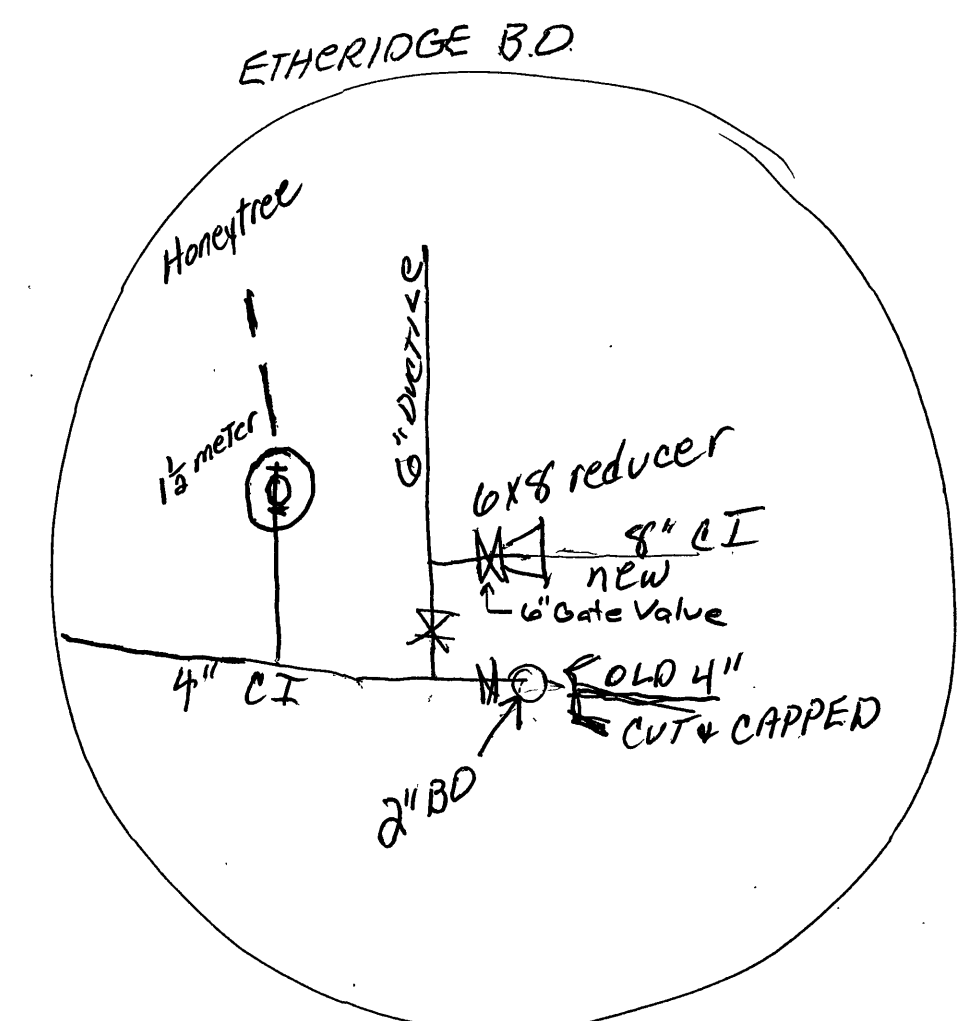


- NOTES:
1. CLOSE VALVE AFTER PROPOSED 8" WATER LINE IS IN SERVICE.
 2. ABANDON EXISTING 4" WATER LINE IN PLACE BETWEEN CLOSED VALVES.
 3. DESIGN CHANGES SPECIFIED MATERIAL CHANGES AND OR FIELD CHANGES FROM THE APPROVED PLANS MUST BE SUBMITTED TO THE SALEM VDOT RESIDENCY OFFICE PRIOR TO PROCEEDING WITH THE WORK. A LETTER OF EXPLANATION SHALL ACCOMPANY THE REVISED DESIGN PLANS AND/OR ENGINEERING CALCULATIONS WHICH MUST BE SUBMITTED TO VDOT FOR REVIEW AND APPROVAL BY THE SALEM VDOT RESIDENCY OFFICE OR PERMIT OFFICE.

SCALE 1" = 40'

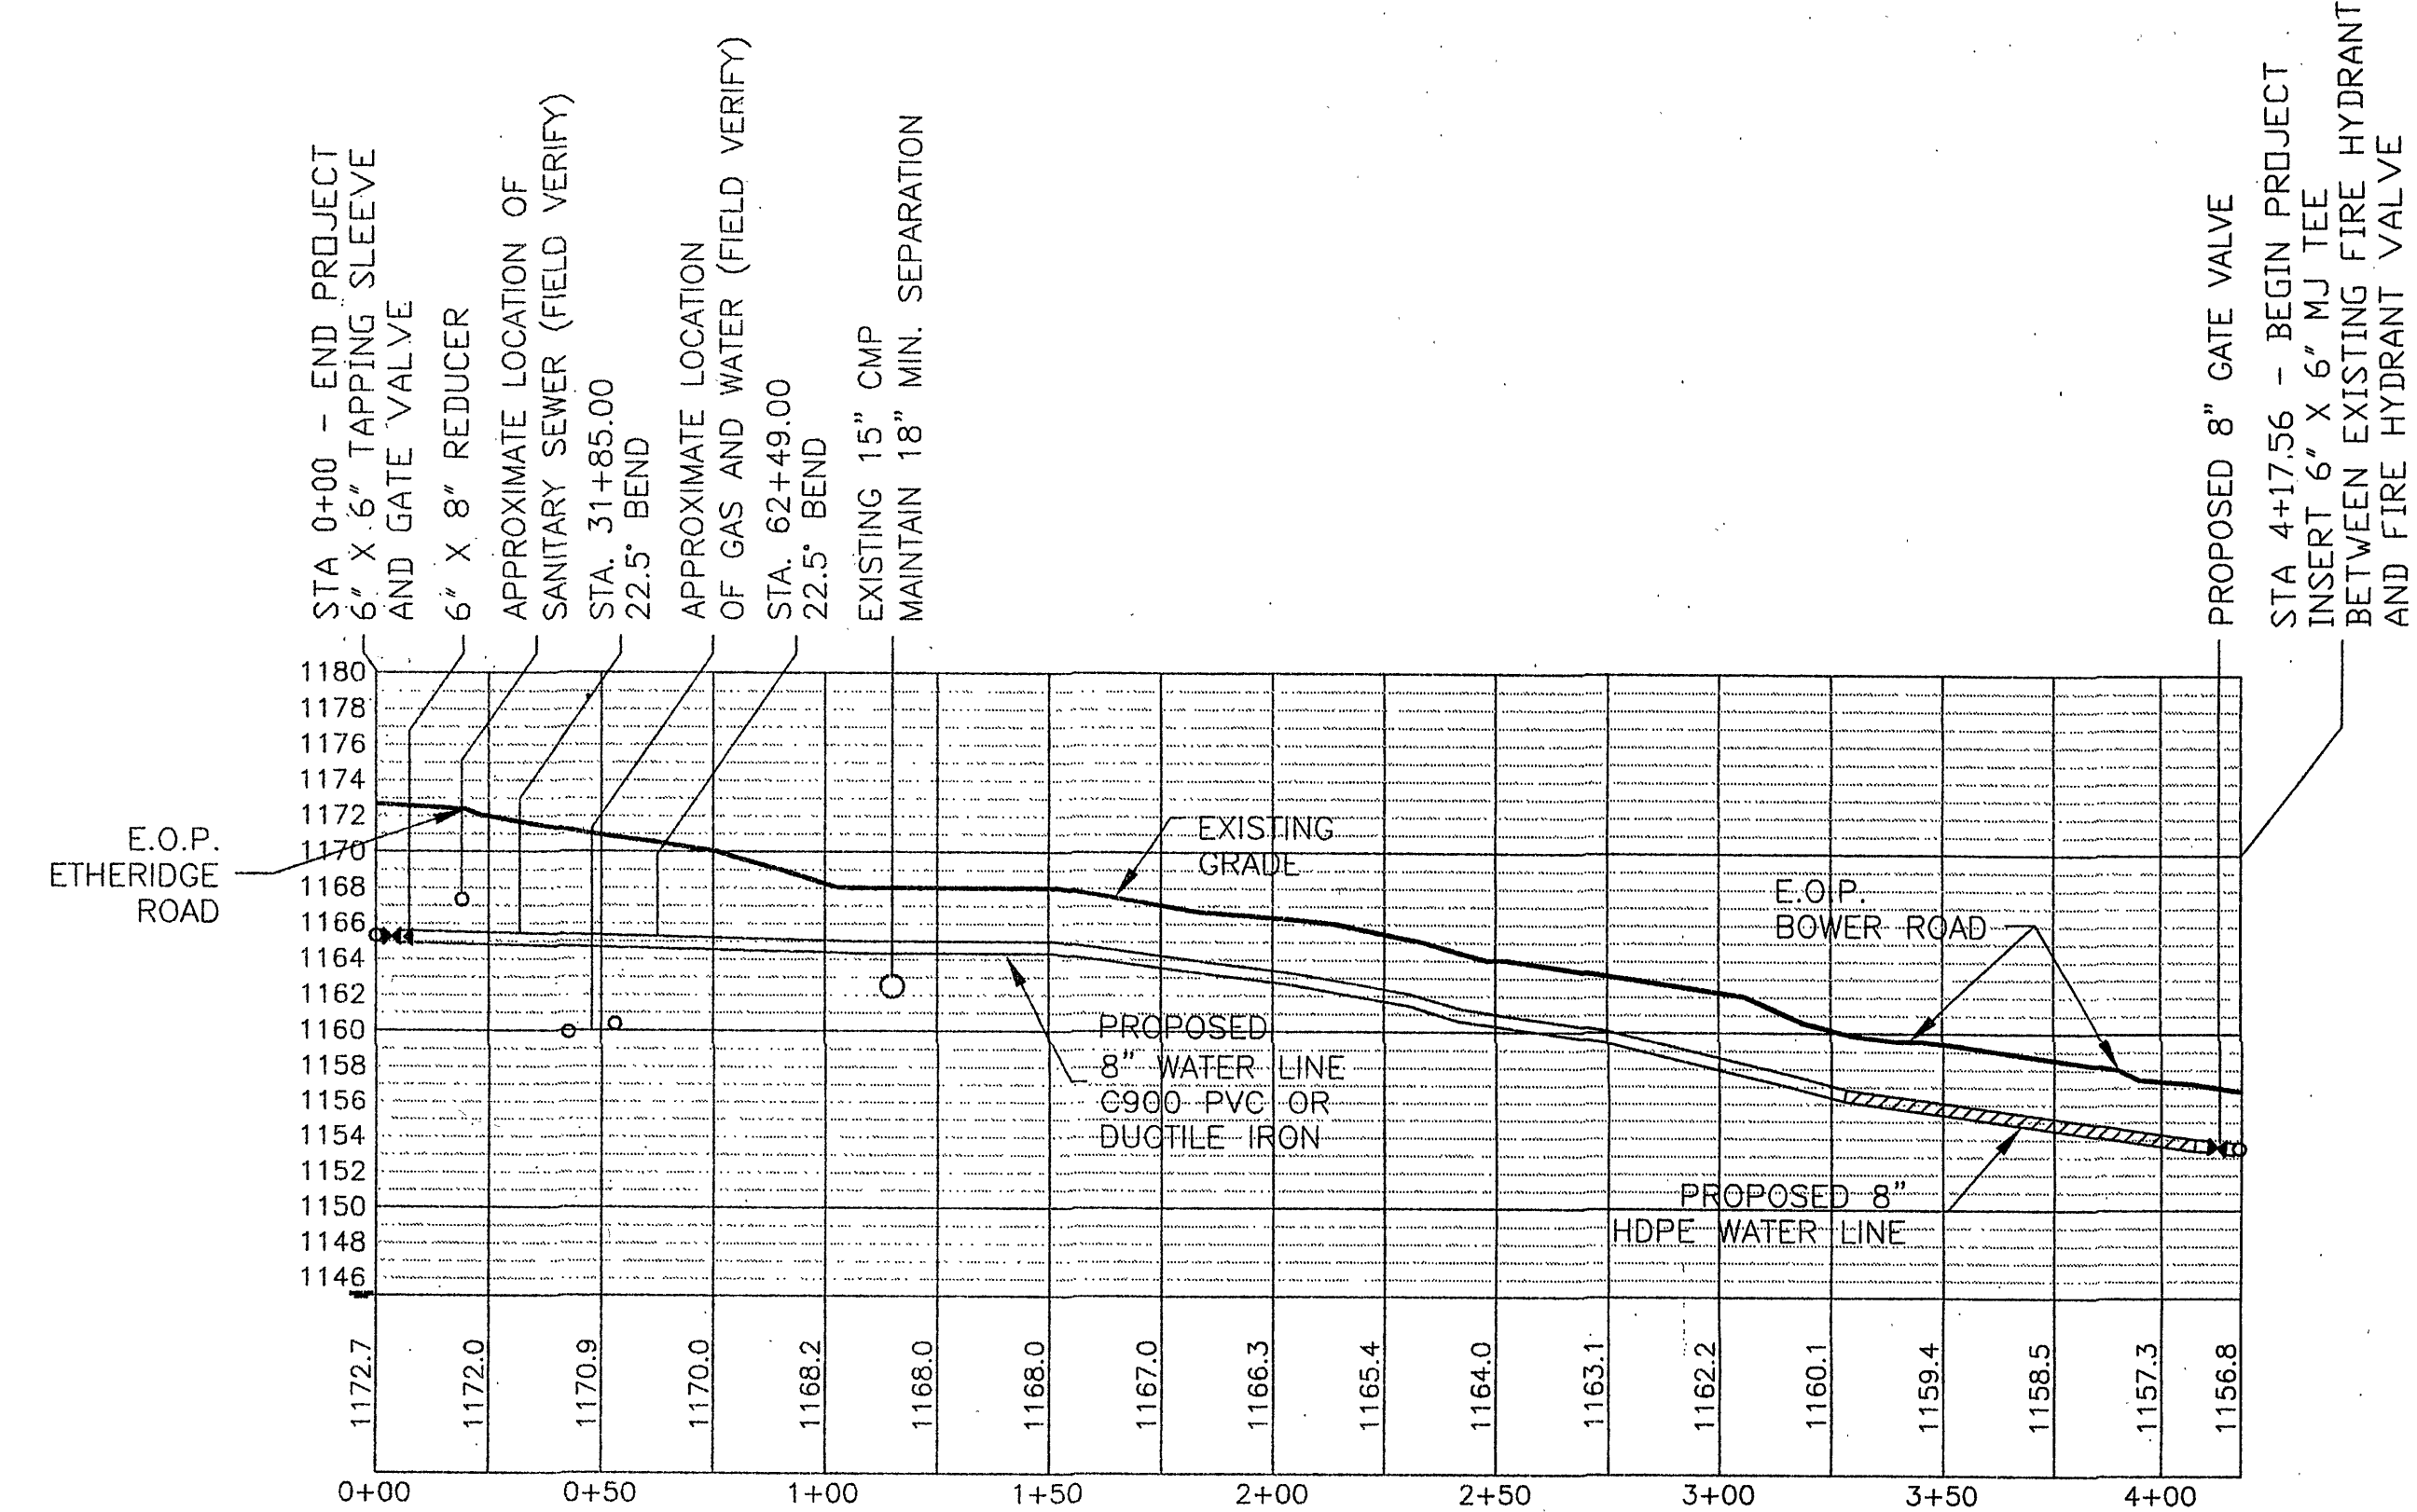


08/28/2006 AS-BUILT

HOR. SCALE 1" = 40'
VERT SCALE 1" = 10'

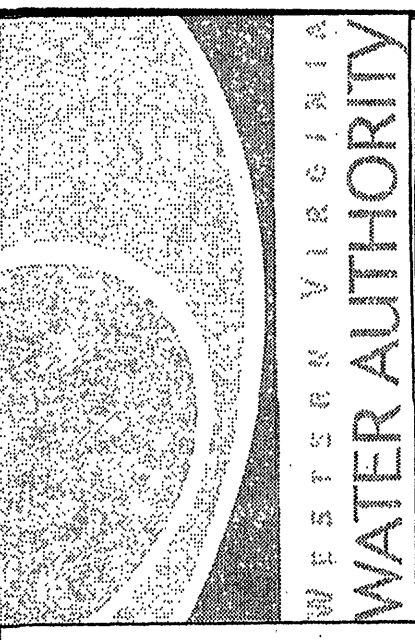

ENGINEERING SERVICES
2012 SOUTH JEFFERSON STREET
ROANOK, VIRGINIA 24014
PHONE: (540) 853-5641

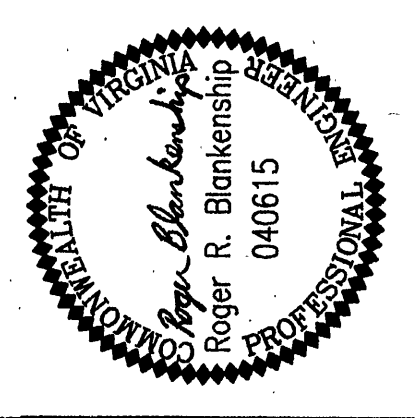

**419 WATER LINE REPLACEMENT
BOWER TO ETEHRIDGE ROAD**

Designed By:	RRB
Drawn By:	RRB
Checked By:	JGR
Date:	04/24/06
Scale:	AS SHOWN
Plan #:	00-00
Sheet:	2 OF 2