


FILE NUMBER
376

PLAN	DATE
BY	
REVIEWED	
NOTED	
NO. OF SHEETS	
NO. OF SHEETS	

PROFILE	DATE
BY	
REVIEWED	
NOTED	
NO. OF SHEETS	
NO. OF SHEETS	

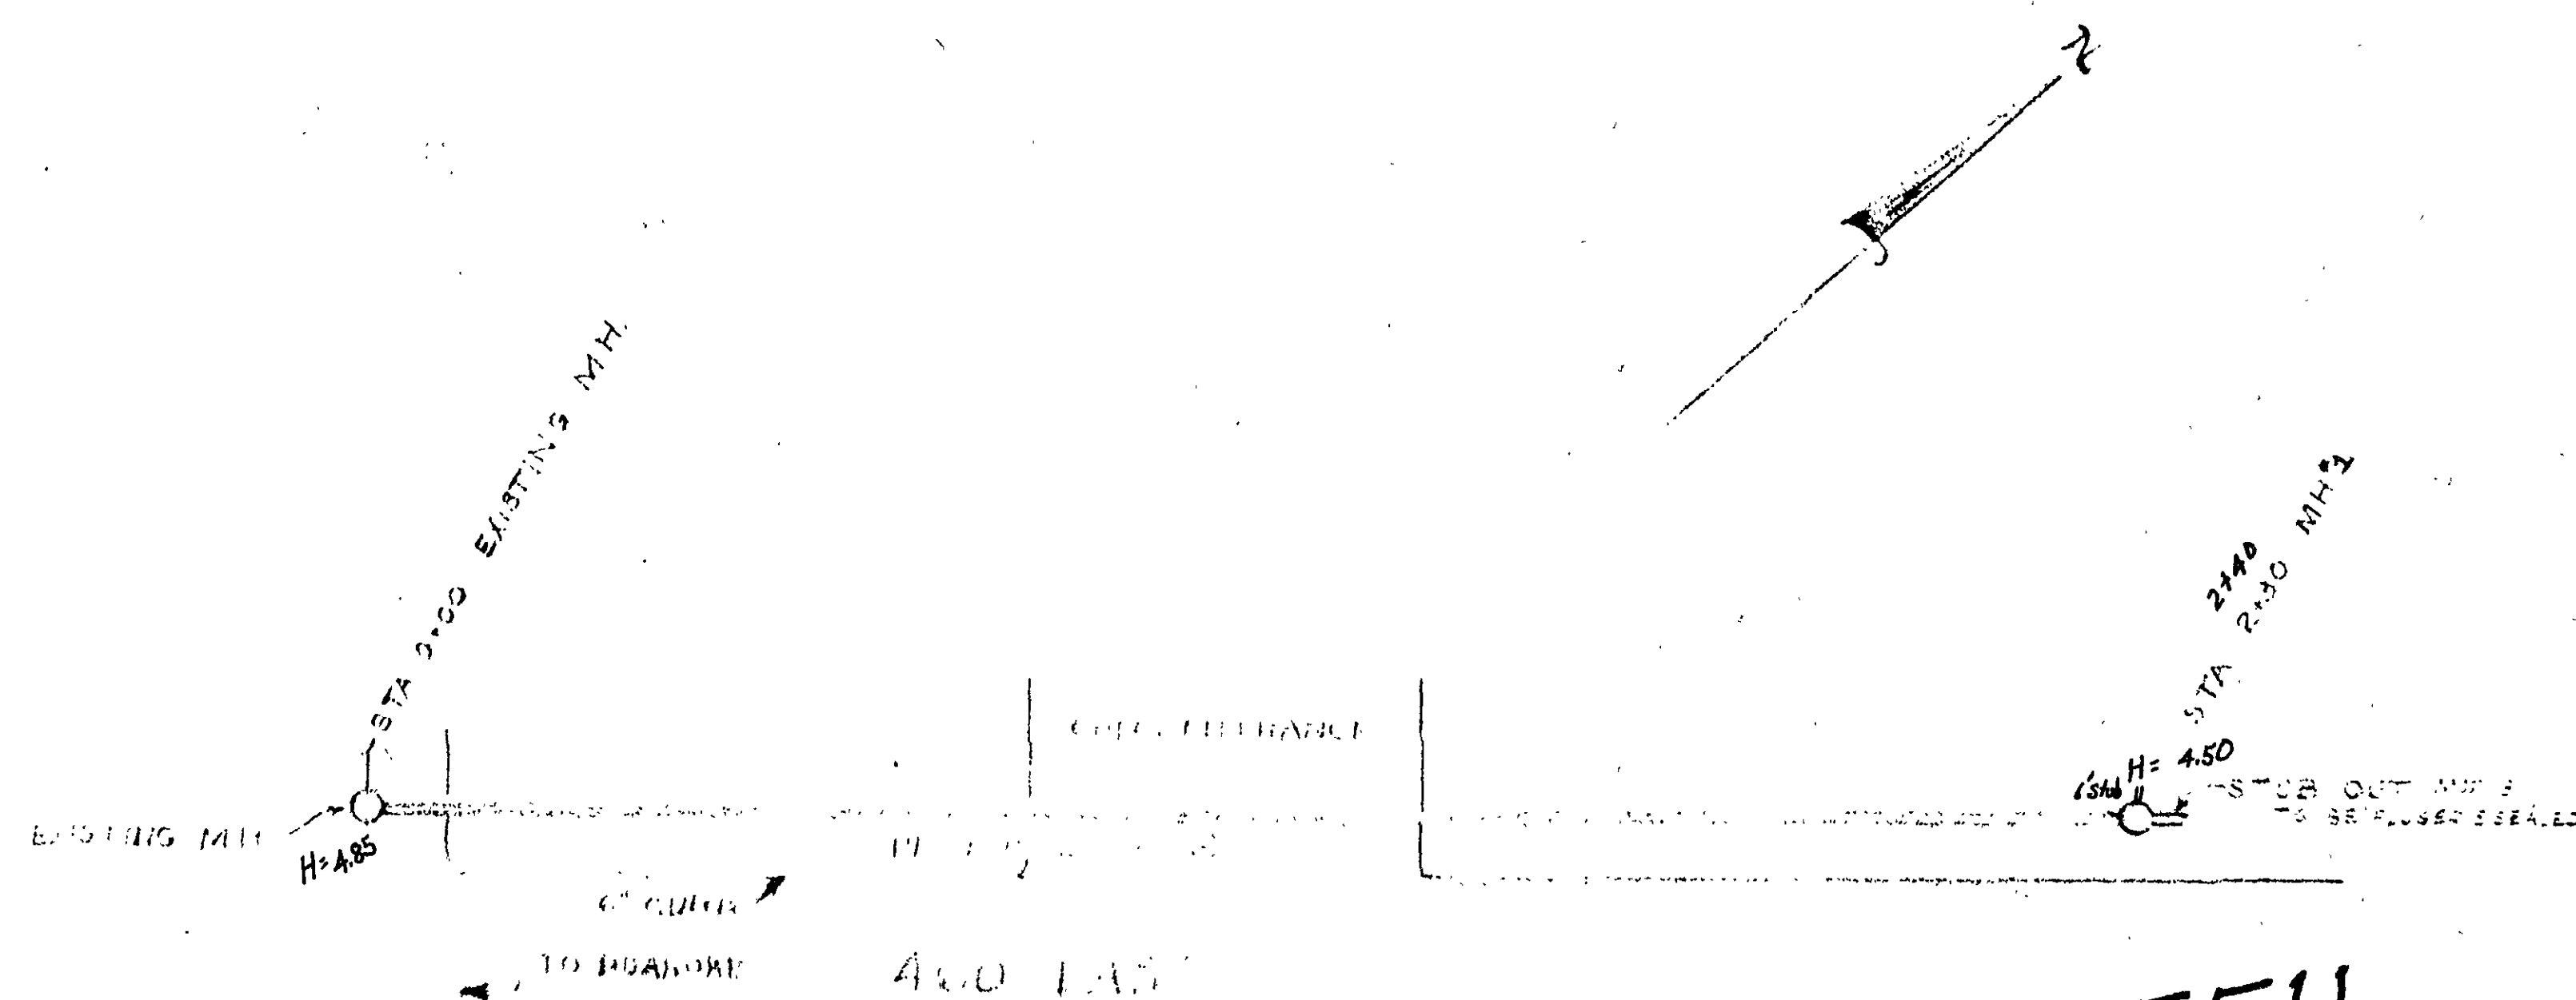

FF11

AS BUILT
IN SPOT 225

PROPOSED 10" SS
To Serve
Roanoke Tour
Home & Restaurant
460 & Gramby St.

August 20, 1974
Scale: 1" = 20' Horizontal
1" = 10' Vertical

APPROVED Robert D. Chappell
DIRECTOR OF ENGINEERING ALBANY

