
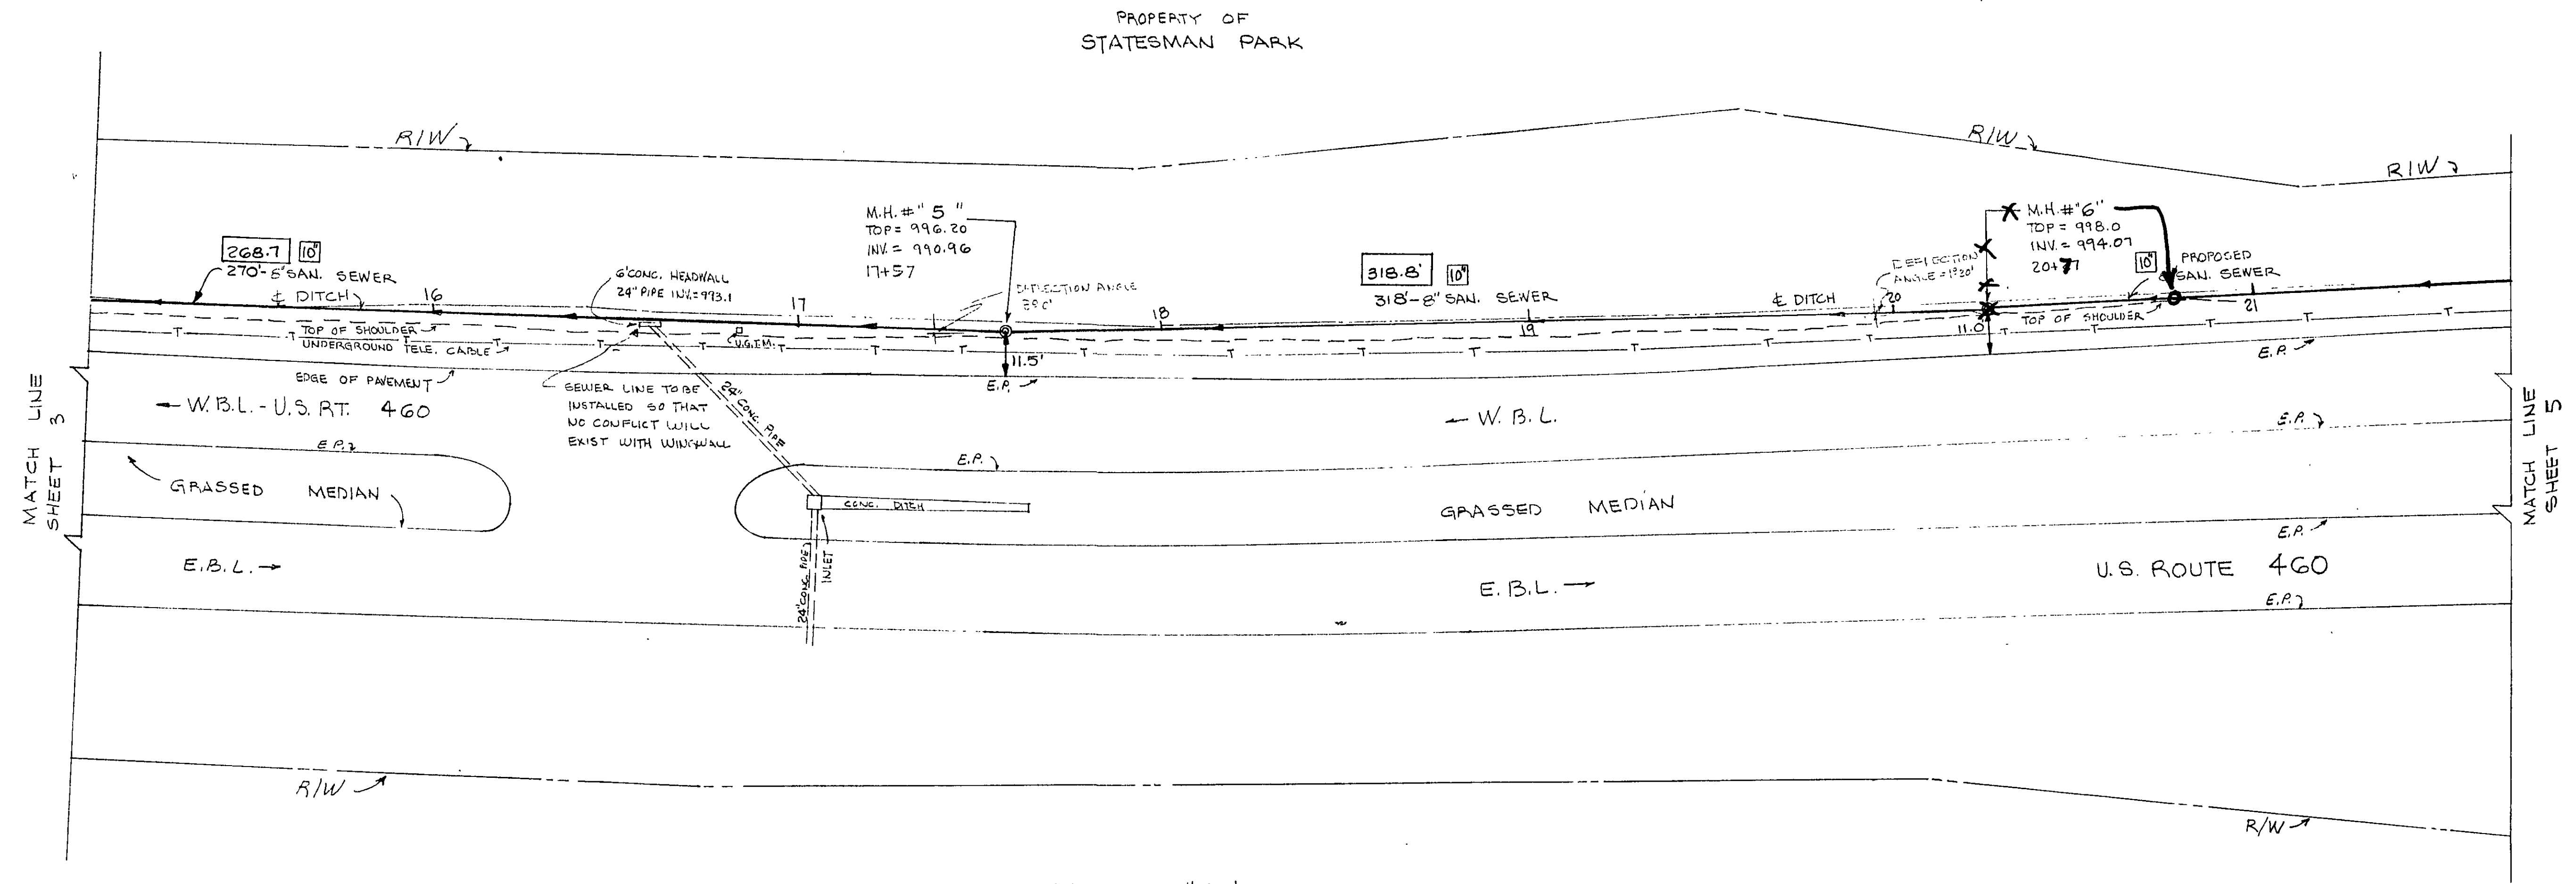



DATE	BY
SURVEYED	
PLOTTED	
CHECKED	
NO.	

DATE	BY
SURVEYED	
PLOTTED	
CHECKED	
NO.	

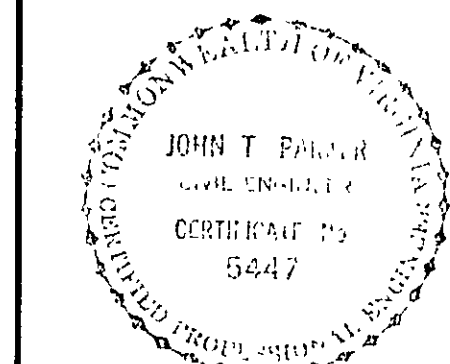

PLAN SCALE: 1"=25'

REVISED: NOVEMBER 25, 1980 "AS-BUILT"

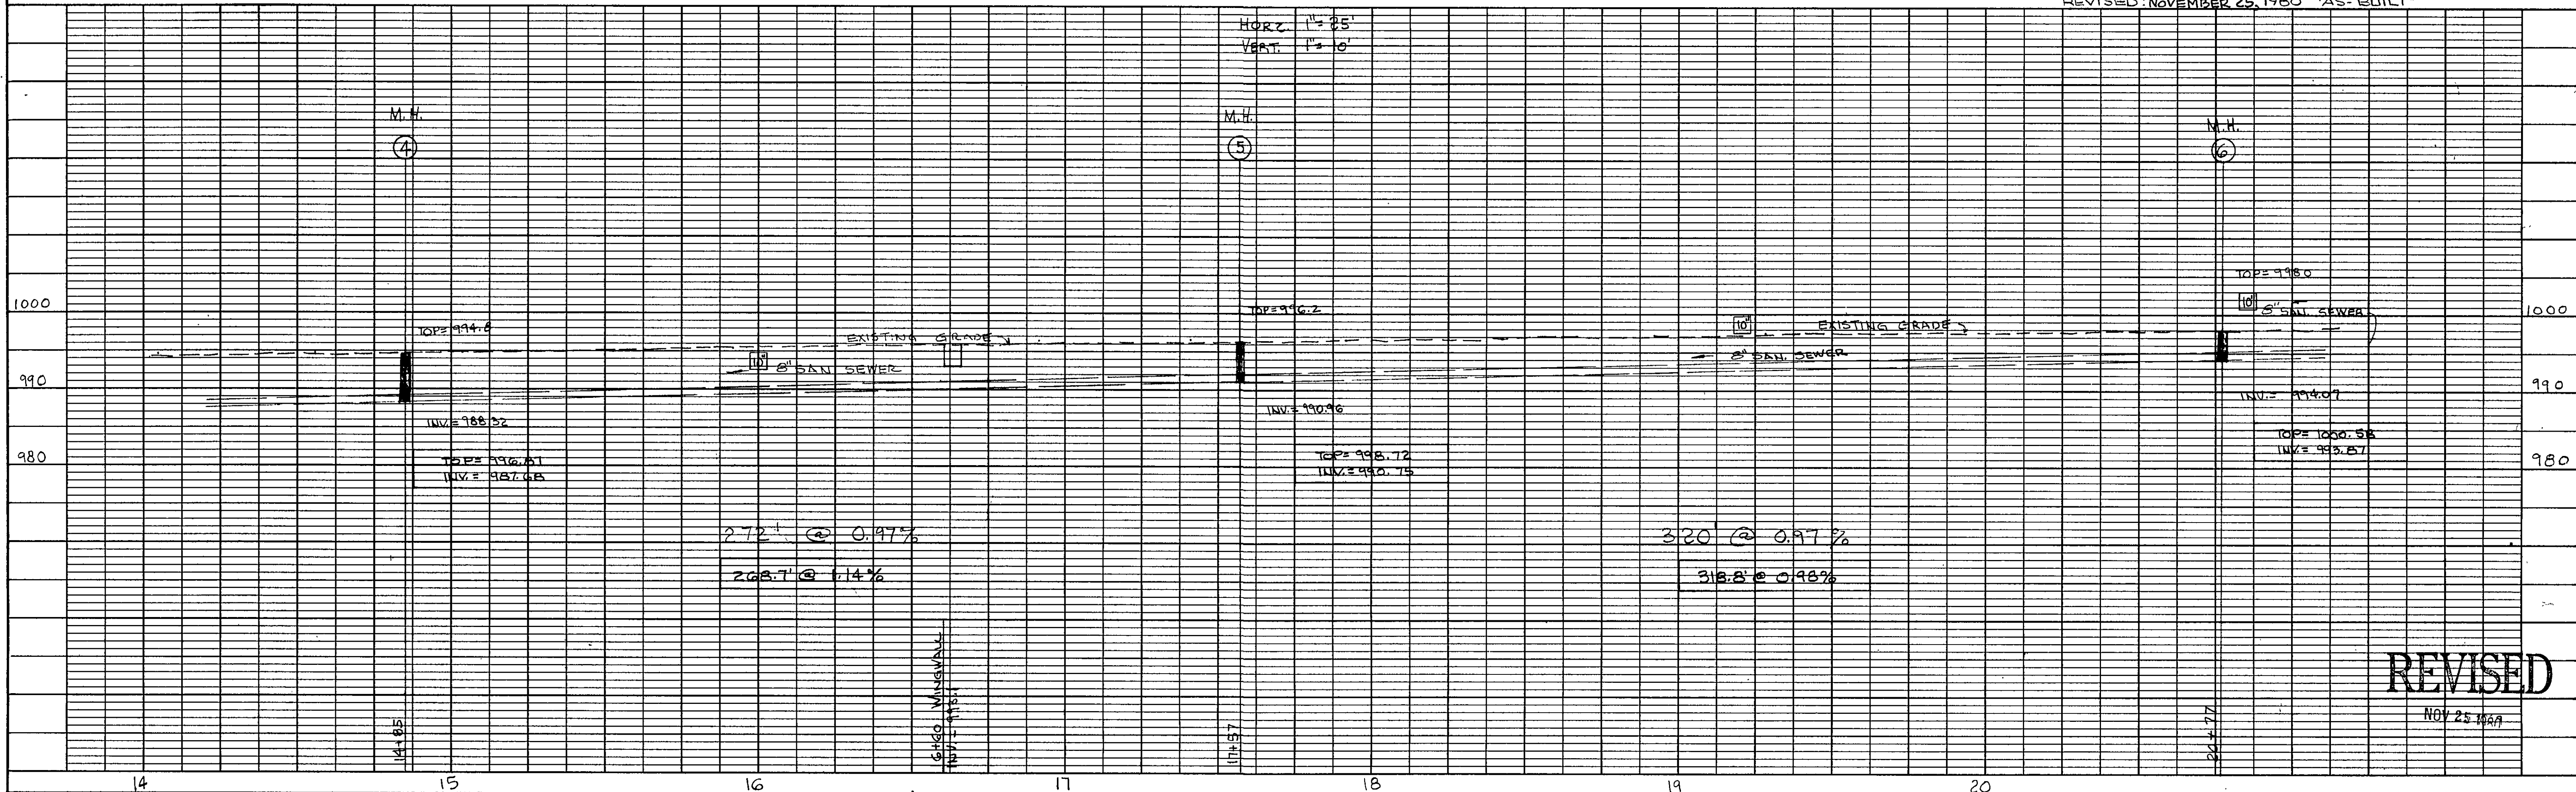

REVISED
NOV 25 1980