

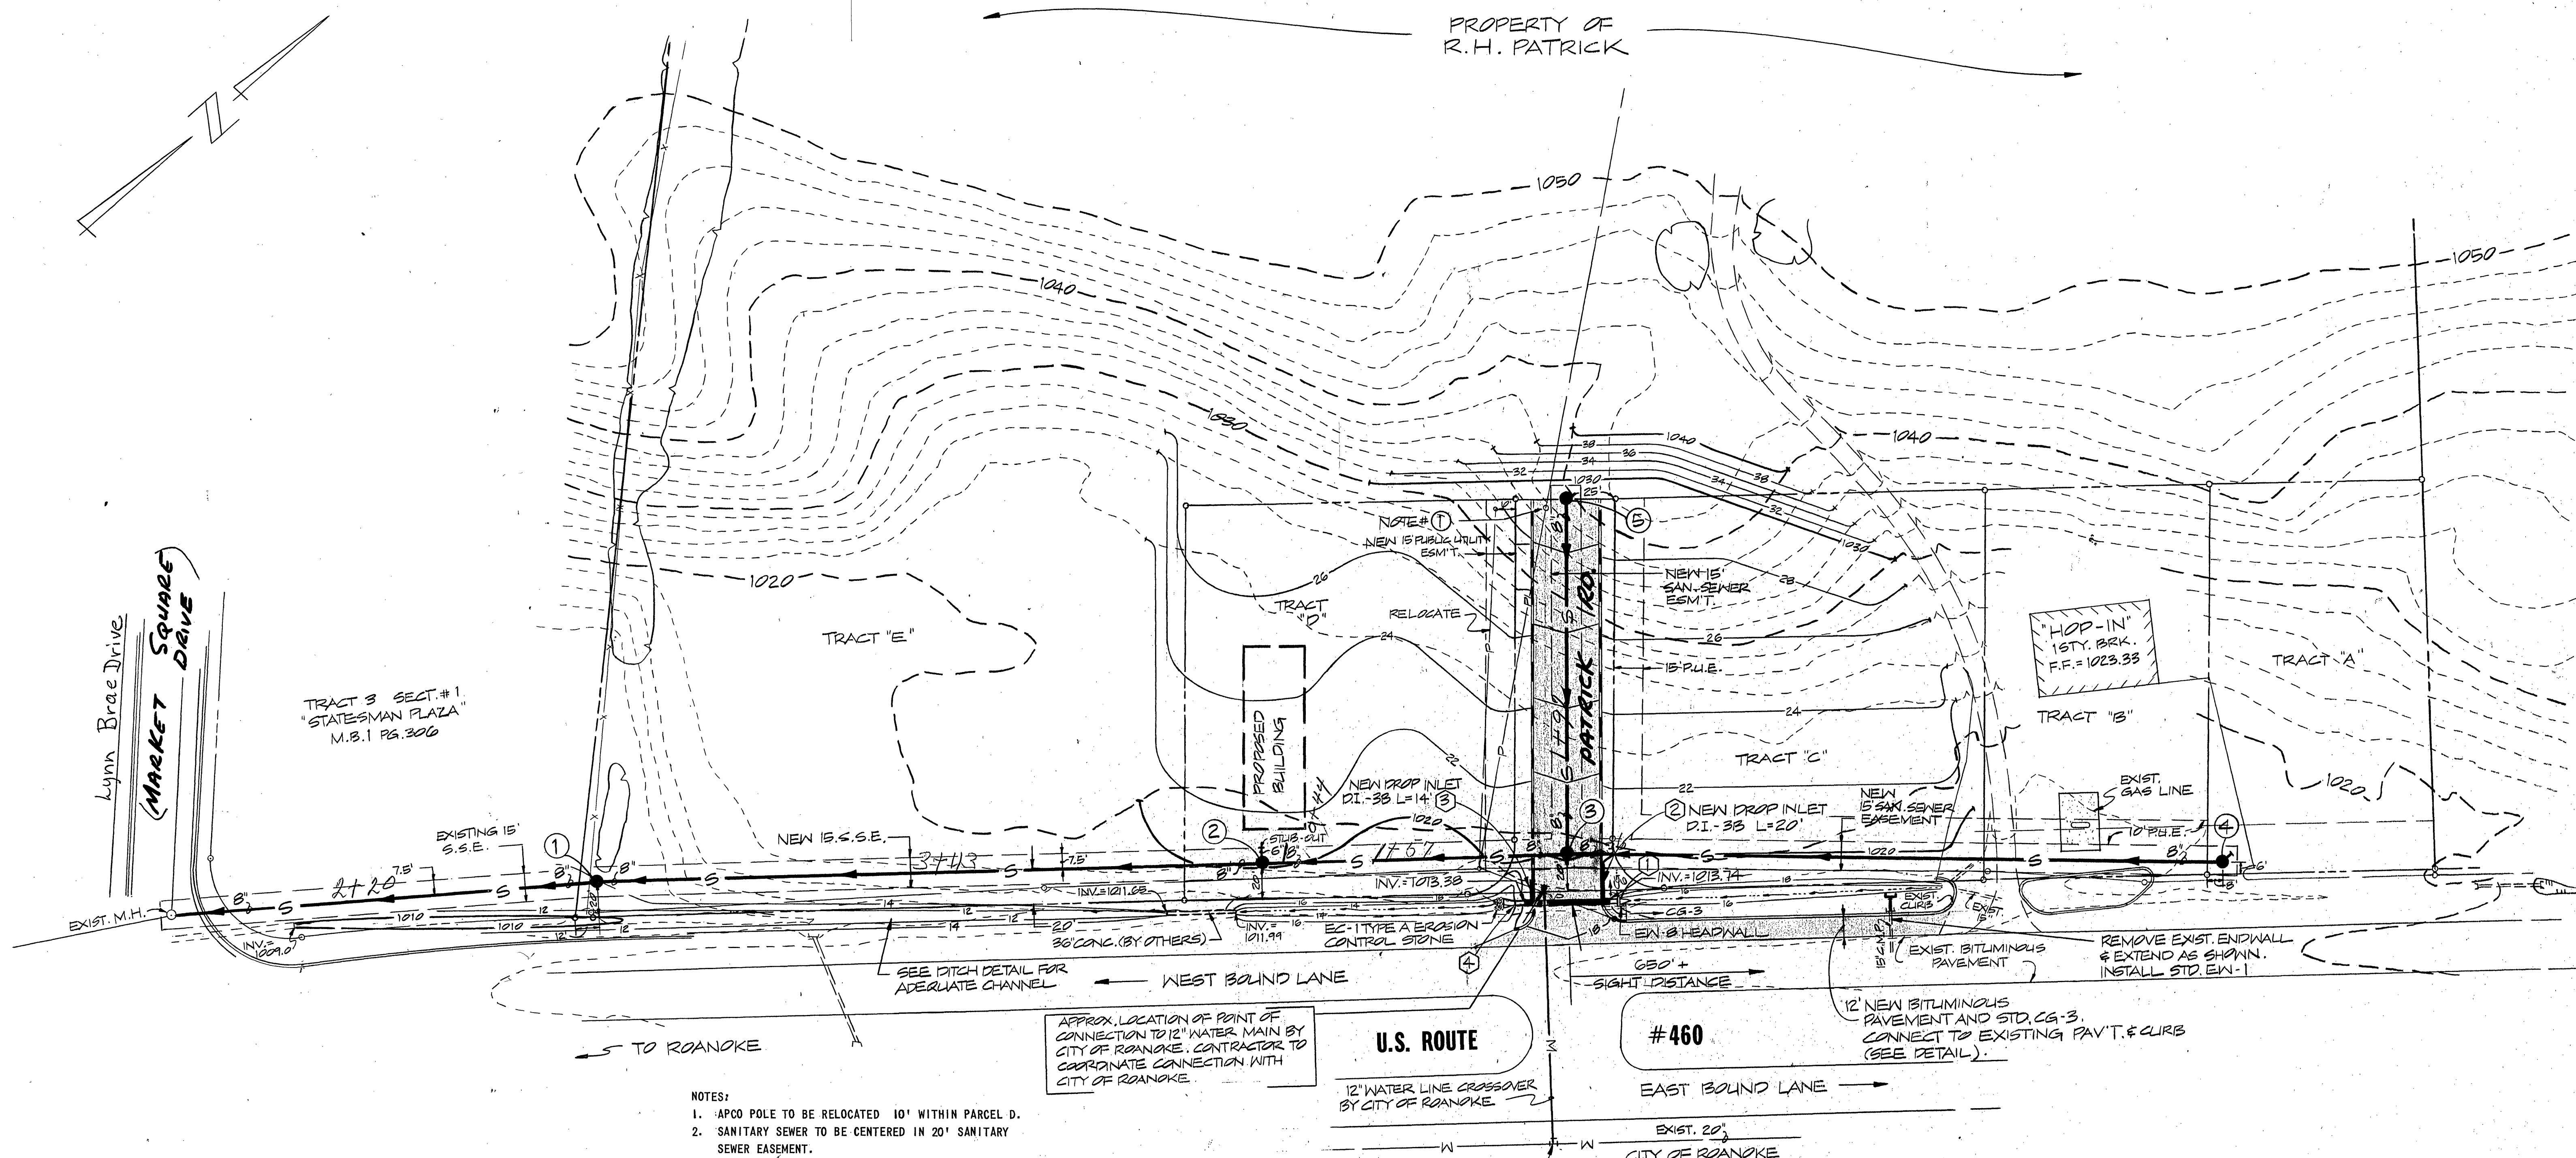
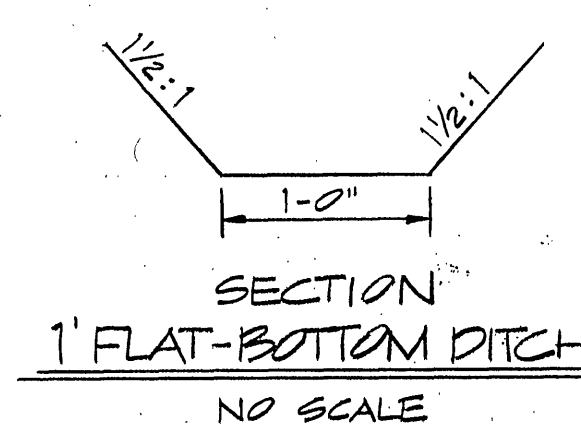


PROPERTY OF
R.H. PATRICK

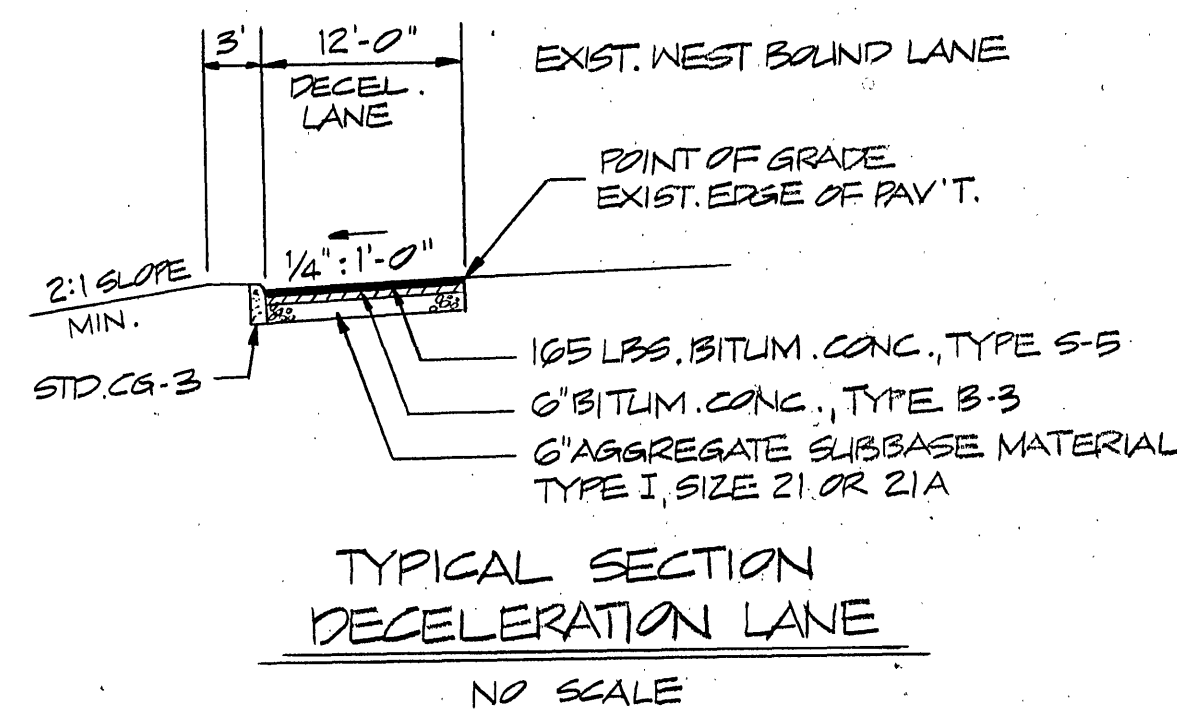

- NOTES:
1. APCO POLE TO BE RELOCATED 10' WITHIN PARCEL D.
 2. SANITARY SEWER TO BE CENTERED IN 20' SANITARY SEWER EASEMENT.

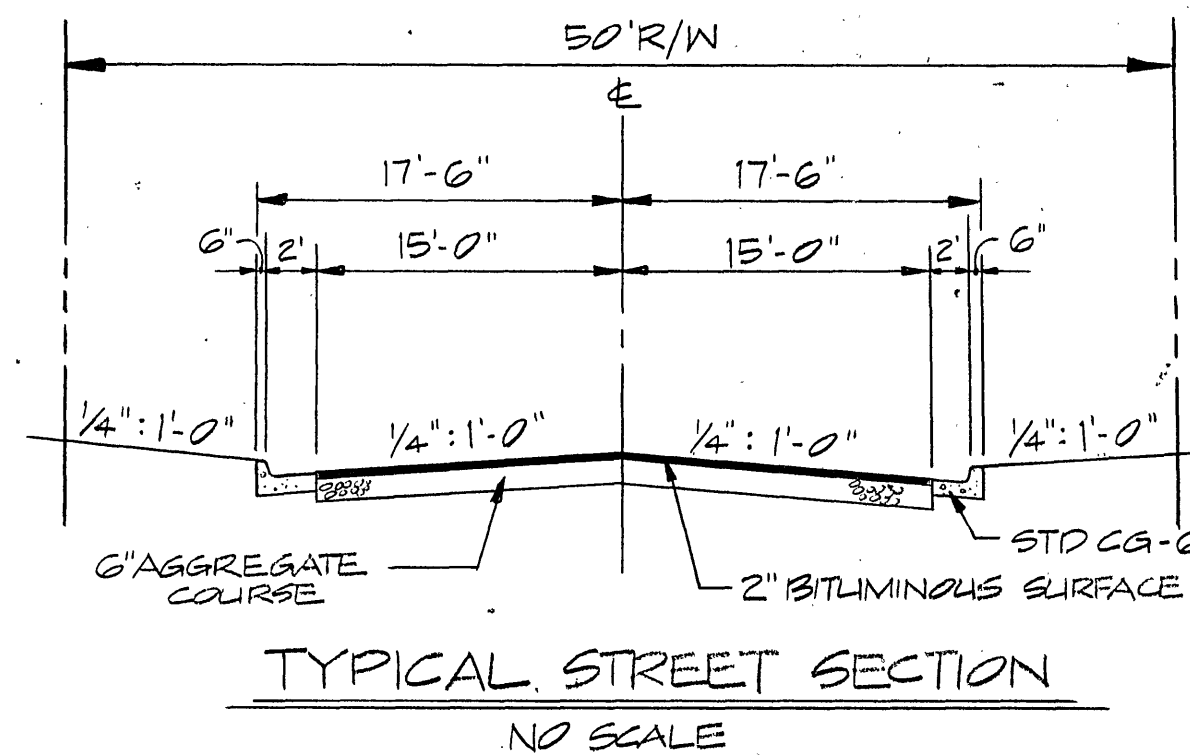

AS BUILT

DEVELOPMENT PLAN

FOR
PROPERTY OF

R. H. PATRICK

SITUATED ALONG U. S. ROUTE #460 EAST
ROANOKE, VIRGINIA

SCALE: 1" = 40'

DATE: 15 APR 1977

BUFORD T. LUMSDEN & ASSOCIATES, P.C.
CERTIFIED LAND SURVEYORS
ROANOKE, VIRGINIA

**460-EAST
(NEXT TO MARKET SQUARE)**
SHEET 1

Document: 10122107
COMM. # 77-295