

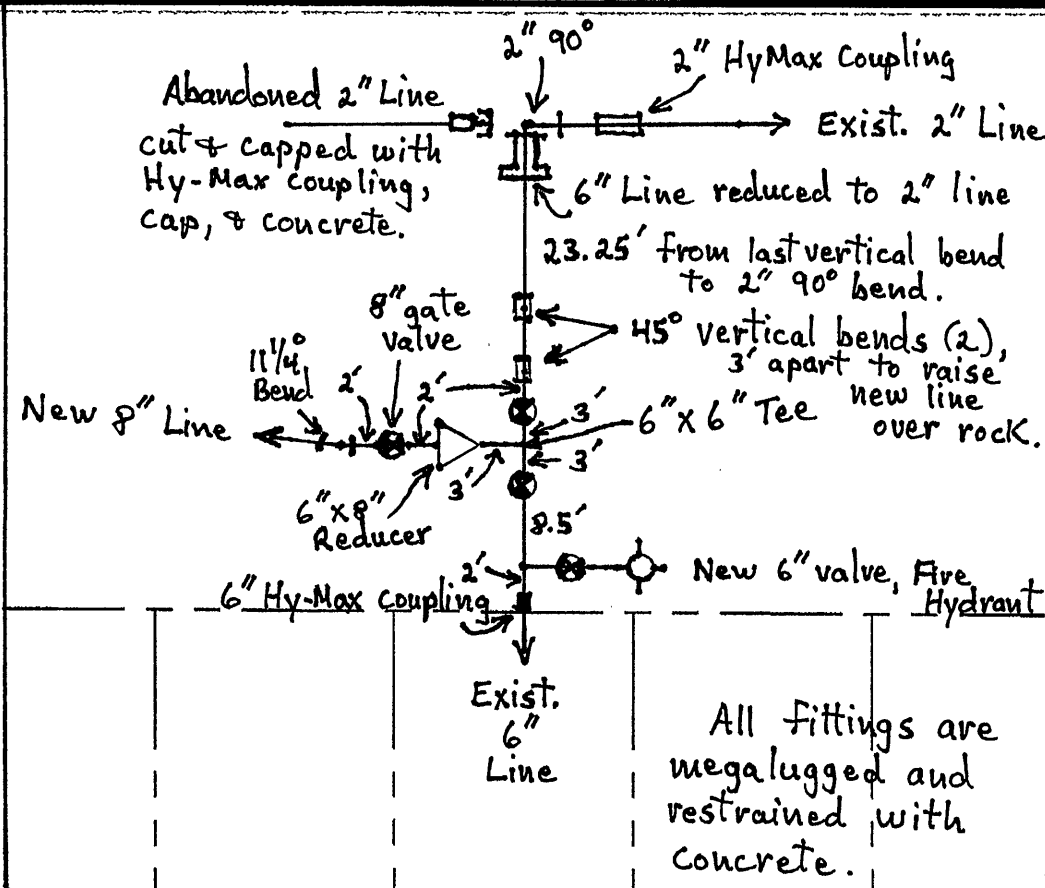
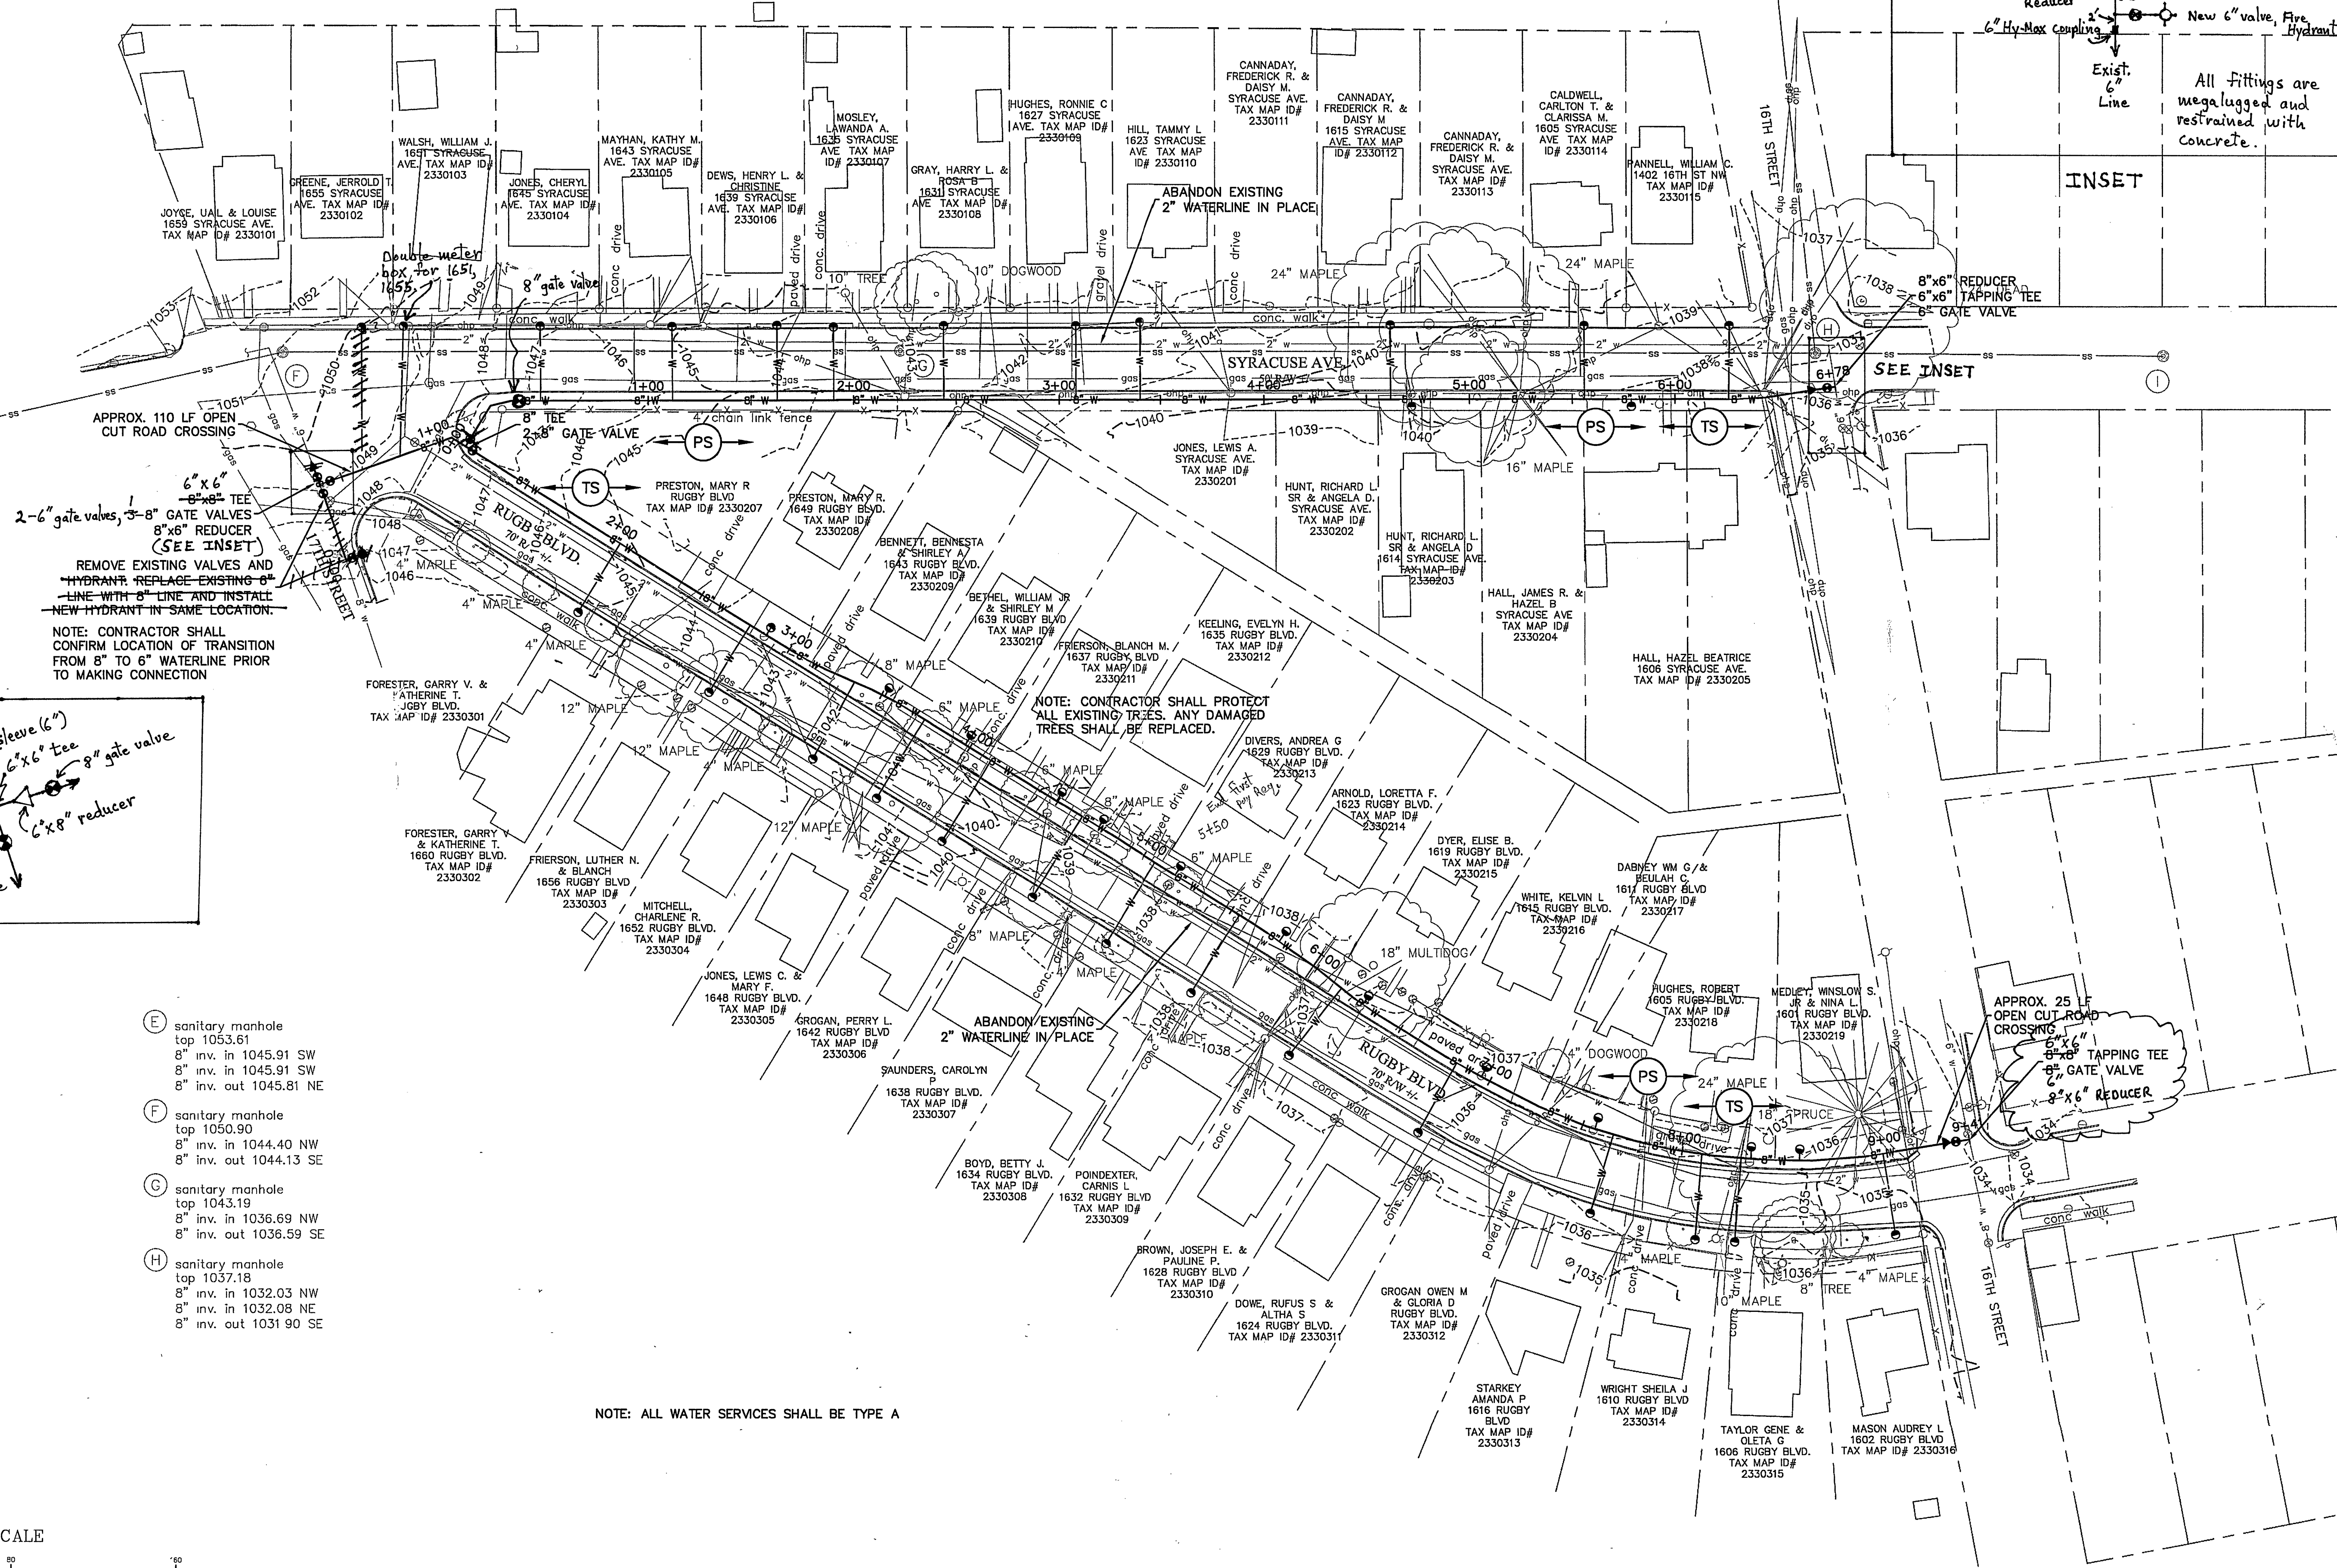


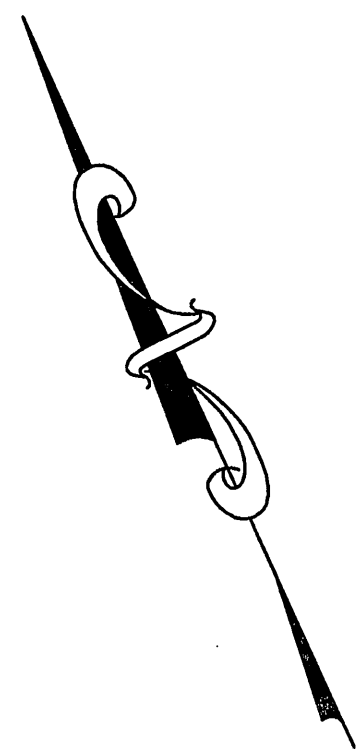

INSET

SEE INSET



INSET:

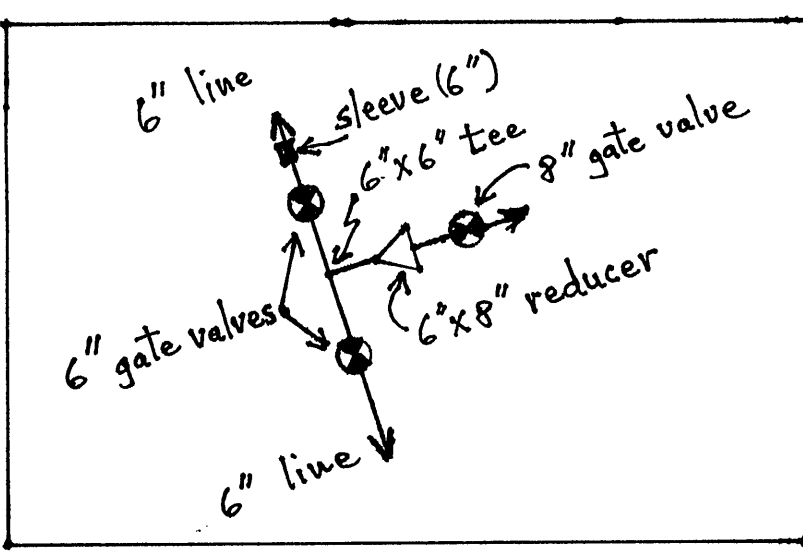

- (E) sanitary manhole
top 1053.61
8" inv. in 1045.91 SW
8" inv. in 1045.91 NW
8" inv. out 1045.81 NE
- (F) sanitary manhole
top 1050.90
8" inv. in 1044.40 NW
8" inv. out 1044.13 SE
- (G) sanitary manhole
top 1043.19
8" inv. in 1036.69 NW
8" inv. out 1036.59 SE
- (H) sanitary manhole
top 1037.18
8" inv. in 1032.03 NW
8" inv. in 1032.08 NE
8" inv. out 1031.90 SE

NOTE: ALL WATER SERVICES SHALL BE TYPE A

GRAPHIC SCALE

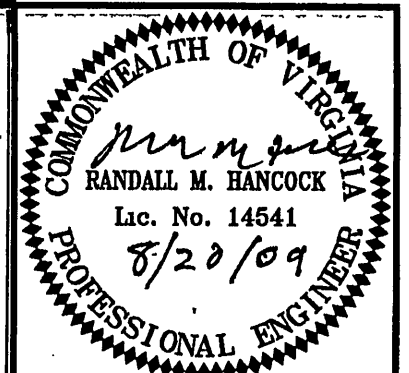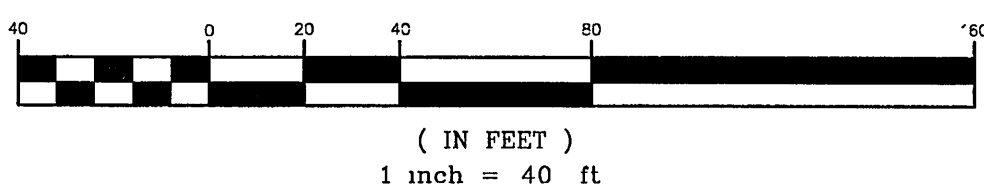

Draper Aden Associates
Engineering • Surveying • Environmental Services
Blacksburg, VA
2206 South Main Street
24060
540-552-0444 Fax: 540-552-0291
www.daa.com



PLAN
RUGBY BOULEVARD WATERLINE
REPLACEMENTS
CITY OF ROANOKE, VIRGINIA

REVISIONS
AUGUST 12, 2009
PER WVWA COMMENT
AUGUST 20, 2009
PER CITY OF ROANOKE

APPROVED
OCT 15 2009

DESIGNED BY RMH
DRAWN BY SAK
CHECKED BY TOM
SCALE 1" = 40'
DATE JULY 29, 2009
PROJECT NUMBER B09134B-02
U-1

As-Built 5.10.10 K. Winslow