




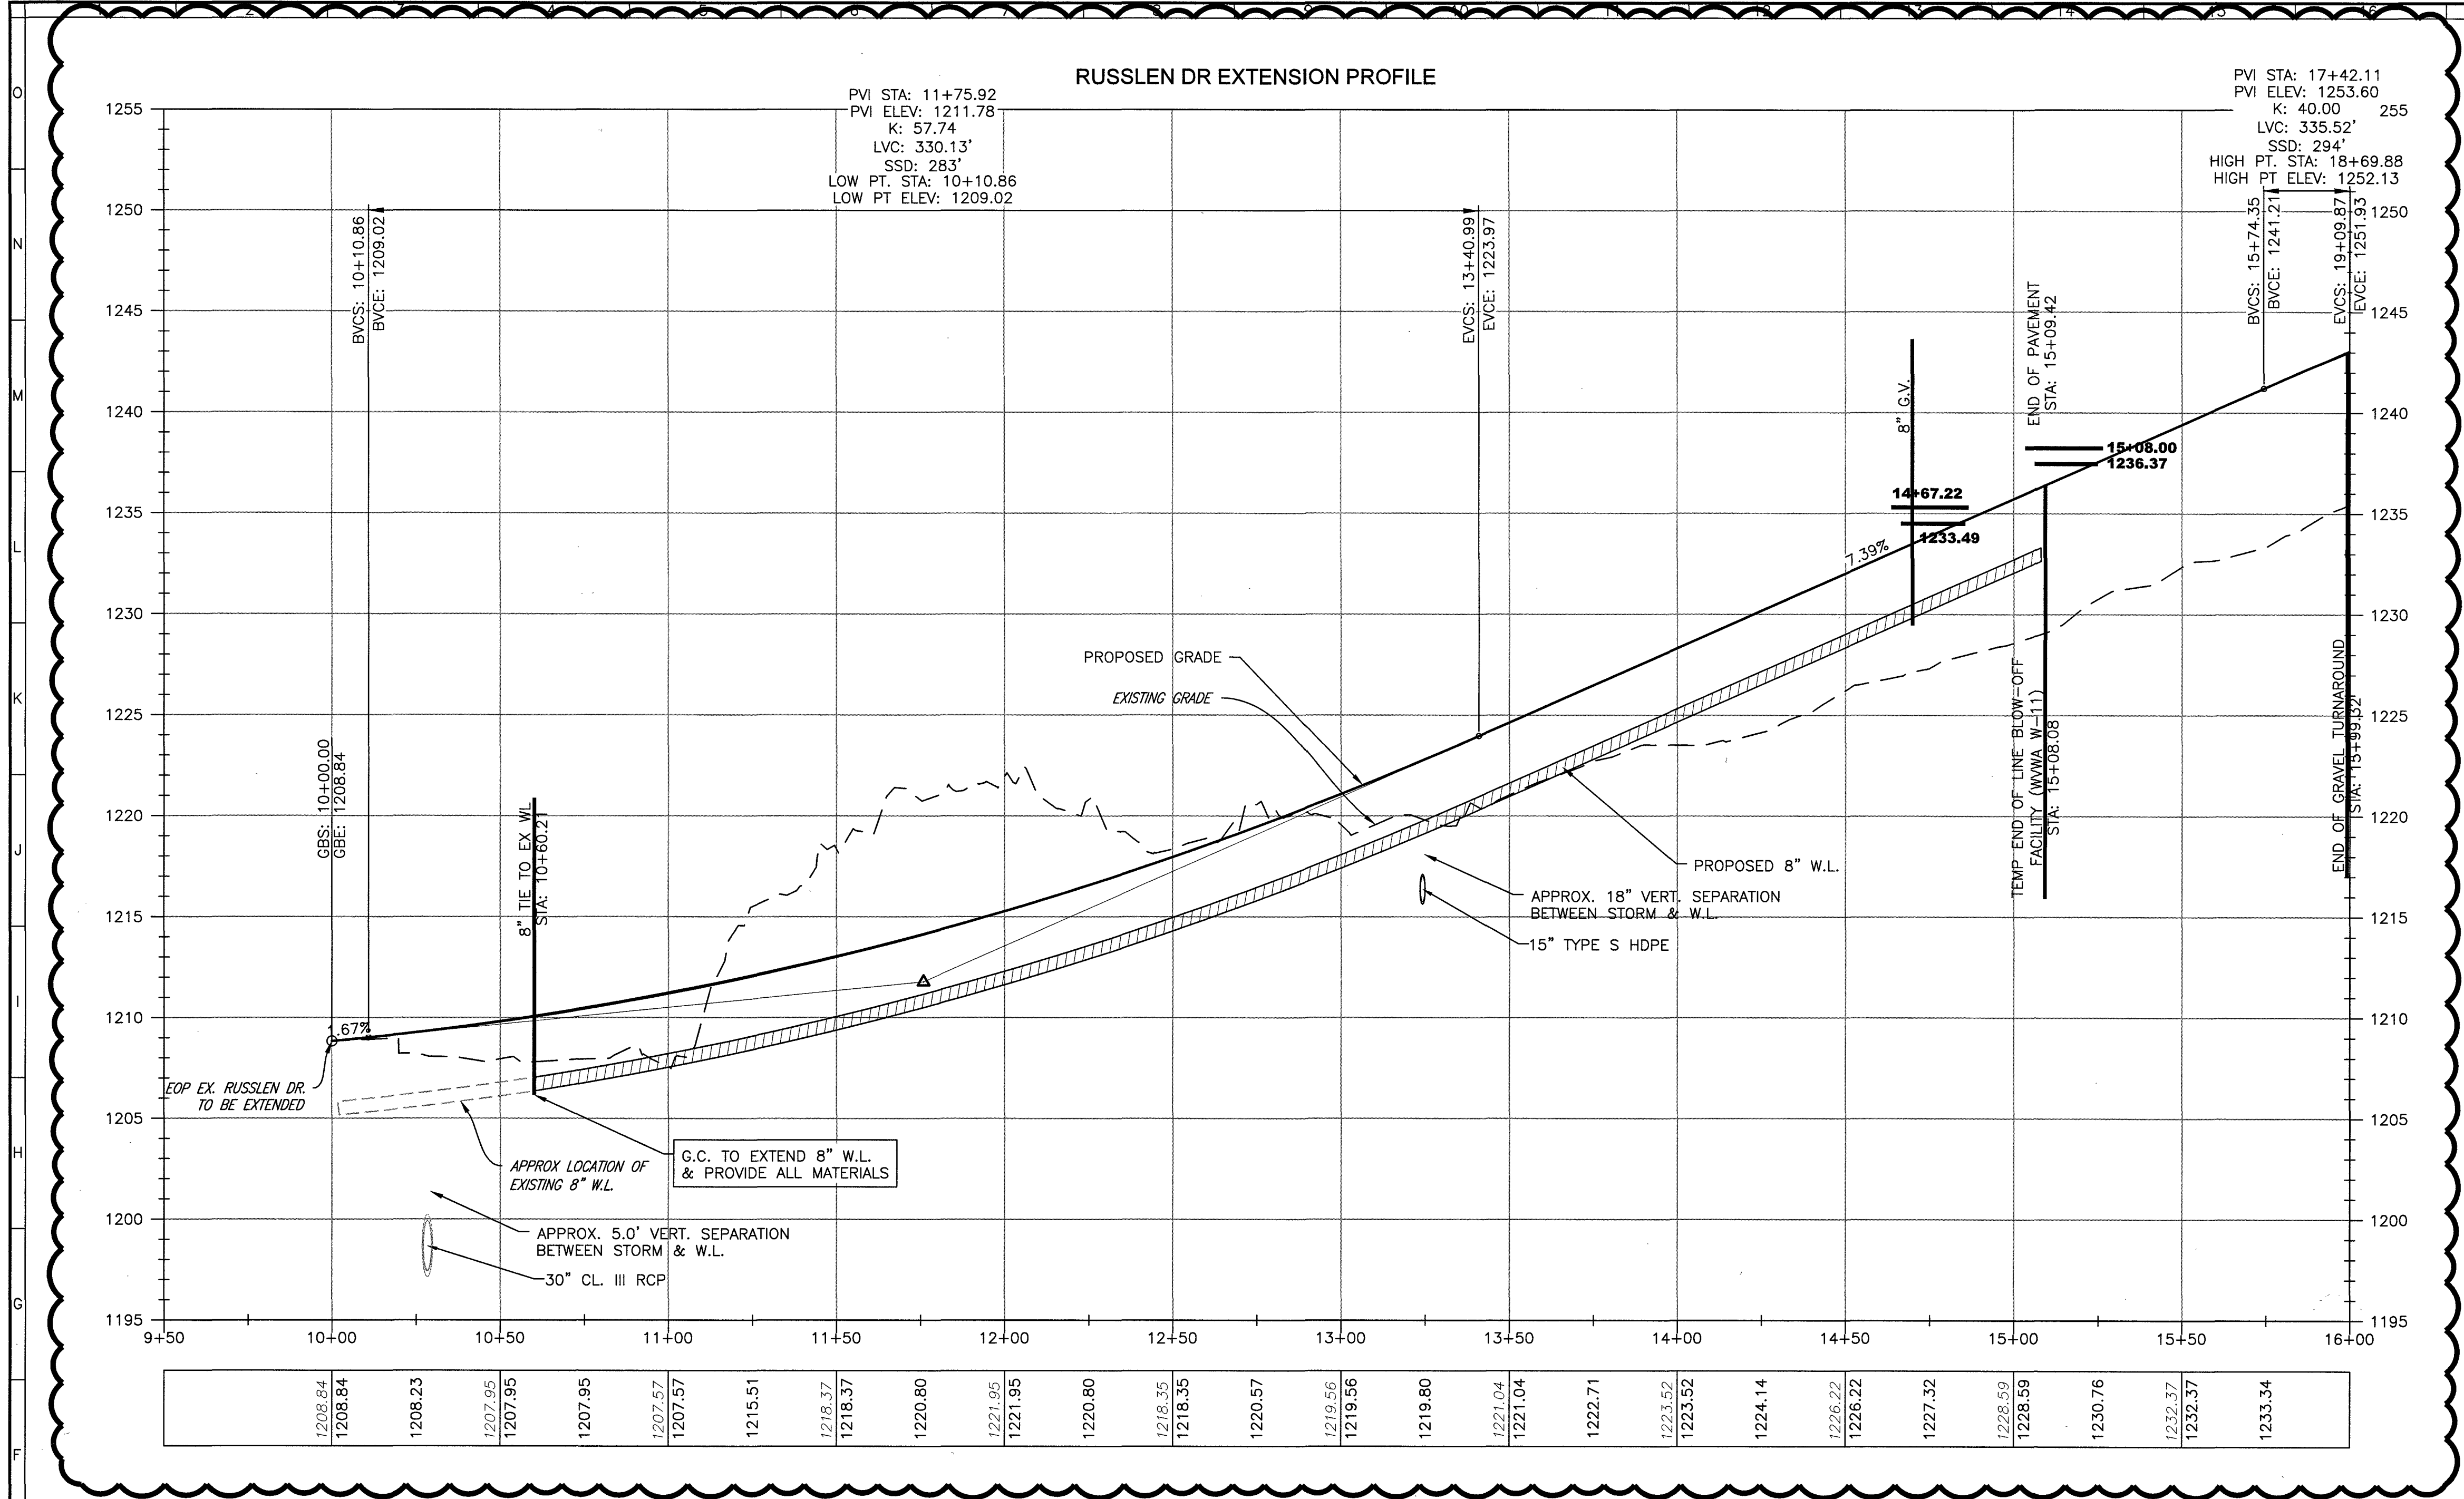

AS-BUILT DRAWING NOTE:
AS-BUILT DRAWING FOR SANITARY SEWER AND WATERLINE IMPROVEMENTS ARE FOR AS-BUILT PURPOSES ONLY. NO IMPROVEMENTS OTHER THAN WATER AND SANITARY SEWER STRUCTURES WERE AS-BUILT OR INDICATED AS SUCH ON THE SUBJECT PLAN SET. UNDERGROUND PIPING WAS NOT LOCATED. LOCATION SHOWN IS APPROXIMATE BASED ON SURFACE FEATURES AND INFORMATION PROVIDED BY CONTRACTOR.

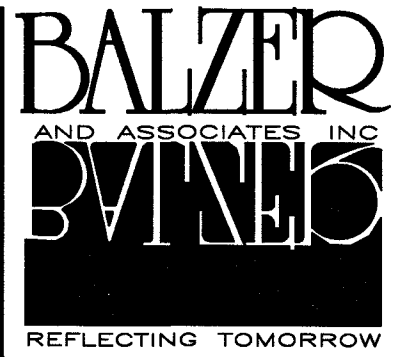

Balzer and Associates, Inc.
1208 Corporate Circle
Roanoke, VA 24018
540-772-9580
FAX 540-772-8050

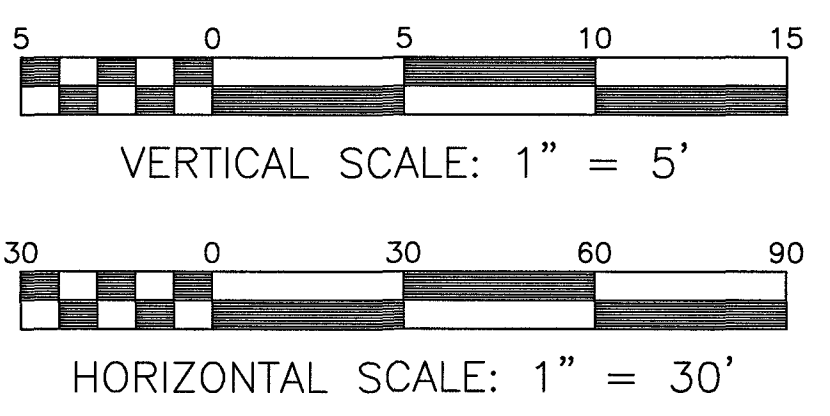

FOXFIELD - SECTION 7
RUSSELEN DRIVE
WATERLINE AS-BUILT PROFILE
CATAWBA DISTRICT
ROANOKE COUNTY, VIRGINIA

DRAWN BY KRO
DESIGNED BY CPB
CHECKED BY CPB
DATE 5/8/2020
SCALE AS NOTED
REVISIONS: