



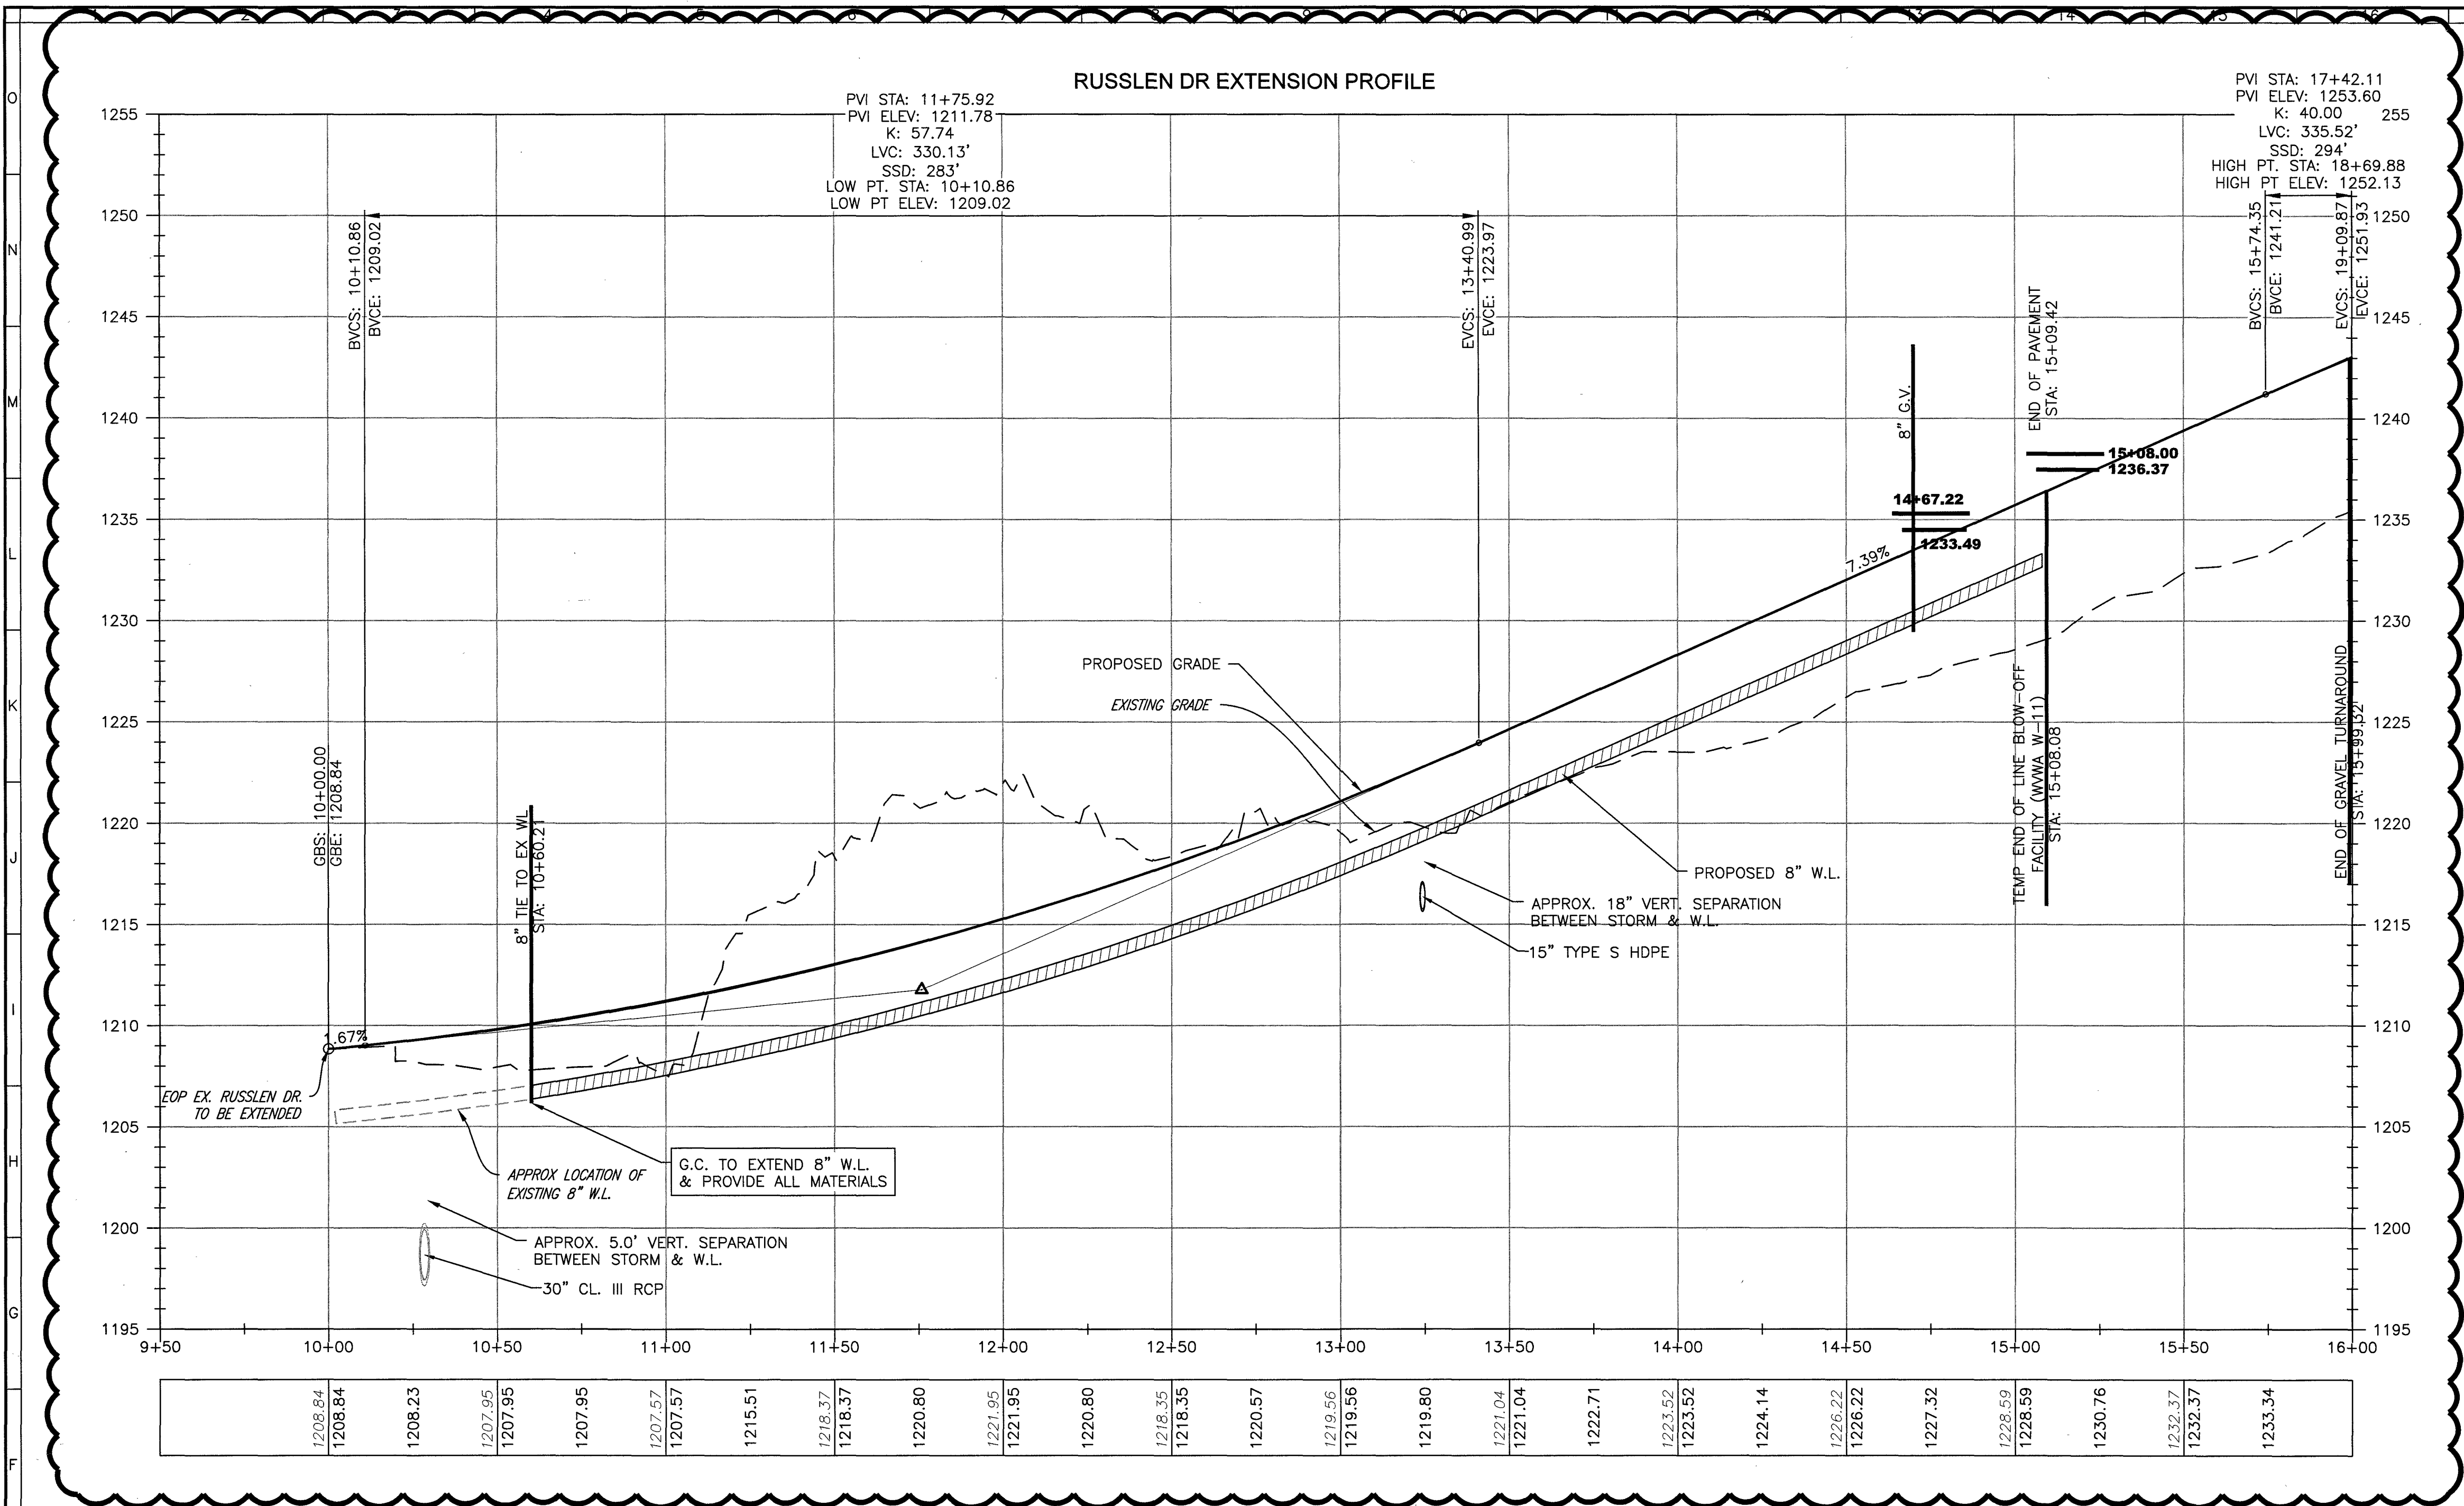

AS-BUILT DRAWING NOTE:
 AS-BUILT DRAWING FOR SANITARY SEWER AND WATERLINE IMPROVEMENTS ARE FOR AS-BUILT PURPOSES ONLY. NO IMPROVEMENTS OTHER THAN WATER AND SANITARY SEWER STRUCTURES WERE AS-BUILT OR INDICATED AS SUCH ON THE SUBJECT PLAN SET. UNDERGROUND PIPING WAS NOT LOCATED. LOCATION SHOWN IS APPROXIMATE BASED ON SURFACE FEATURES AND INFORMATION PROVIDED BY CONTRACTOR.

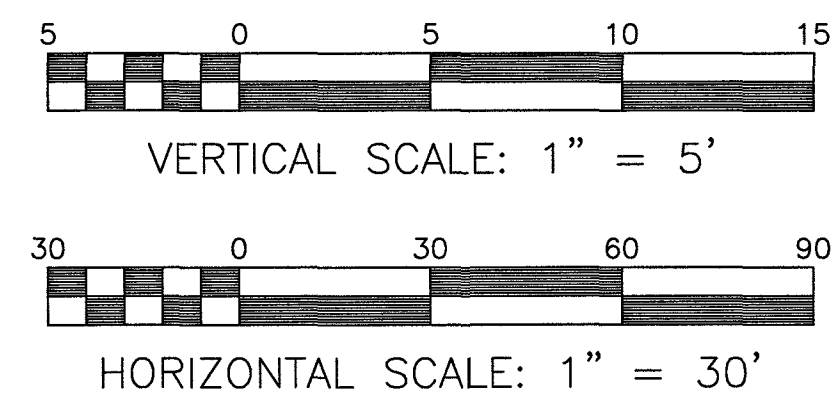


www.balzer.cc

Roanoke
 New River Valley
 Richmond
 Staunton
 Harrisonburg

RESIDENTIAL LAND DEVELOPMENT ENGINEERING
 SITE DEVELOPMENT ENGINEERING
 LAND USE PLANNING & ZONING
 LANDSCAPE ARCHITECTURE
 LAND SURVEYING
 ARCHITECTURE
 STRUCTURAL ENGINEERING
 TRANSPORTATION ENGINEERING
 ENVIRONMENTAL & SOIL SCIENCE
 WETLAND DELINEATIONS & STREAM EVALUATIONS

Balzer and Associates, Inc.

1208 Corporate Circle
 Roanoke, VA 24018
 540-772-9580
 FAX 540-772-8050

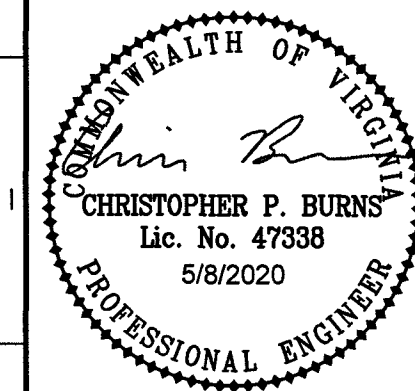

FOXFIELD - SECTION 7
 RUSSLEN DRIVE
WATERLINE AS-BUILT PROFILE
 CATAWBA DISTRICT
 ROANOKE COUNTY, VIRGINIA

DRAWN BY KRO
 DESIGNED BY CPB
 CHECKED BY CPB
 DATE 5/8/2020
 SCALE AS NOTED
 REVISIONS:

SHEET NO.

C6A

JOB NO. 04180072.00