
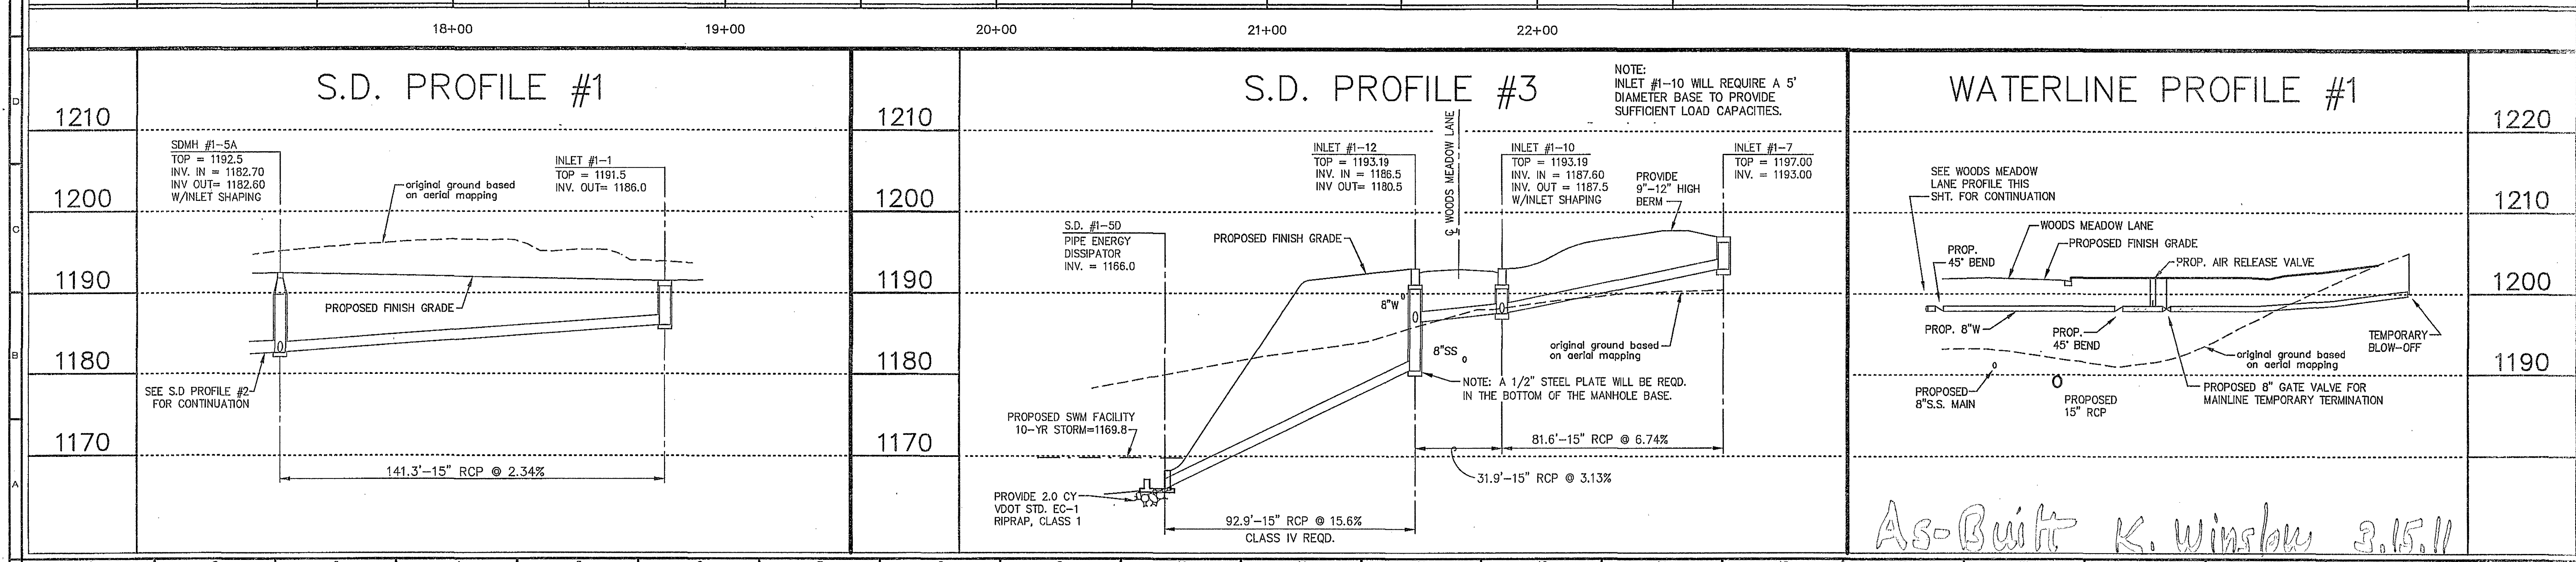


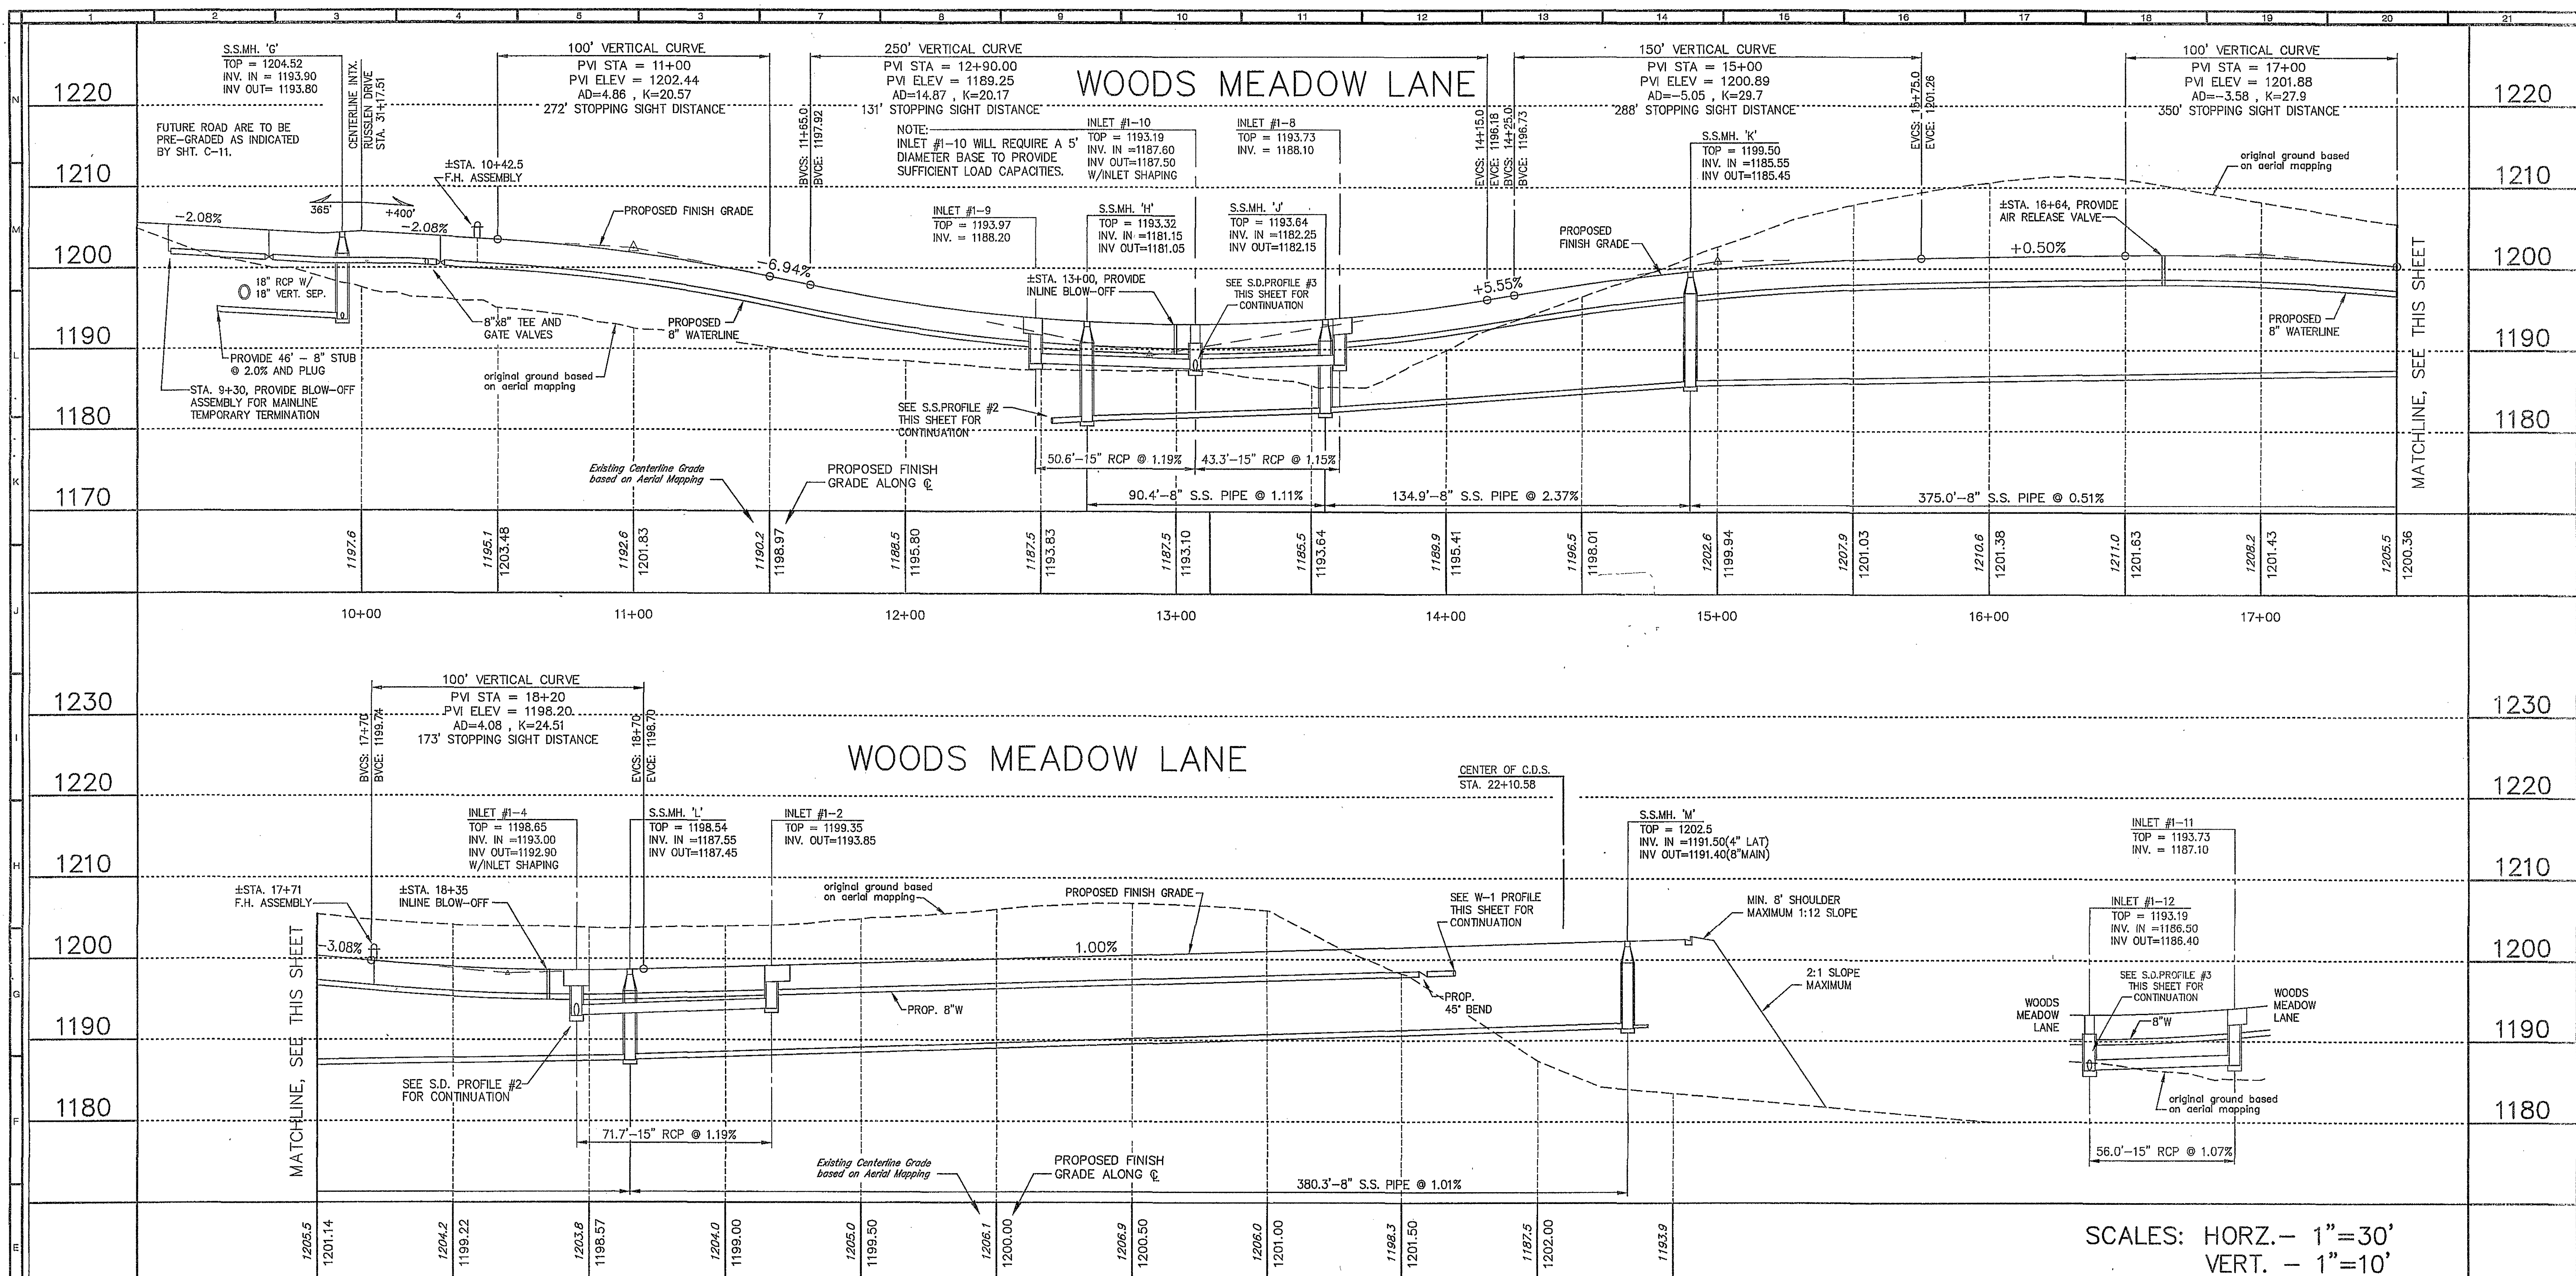

COMMONWEALTH OF VIRGINIA
Professional Engineer
ROGER L. STURILL
No. 033058

BALZER AND ASSOCIATES, INC.
REFLECTING TOMORROW
www.balzer.cc
PLANNERS • ARCHITECTS
ENGINEERS • SURVEYORS

1208 Corporate Circle
Roanoke, Virginia 24018
Phone: 540/772-8880
FAX: 540/772-8889

501 Branchway Road
Richmond, Virginia 23268
Phone: 804/784-0571
FAX: 804/784-2835

590 Technology Park Drive
Suite 200
Glenn Allen, Virginia 23060
Phone: 804/683-0132
FAX: 804/683-0133

102 Hubbard Street
Buckhams, Virginia 24060
Phone: 540/861-0281
FAX: 540/861-0282

1657 Commerce Road
Suite 201
Verona, Virginia 24482
Phone: 540/548-3220
FAX: 540/548-3221

**WOODS HILL, SEC. 1
FOXFIELD, SEC. 5
AT RUSSLEN FARMS
ROAD AND UTILITY PROFILES
ROANOKE COUNTY, VIRGINIA**

DRAWN BY: JVV
DESIGNED BY: JVV
CHECKED BY: SMH
DATE: 10/31/06

REVISIONS:
01/23/06 PER VDOT & RKE CO. 1ST REVIEW
05/25/06 PER VDOT & RKE CO. 2ND REVIEW
08/14/06 PER VDOT & RKE CO. 3RD REVIEW

SCALE: AS NOTED

SHEET NO.
C-11
JOB NO.
R0500271.00

As-Built K. Winslow 3.15.11