




BALZER & ASSOCIATES
PLANNING / ARCHITECTS
ENGINEERS / SURVEYORS
Riverside Highway
New River Valley
Greensboro, NC 27409
www.balzer.co

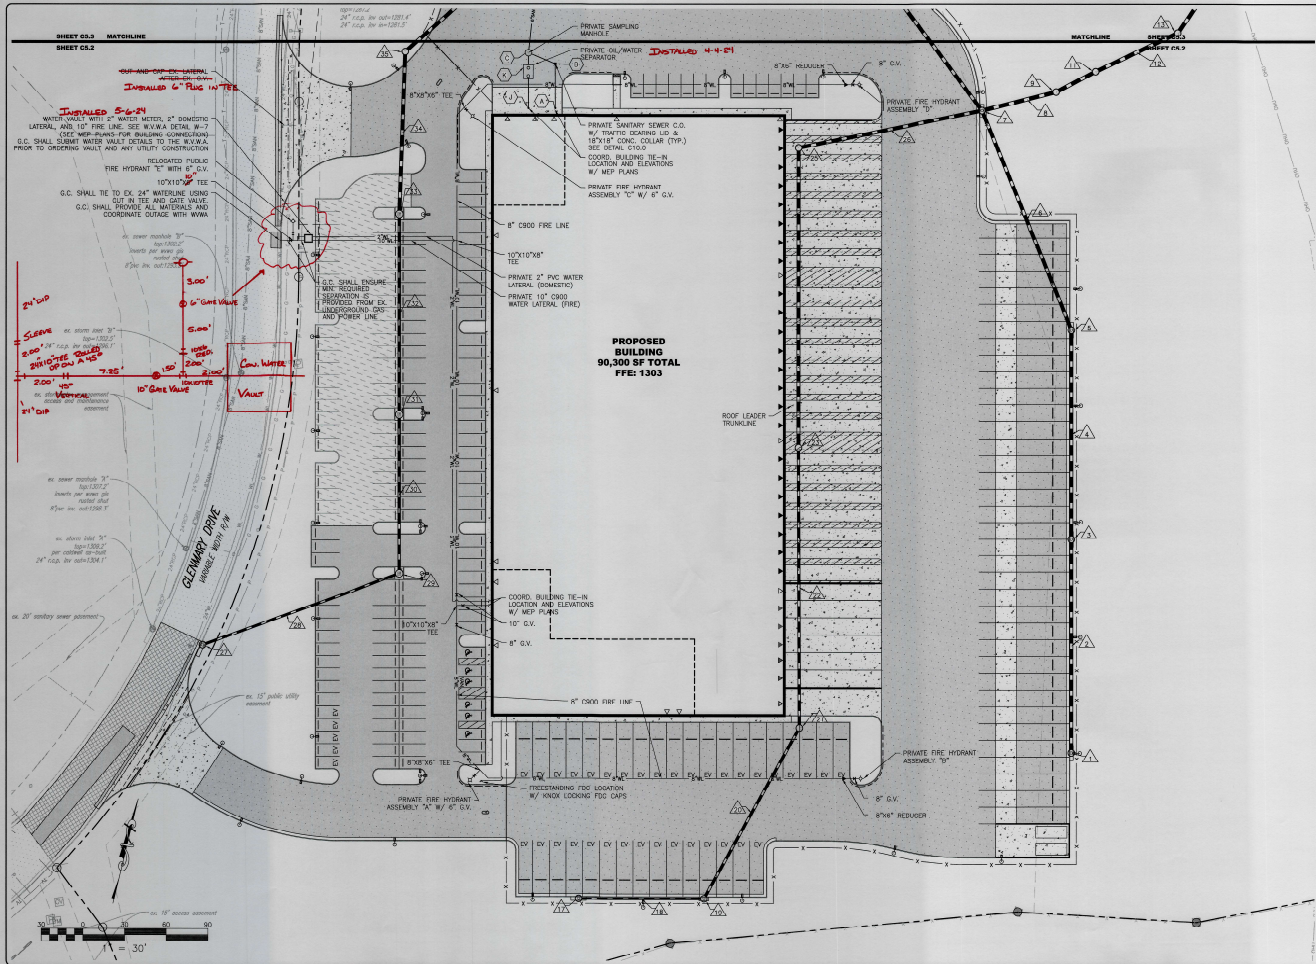

GLENMARTY DRIVE - SUNCAP

UTILITY PLAN I
GLENMARTY DRIVE
SUNCAP DRIVE

DESIGNED BY	AKB
DRAWN BY	AKB
CHECKED BY	BTG
DATE	12/15/2023
SCALE	1" = 30'
REVISIONS	
10/20/24	
10/20/24	
10/20/24	

C5.2
PROJECT NO. 100000001

APPROVED, 2/12/2024